
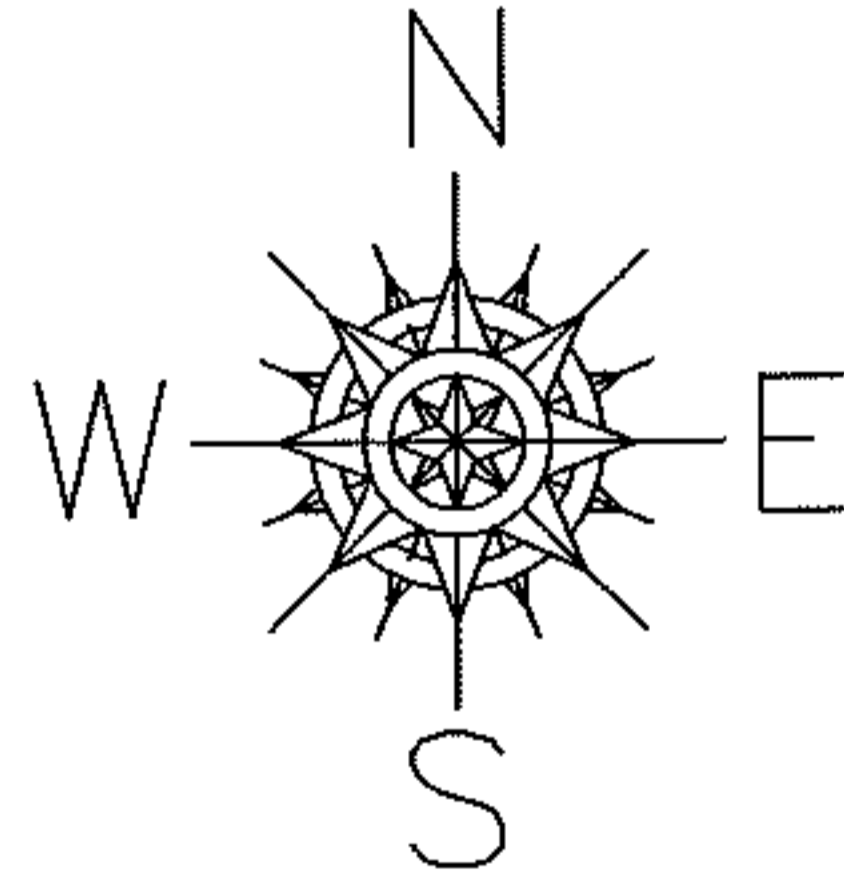


RASTER

PARENT PARCEL: 04-00-028-102-036  
CHILD PARCEL: 04-00-028-102-181 THRU -182  
STARTING POINT: MONUMENT, S.W. CORNER OF SECTION 28

11-00243

JUST IMAGINE DR.

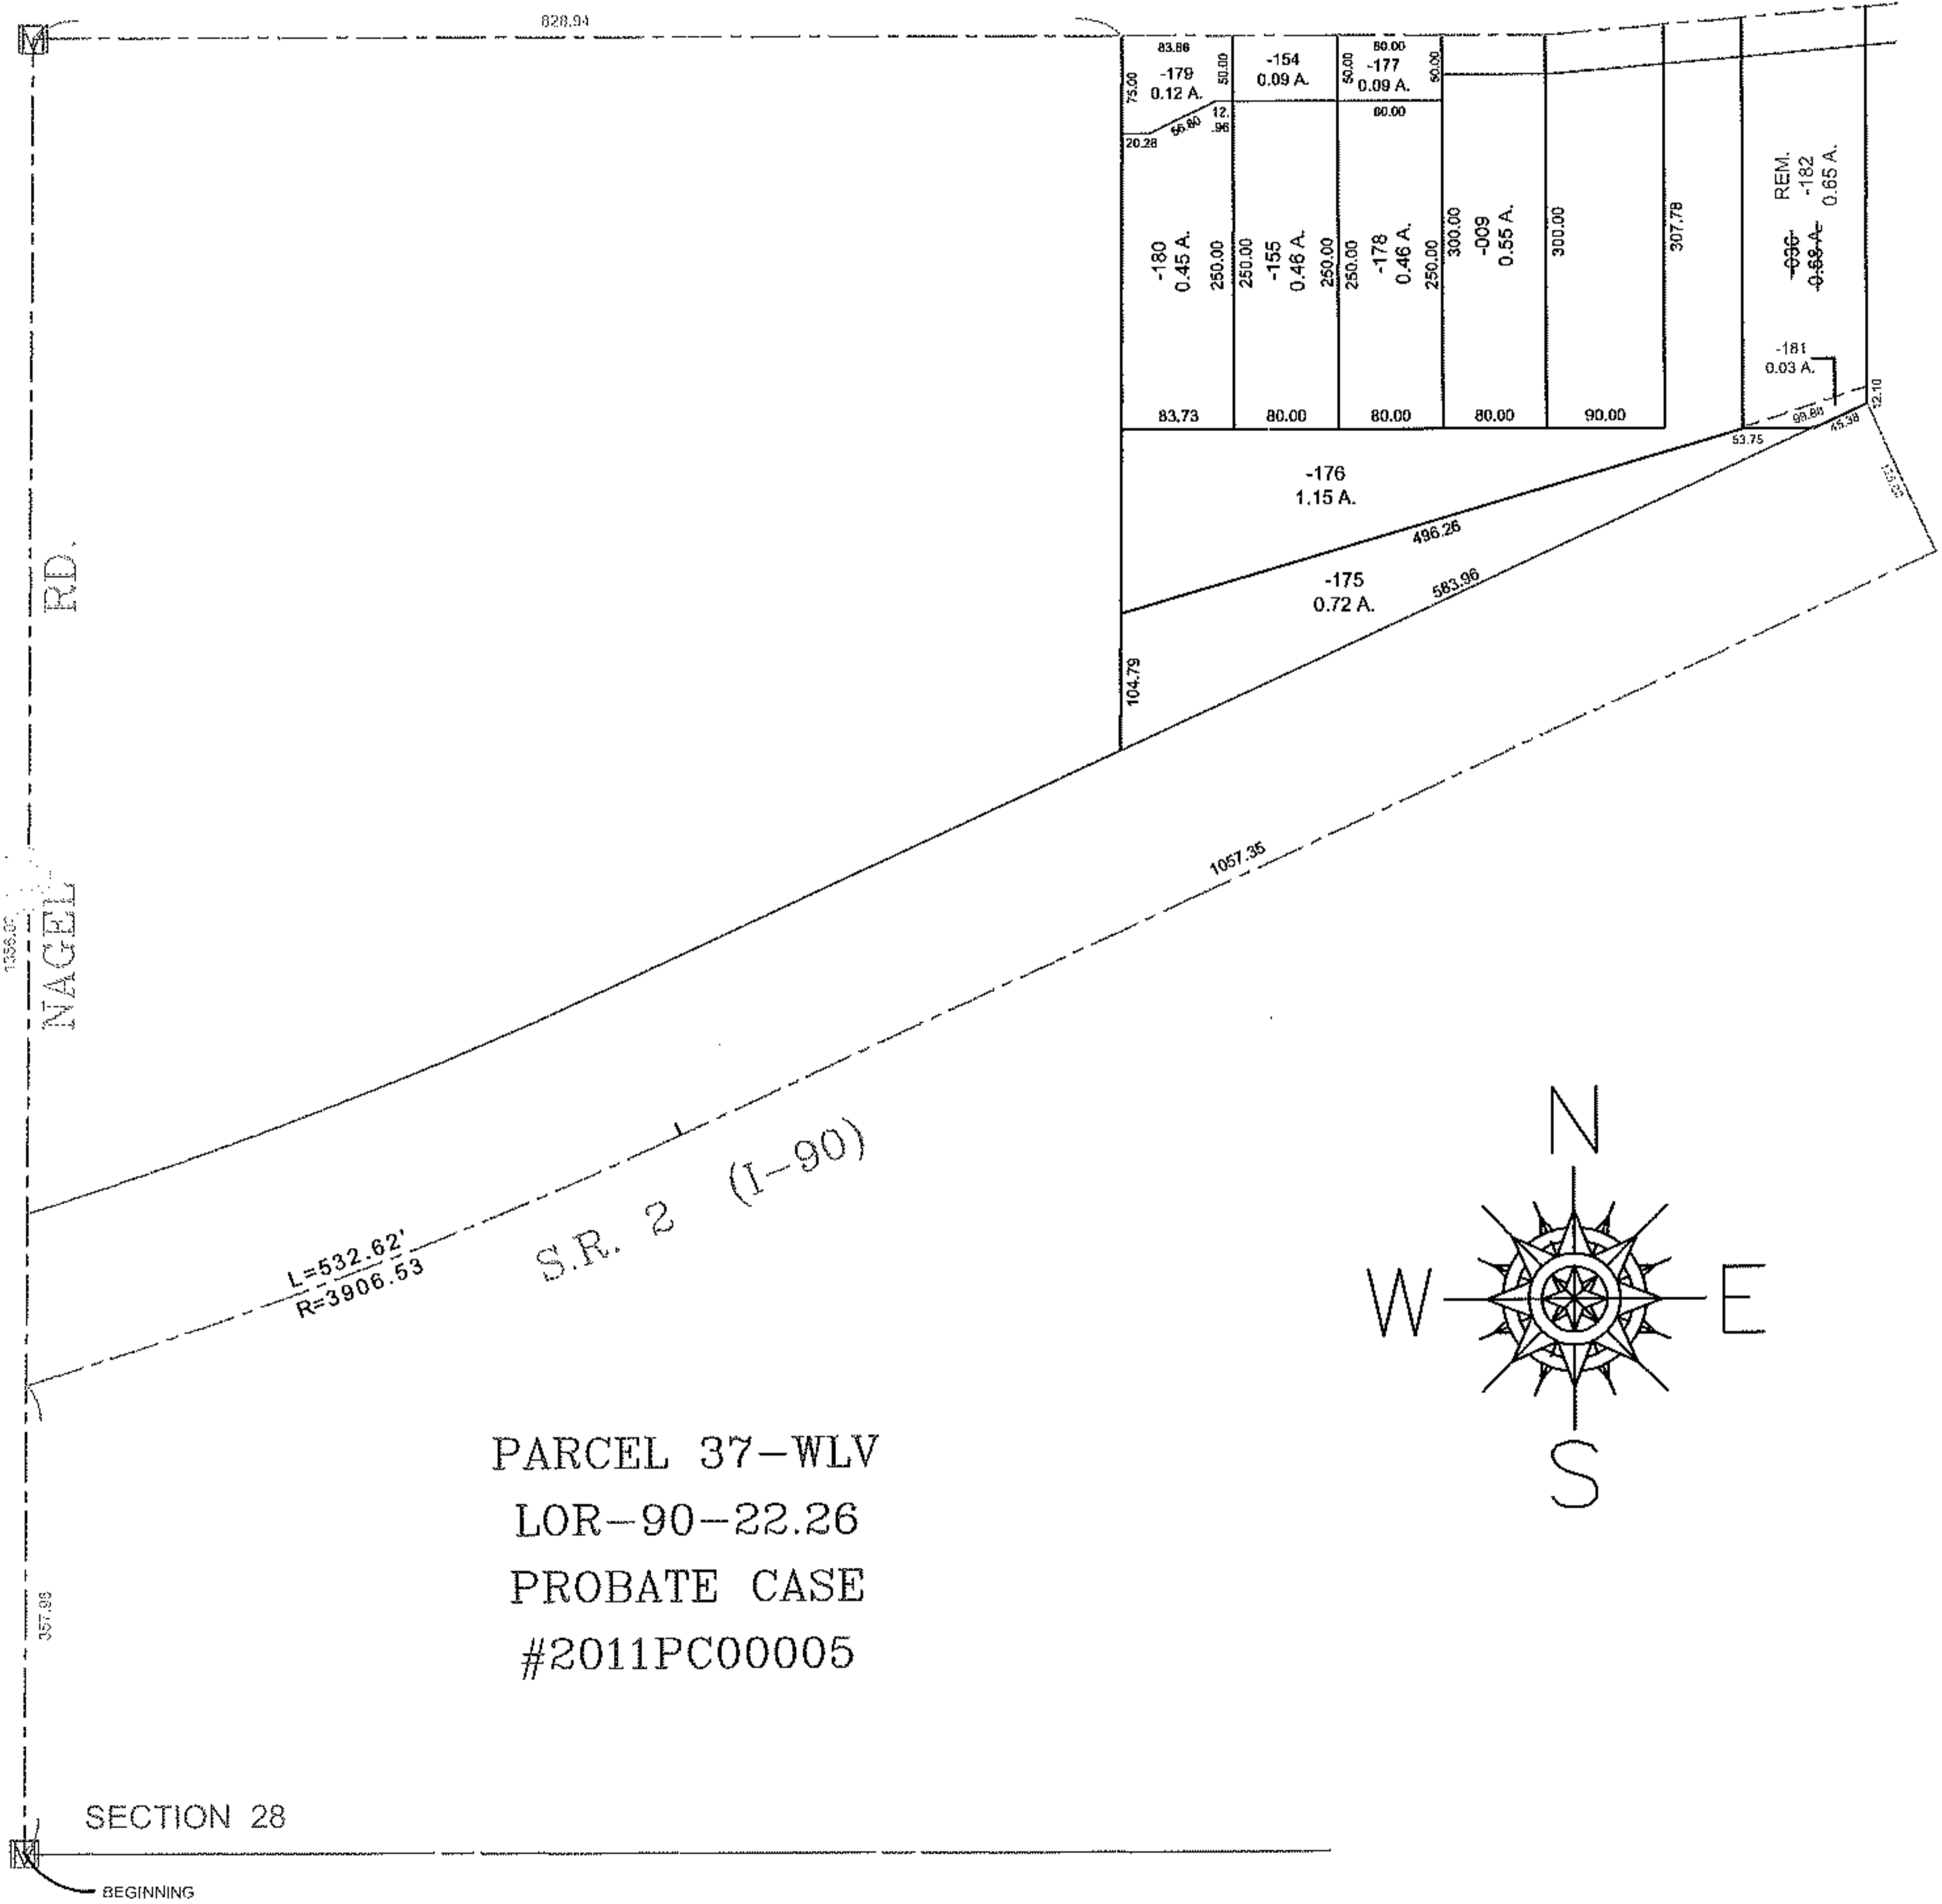

**SPLITS/DEEDS PROCESSED**

LORAIN COUNTY TAX MAP DEPARTMENT  
226 MIDDLE AVE. ELYRIA, OHIO

SURVEYED BY: WILLIAM J. SALA  
CLOSURE: 0.01 : 10,000  
MAP PAGE(S): 04-00-028-E  
APPROVED BY: TJS DATE: 10/15/12  
SCALE: 1" = 200 PRIOR INST.: OR 54/249