
PARENT PARCEL: 11-00-099-000-301

CHILD PARCEL: 11-00-099-900-013 & 11-00-099-000-393

ARTING POINT: S.W. CORNET OF BLOCK "B" IN EMERALD POINT SUB. NO. 1


11-00245

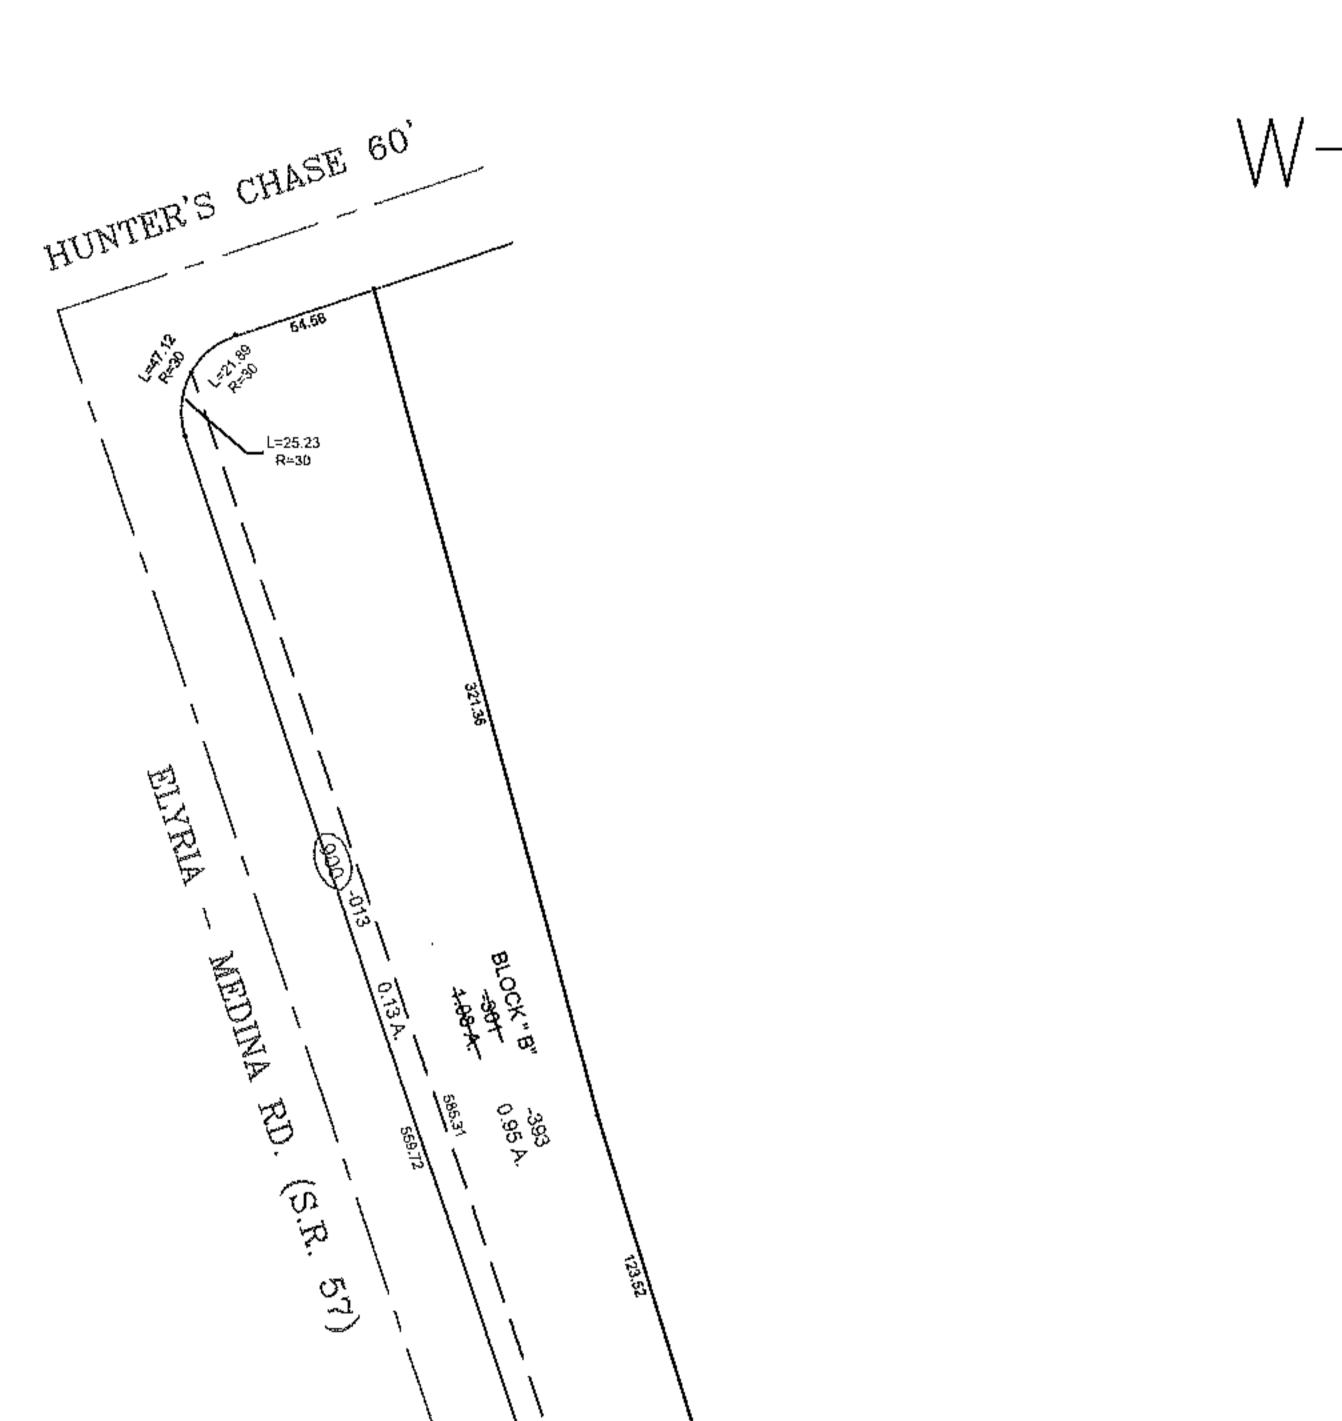

405/04

BEGINNING

125.33

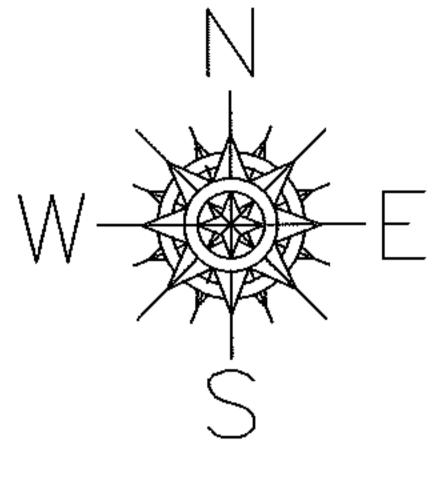

SPLITS/DEEDS PROCESSED

LORAIN COUNTY TAX MAP DEPARTMENT 226 MIDDLE AVE. ELYRIA, OHIO

SURVEYED BY: KENNETH C. DEAN JR.

CLOSURE: 0.01: 10,000

MAP PAGE(S): 11-00-099-B

APPROVED BY: TJS DATE: 12/29/11

SCALE: 1"= 100 PRIOR INSTRUMENT: 20070227934