


10-11-1013
10-78 11 01

#11013

29672
11083
18639

APPROVED
LORAIN CO.
MAP DEPT.
DATE 10-4-77
PAGE 4-00-04C
BY *J. L. M. M. M.*
VOID AFTER 11013

MS
12-8-77

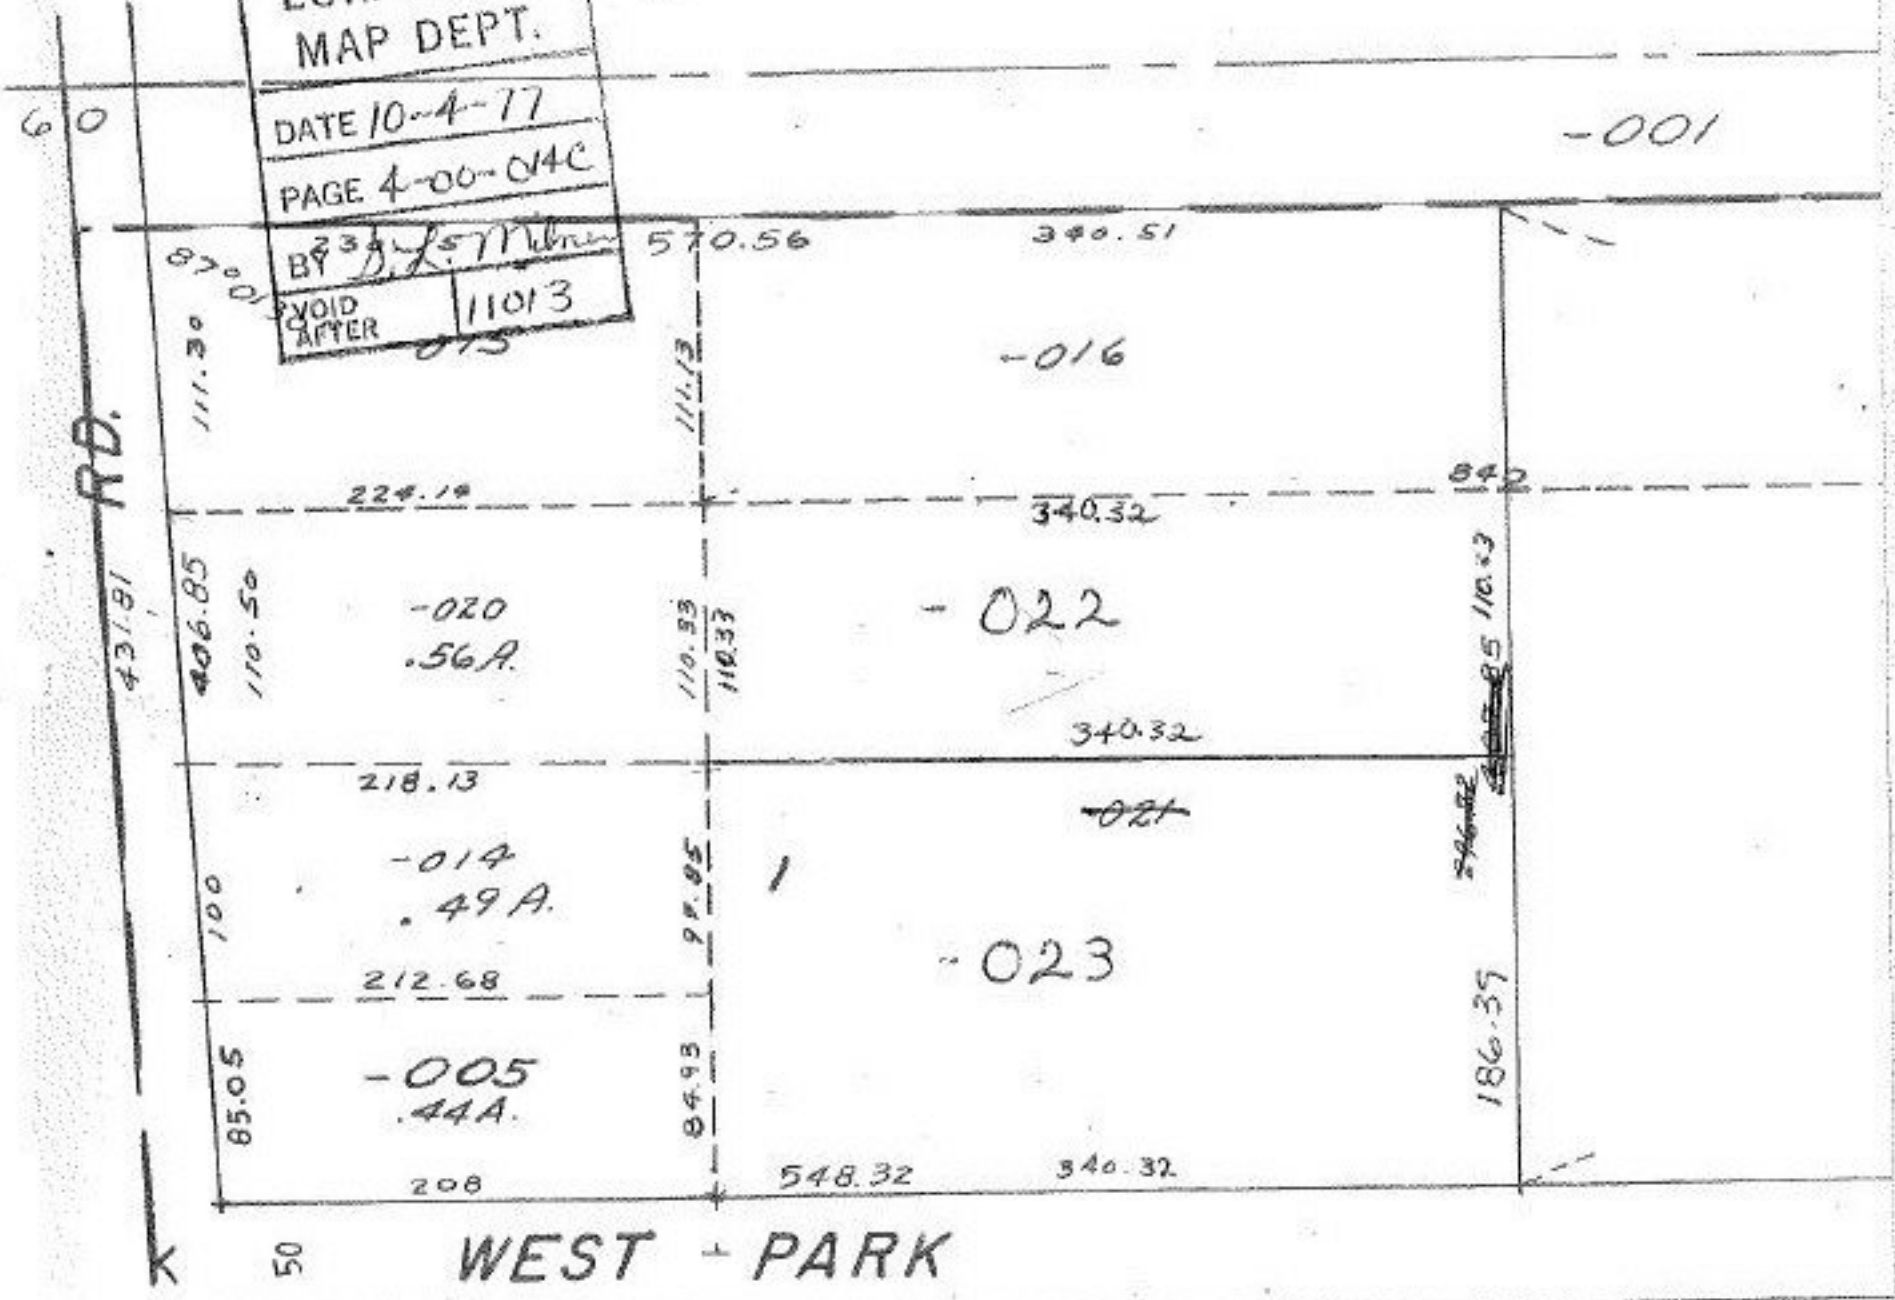

-C
16