

11015

Pt. - 017  
Pt. 15.18 A.

3-27-75

258.39

1081.08

89°40'

#11015

APPROVED  
LORAIN CO.  
MAP DEPT.

DATE 10-5-77

PAGE 12-00-050  
RJB

BY J.L. Milner


VOID AFTER 11015

OCT 12 1977

LORAIN CO.  
MAP DEPT.

Pt. - 018  
Pt. 14.62 A.

JAGUAY

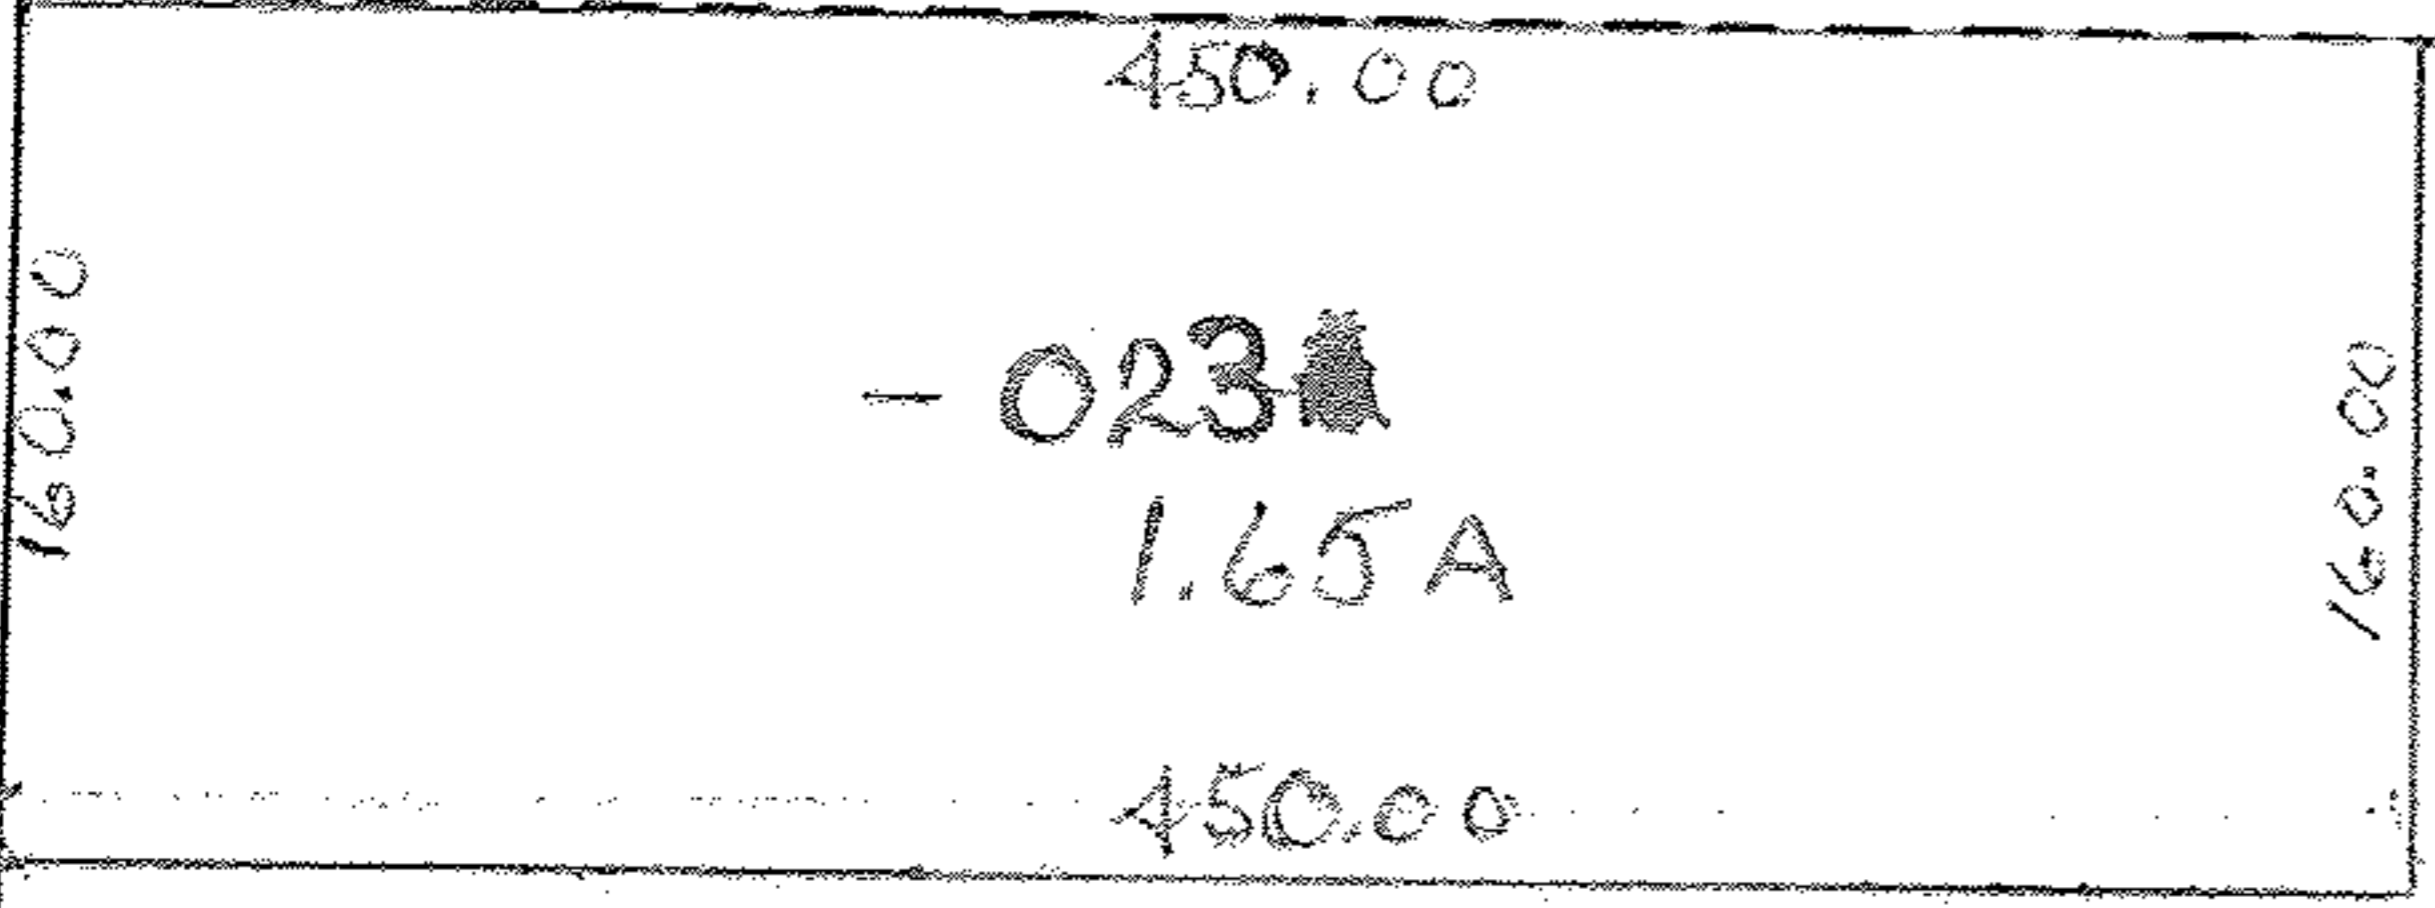

Pt. - 024  
~~Pt. - 019~~  
~~Pt. 12.50 A.~~ Pt. 10.85 A

Change NEXT Page! →

SEE 12-B

COLUMBIA TWP.

SCALE: 1" = 100'

WLY. PT. LOT 6