


11924
190-28

-001
64.00A

19-02-030-000-020

19-02-030-000-020

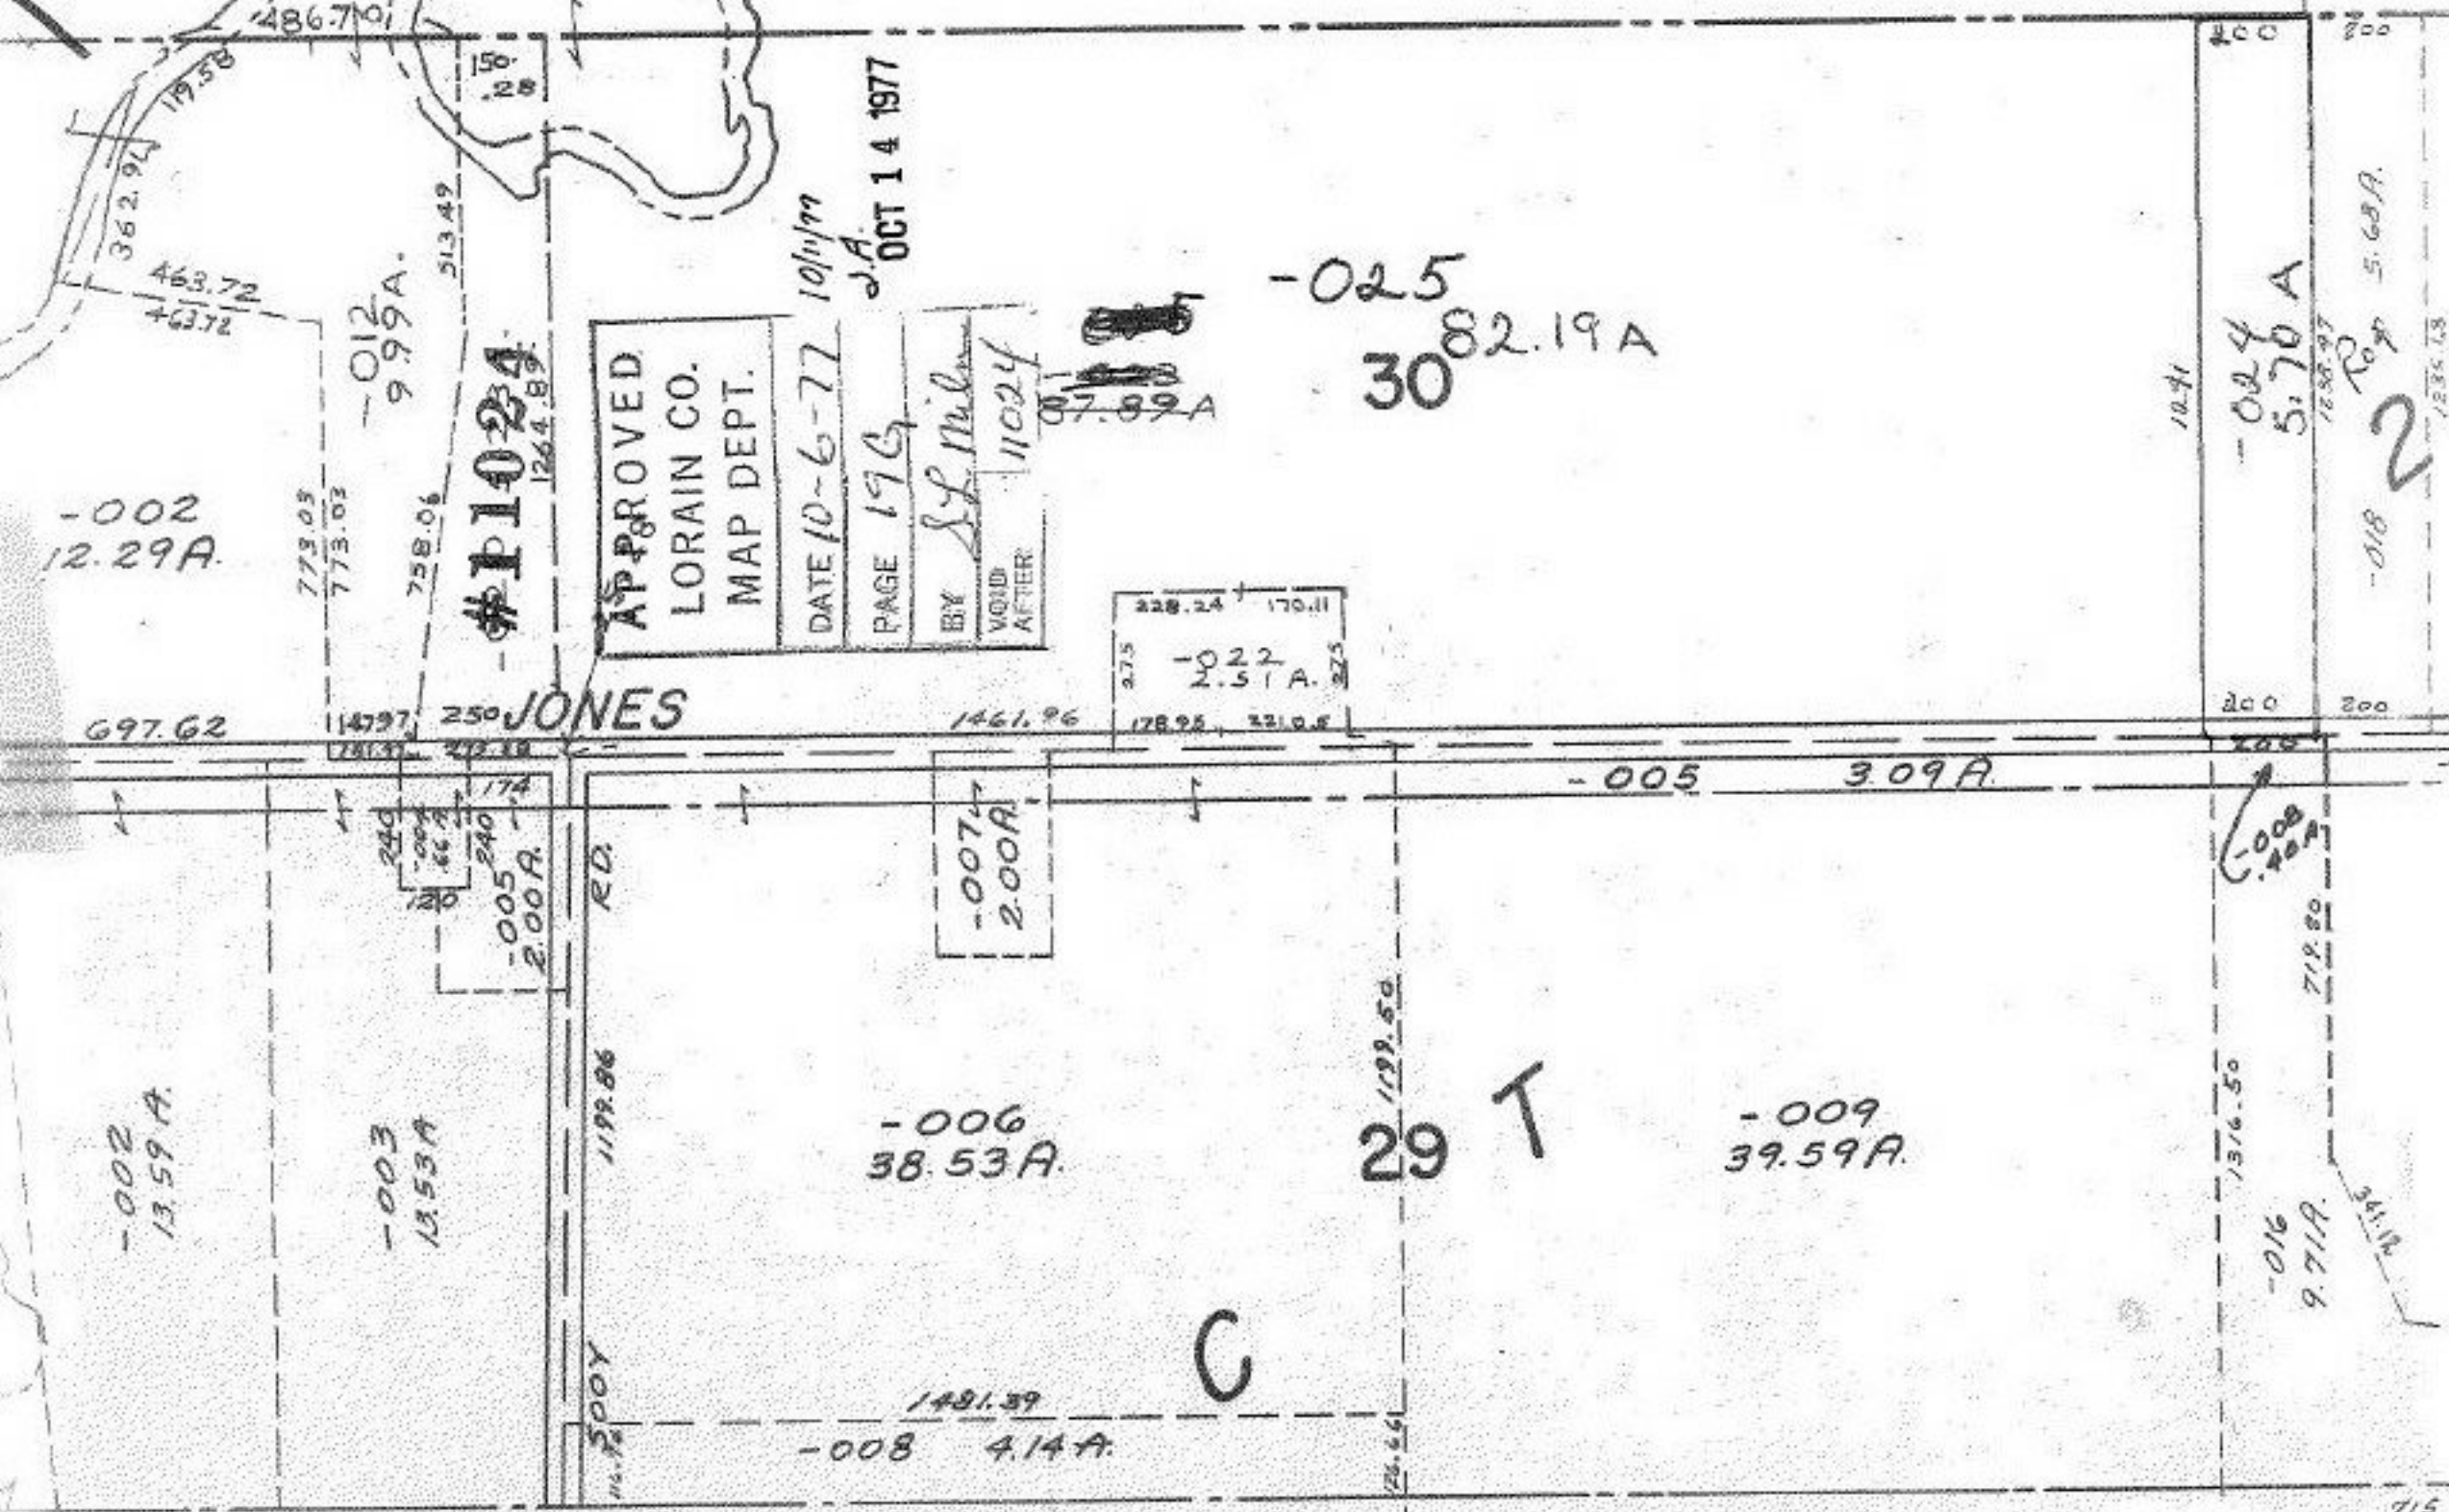

APPROVED
LORAIN CO.
MAP DEPT.

DATE 10-6-77	10/1/77
PAGE 196	J.A.
BY S.F. Miller	
VOID AFTER	11024

228.24	170.11
2.75	-022
178.95	2.51A
221.05	

JONES

RD.

RD.

1491.39

29 T

C

715