

C.7
11-8, 1977

#11026


APPROVED
LORAIN CO.
MAP DEPT.

DATE 10-14-77

PAGE 18-00-028B

BY *J. Robert*

VOID
AFTER

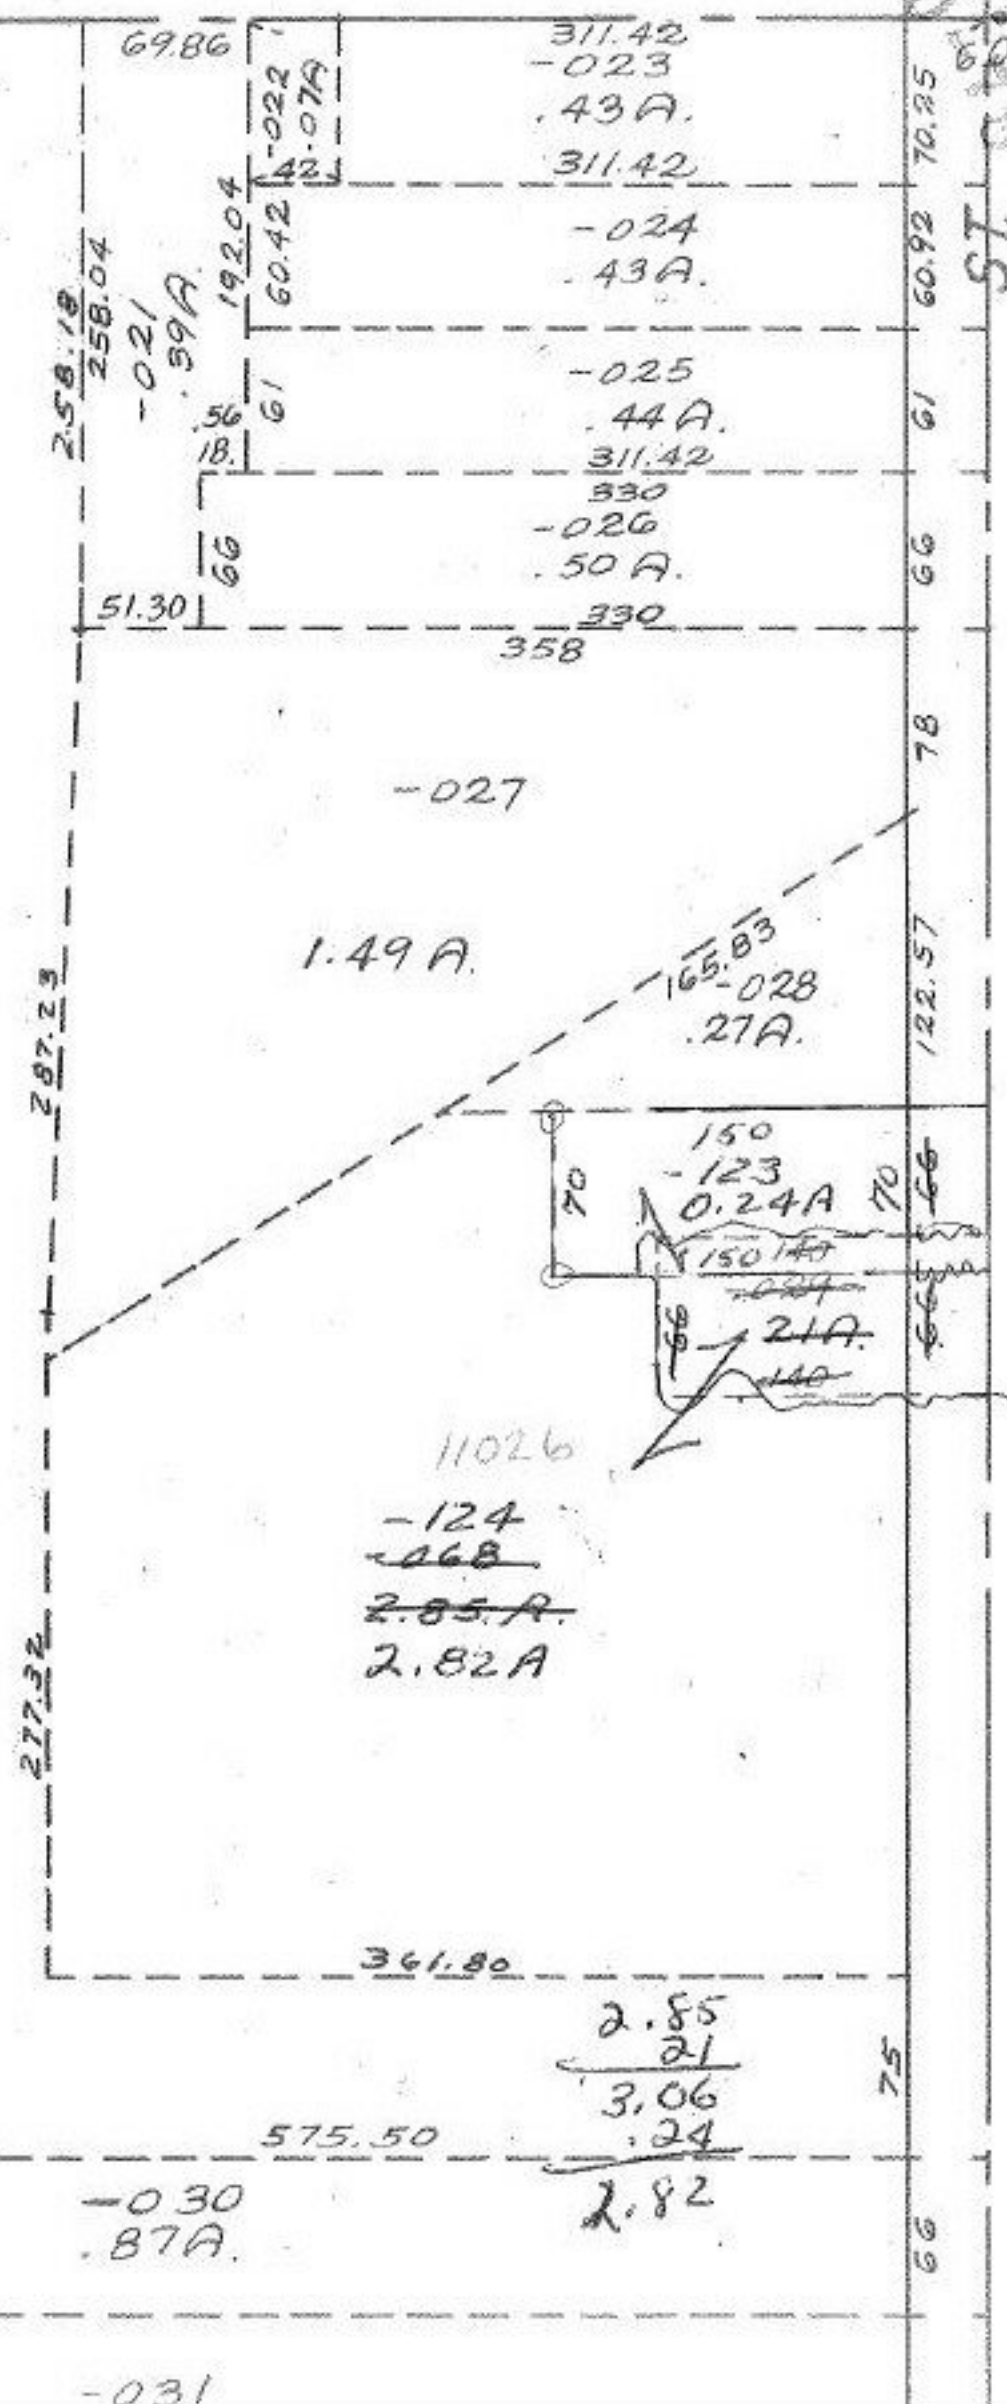

SEE 18-00-021-A