

SEE 5-00-037-A

49-008	83-055
50-009	84-036
51-010	85-037
52-011	86-038
53-012	87-056
54-013	88-041
55-014	89
56-015	90-042
57-016	91-043
58-017	92-059
59-018	93
60-019	94-046
61-020	95-047
62-021	96
63-022	97-048
64-023	98-049
65-054	99
66-026	100-050
67	101-051
	102-052
	103-053
	104-054
	105-055
	106-056
	107-057
	108-058
	109-059
	110-060

109


TAYLOR

BROADWAY

#11032

APPROVED
LORAIN CO.
MAP DEPT.
DATE 10-18-77
PAGE 5-00-037B
BY <i>Smilne</i>
VOID AFTER 11032

120-029
5.00A

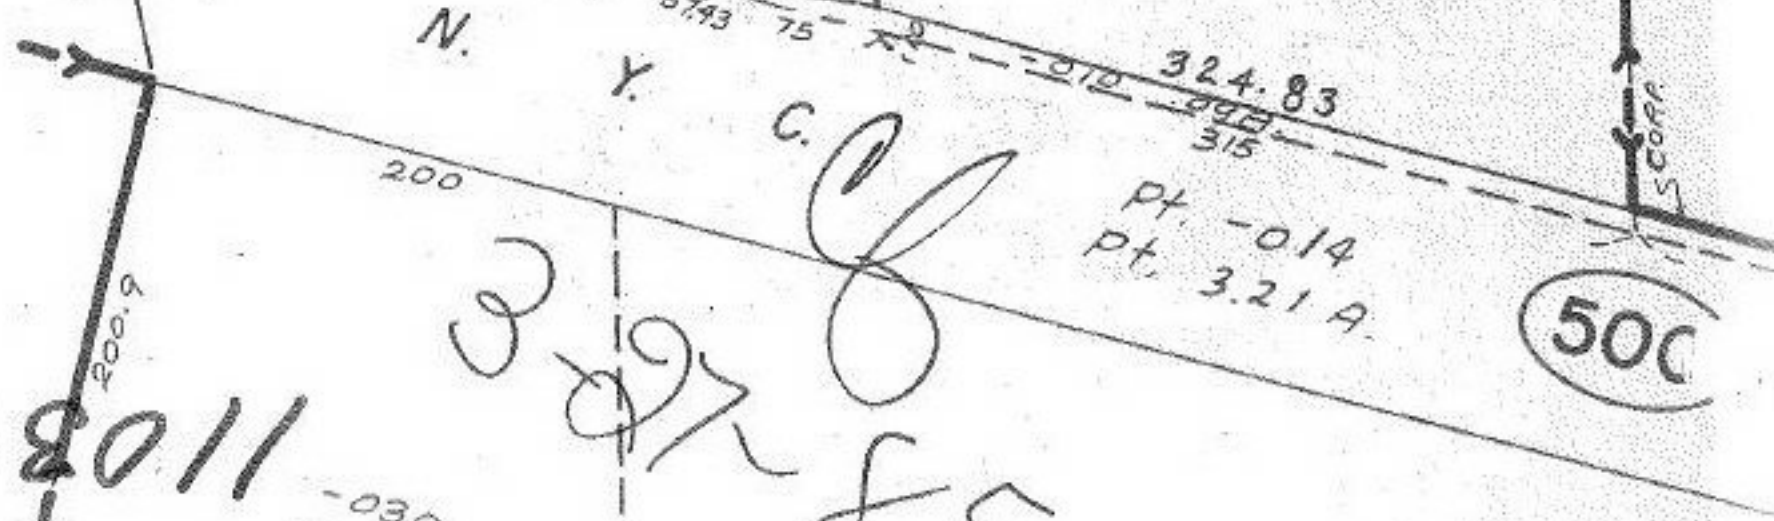

50C

Pt. -014
Pt. 3.21 A.

-030
2.21 A - Dup.
2.00 A - Pl.

11032

10

-031
1.24 A.

300.37
310

654.06

754.11

890.72

SCORP