

SEE

11038

23

# 11038

APPROVED  
LORAIN CO.  
MAP DEPT.

DATE 10-12-77

PAGE 4-K


BY *Robert*

VOID  
AFTER

MS  
12-8-77


JAYCOX

SCHWARTZ

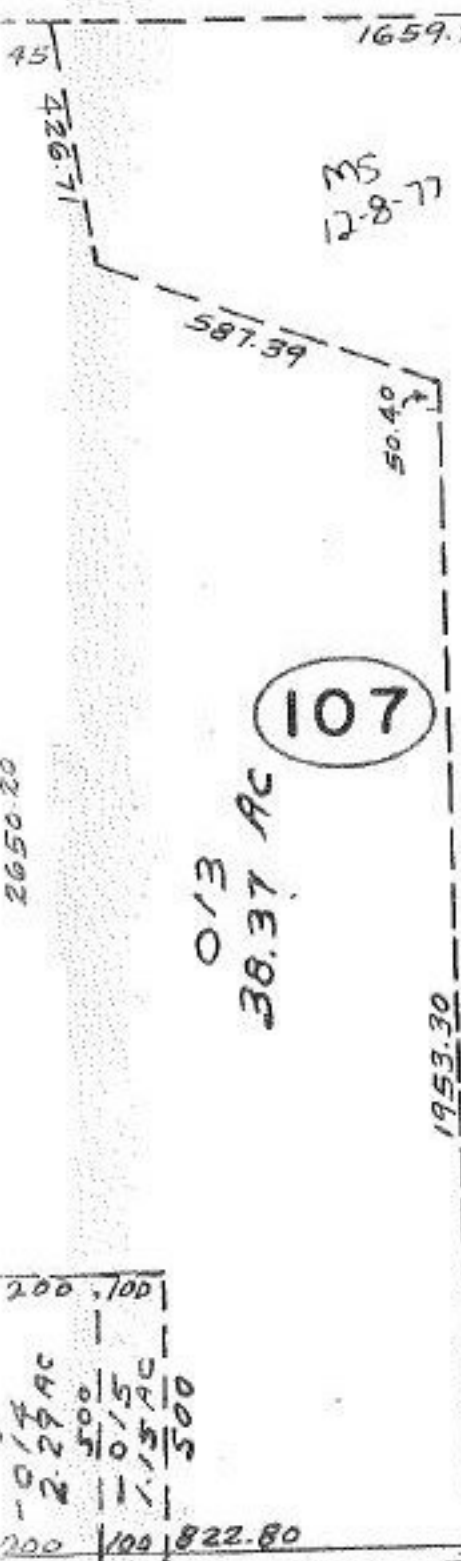

RD.

-003  
58.19A.

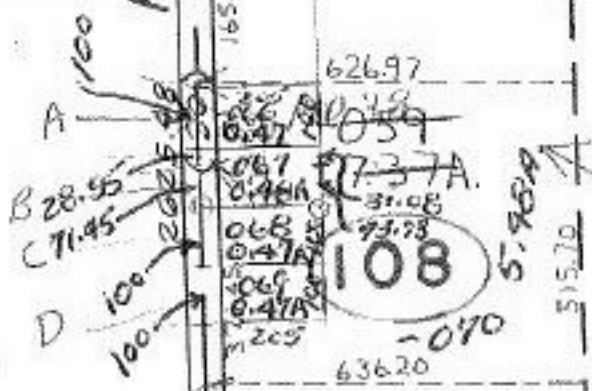

7.37  
1.89  
5.48

626.97  
205  
421.97

SEE 4-00-02

RD.

-060  
1286A.

31  
4  
15  
1.59



1659.24

RD.

(40)(60)(?)

392.45

618.15

02