


11159

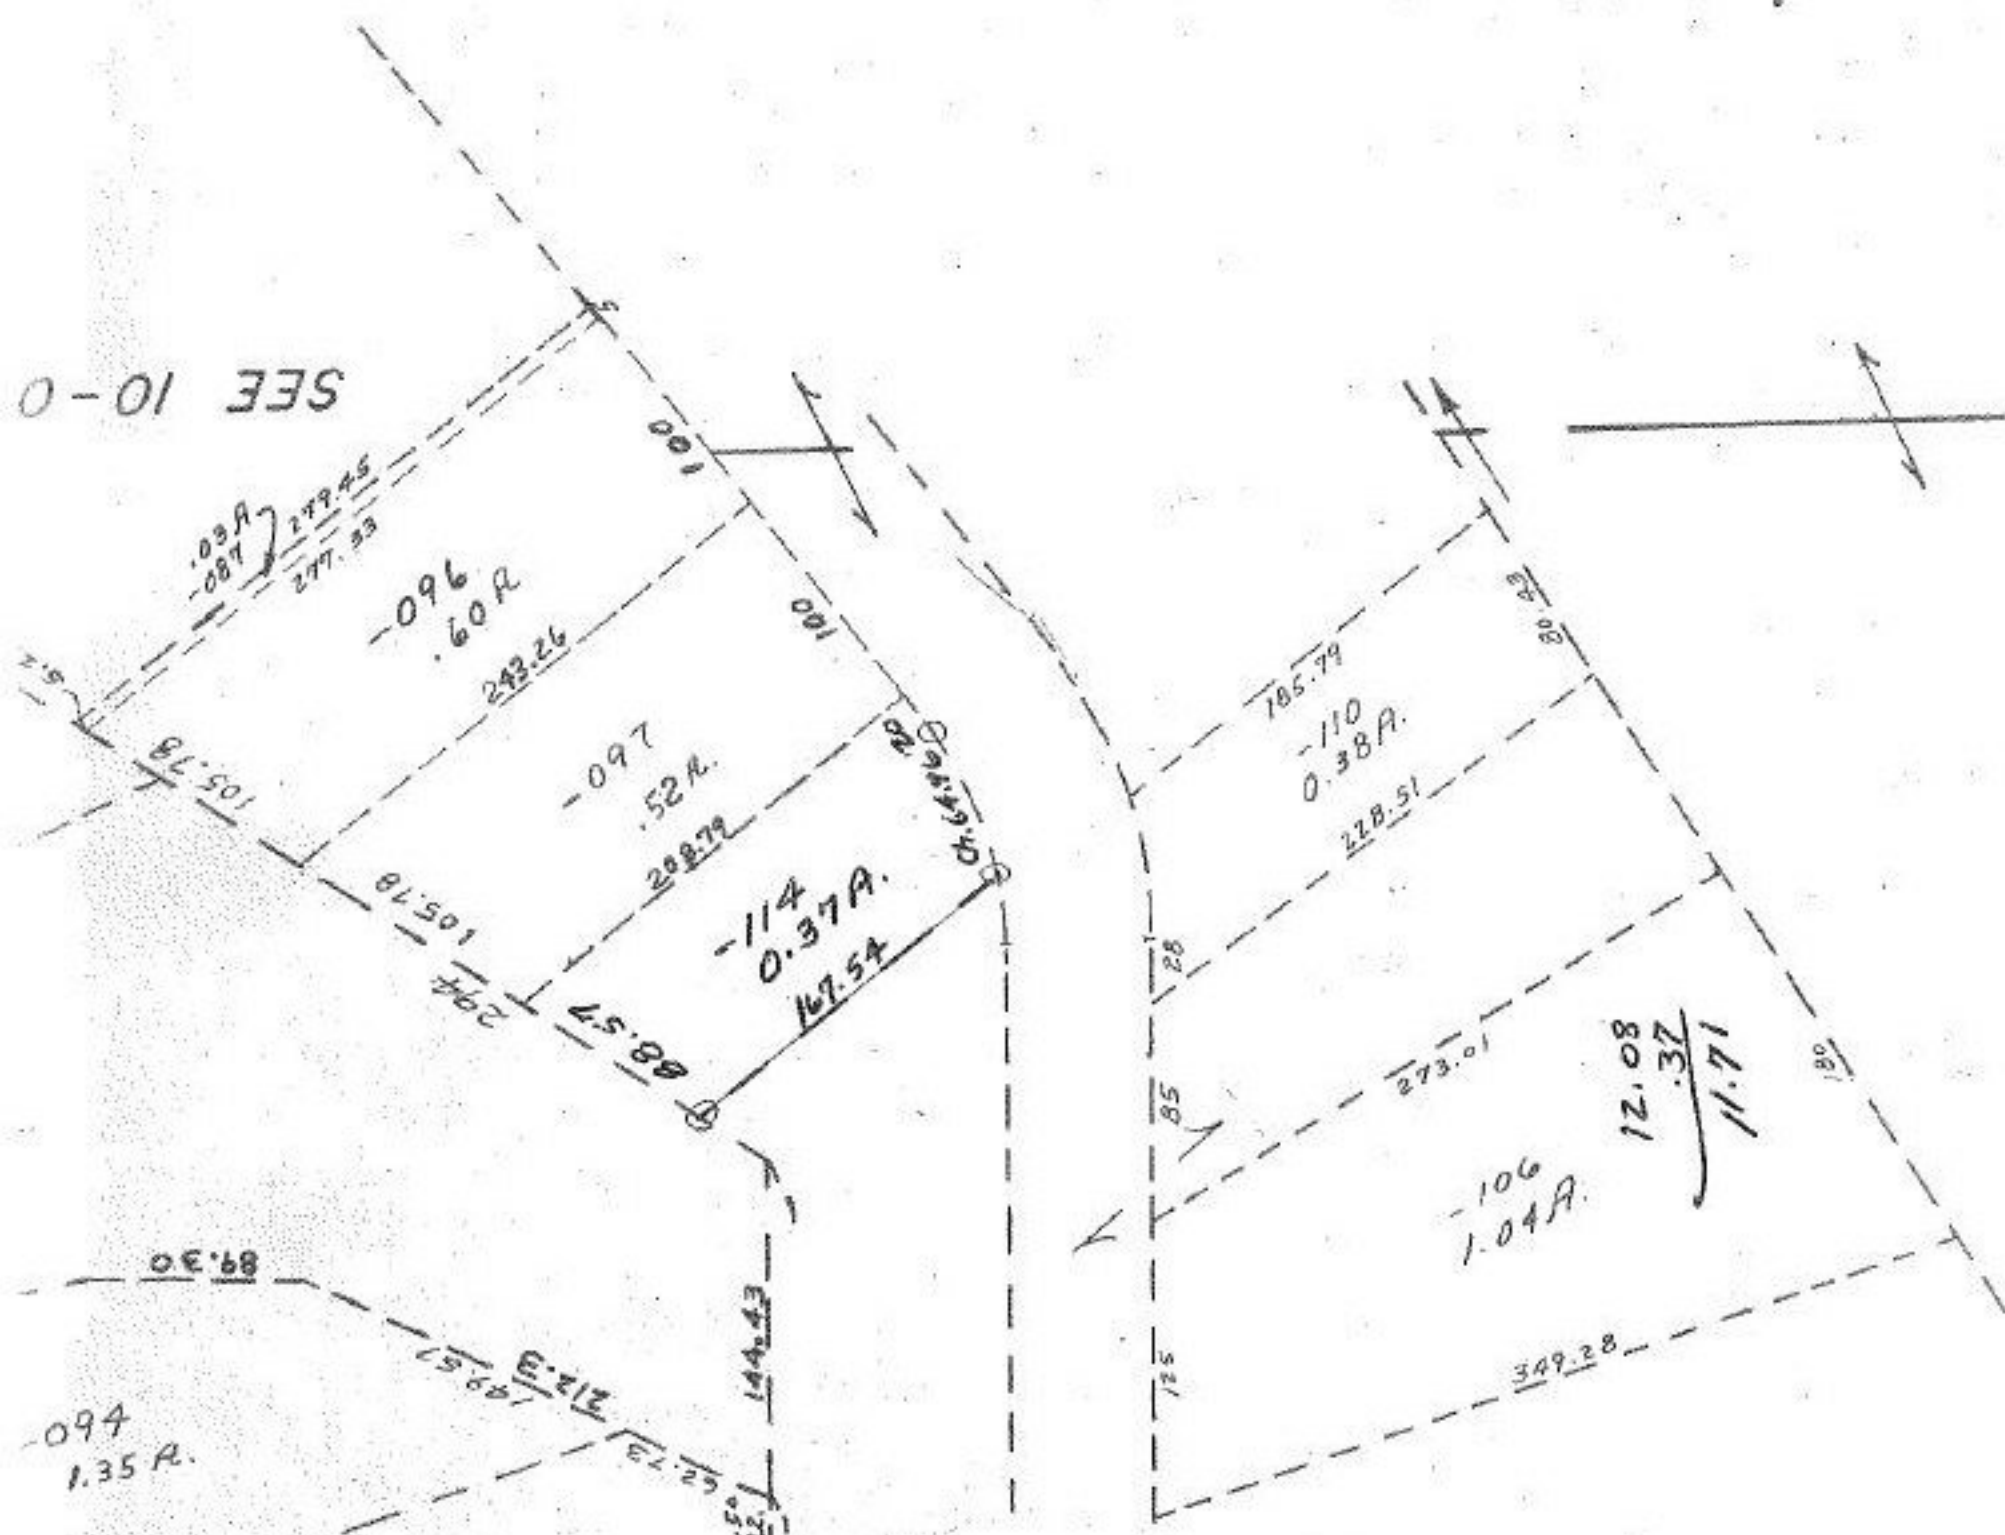

-115  
Pt. #113  
Pt. #114  
11.71A.C.

126

NOV 18 1977

APPROVED. LORAIN CO. MAP DEPT.		DATE 11-15-77	12/10/77
		PAGE 10-20-006-6	2A
BY <i>[Signature]</i>			
VOID AFTER			

#11159