

10-18

#11170

APPROVED
 LORAIN CO.
 MAP DEPT.


DATE 10-31-77
 12/19/77
 3A.

PAGE 3-100-03-B
 29.15

BY M. Staudt
 3296

VOID AFTER 11170

NOV 10 1977

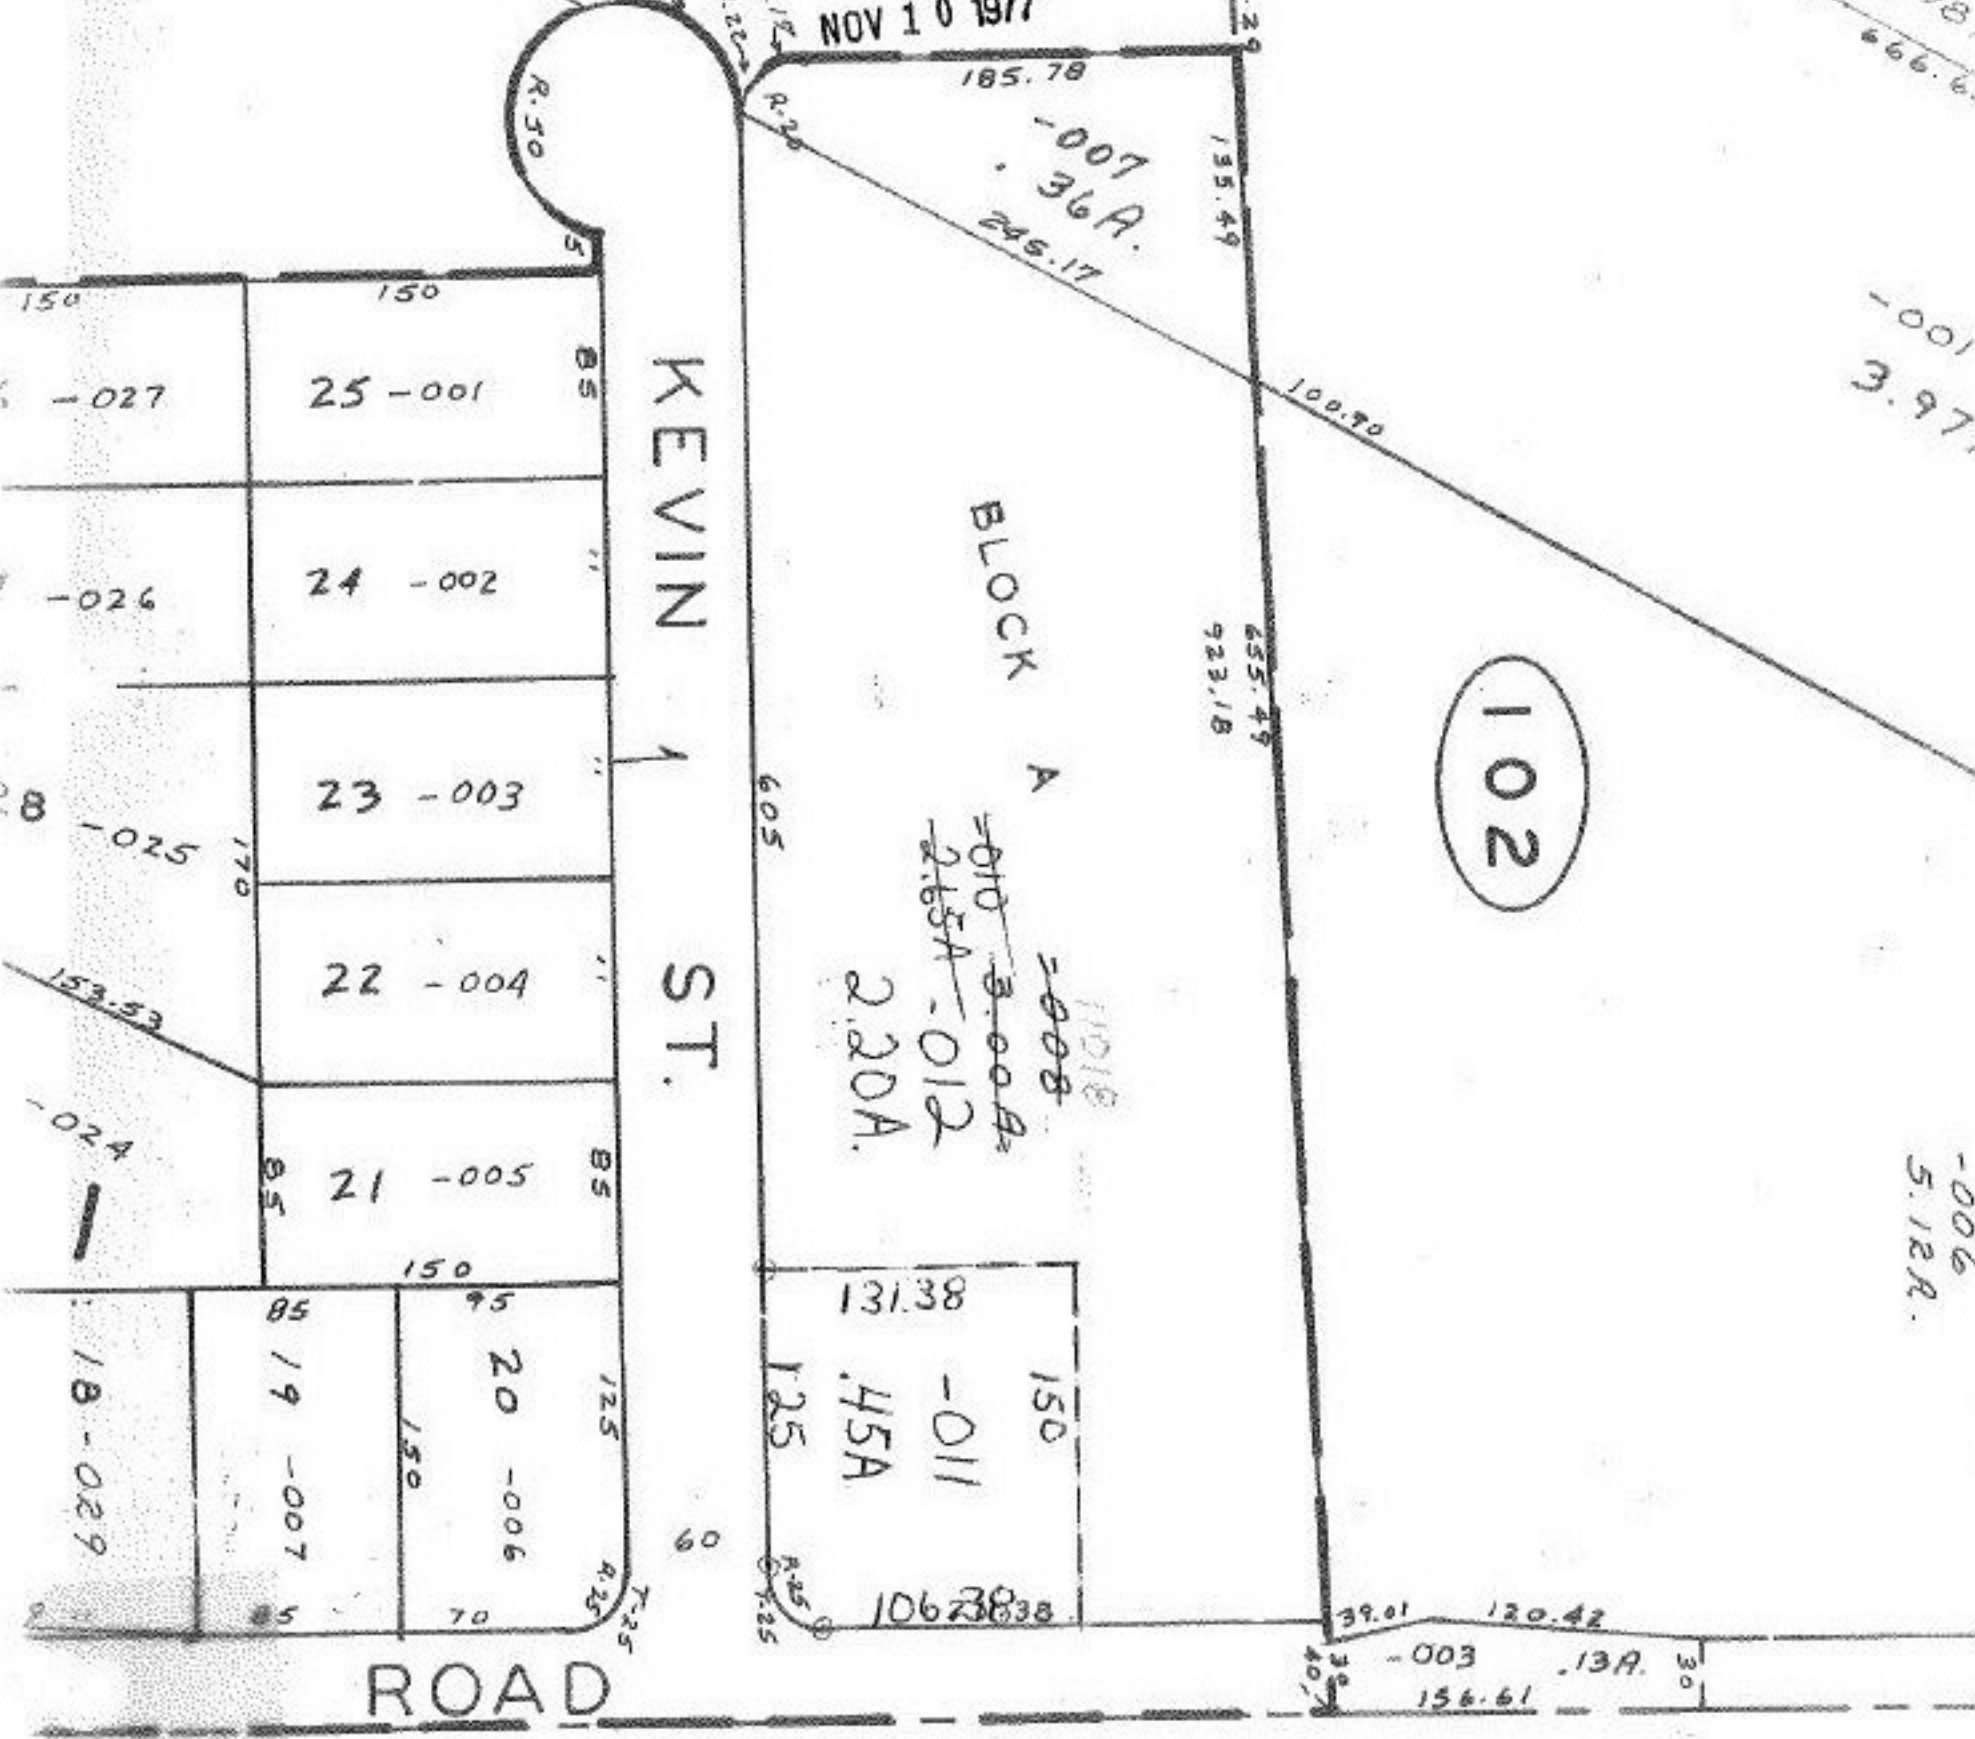

265
295
2.20