


10-78  
#11175

11175

APPROVED LORAIN CO. MAP DEPT.	
DATE 11-1-77	12-8/77
PAGE 01-00-027	J.A.
BY <i>D. Milne</i>	
VOID AFTER	11175

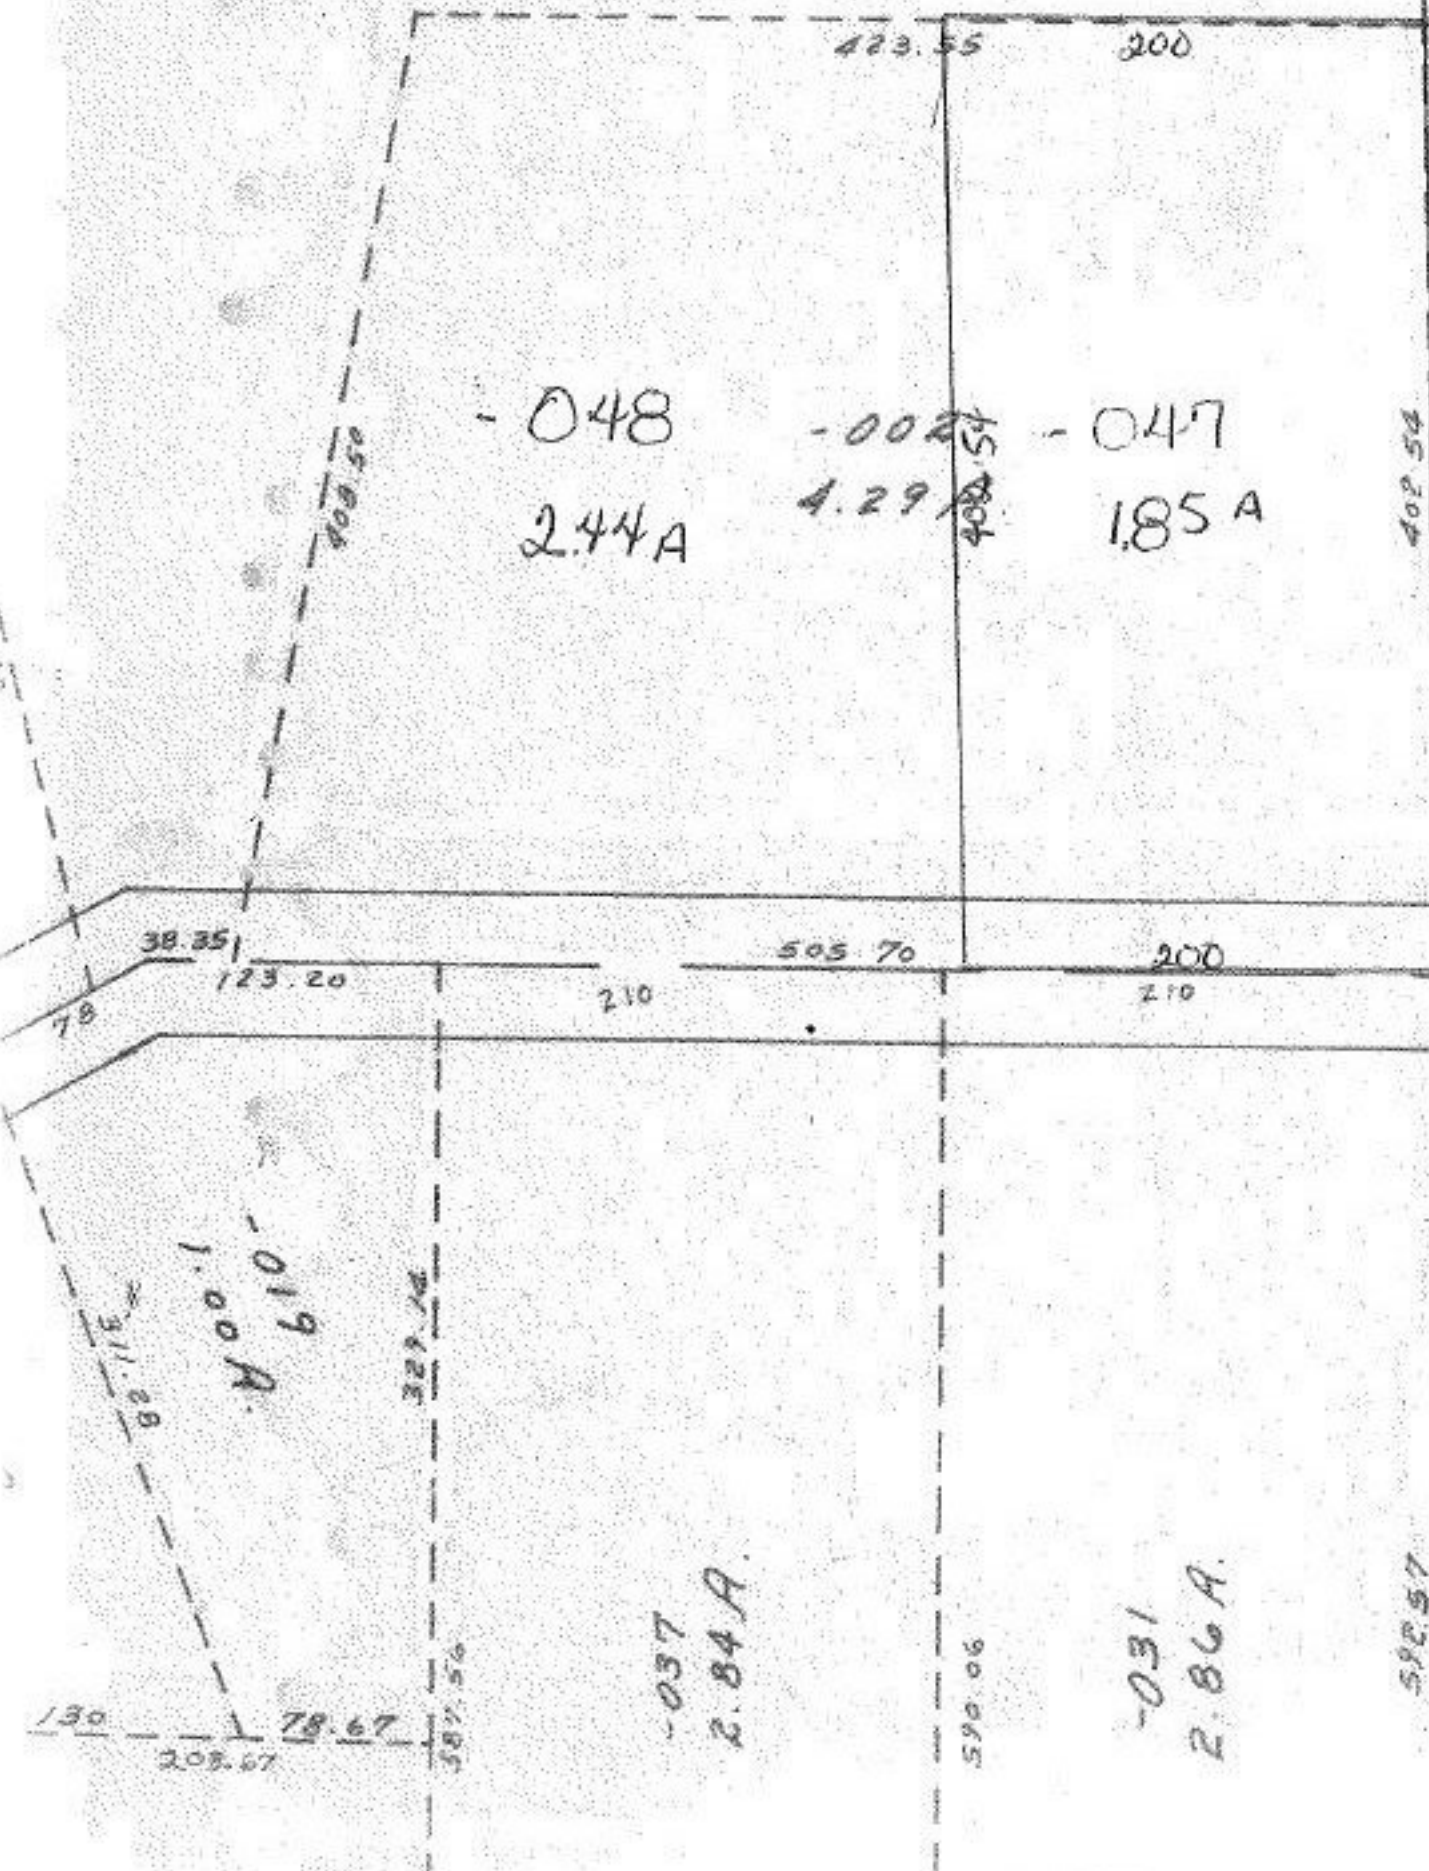

$$\frac{4.29}{1.85} = 2.32$$