


2-00-004-A
11189

11189

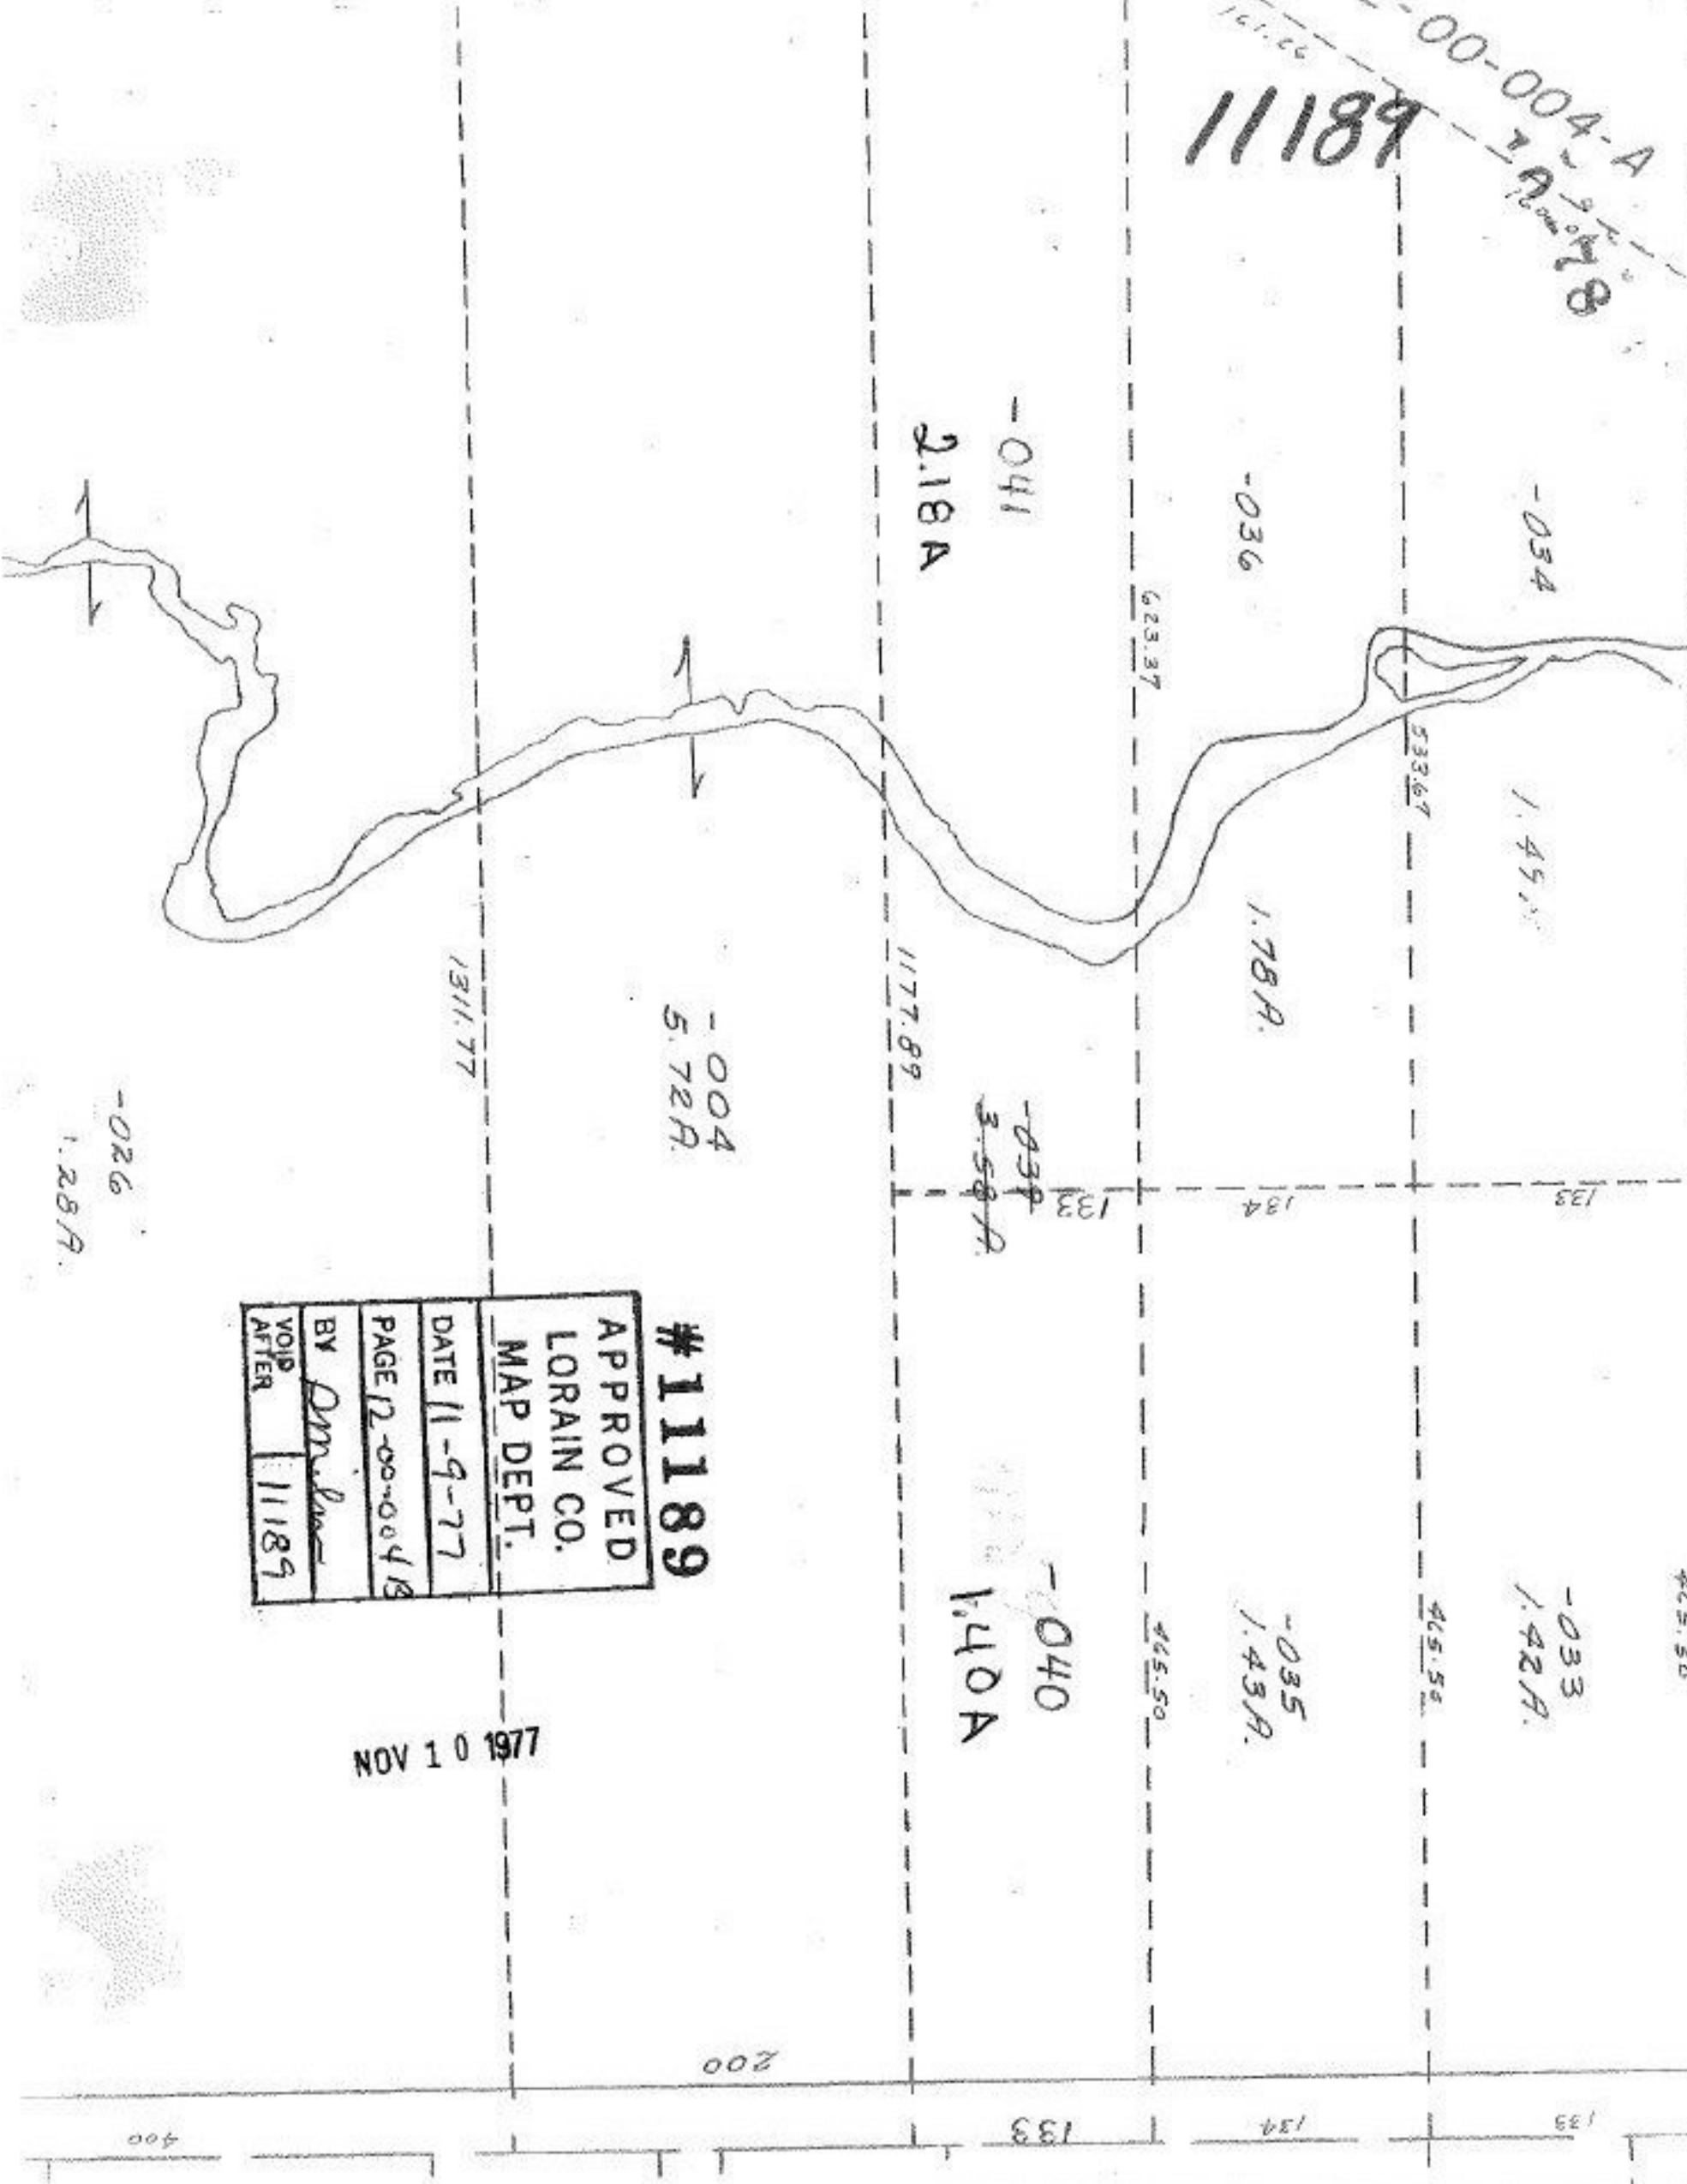

#11189	
APPROVED	
LORAIN CO.	
MAP DEPT.	
DATE	11-9-77
PAGE	12-00-00418
BY	<i>Ameline</i>
VOID AFTER	11189

NOV 10 1977

200

400

133

134

133