


105.00R.

92

#11212

APPROVED	
LORAIN CO.	
MAP DEPT.	
DATE 11-15-77	
PAGE 10 E	
BY D. Milner	
VOID AFTER	11212

NOV 18 1977

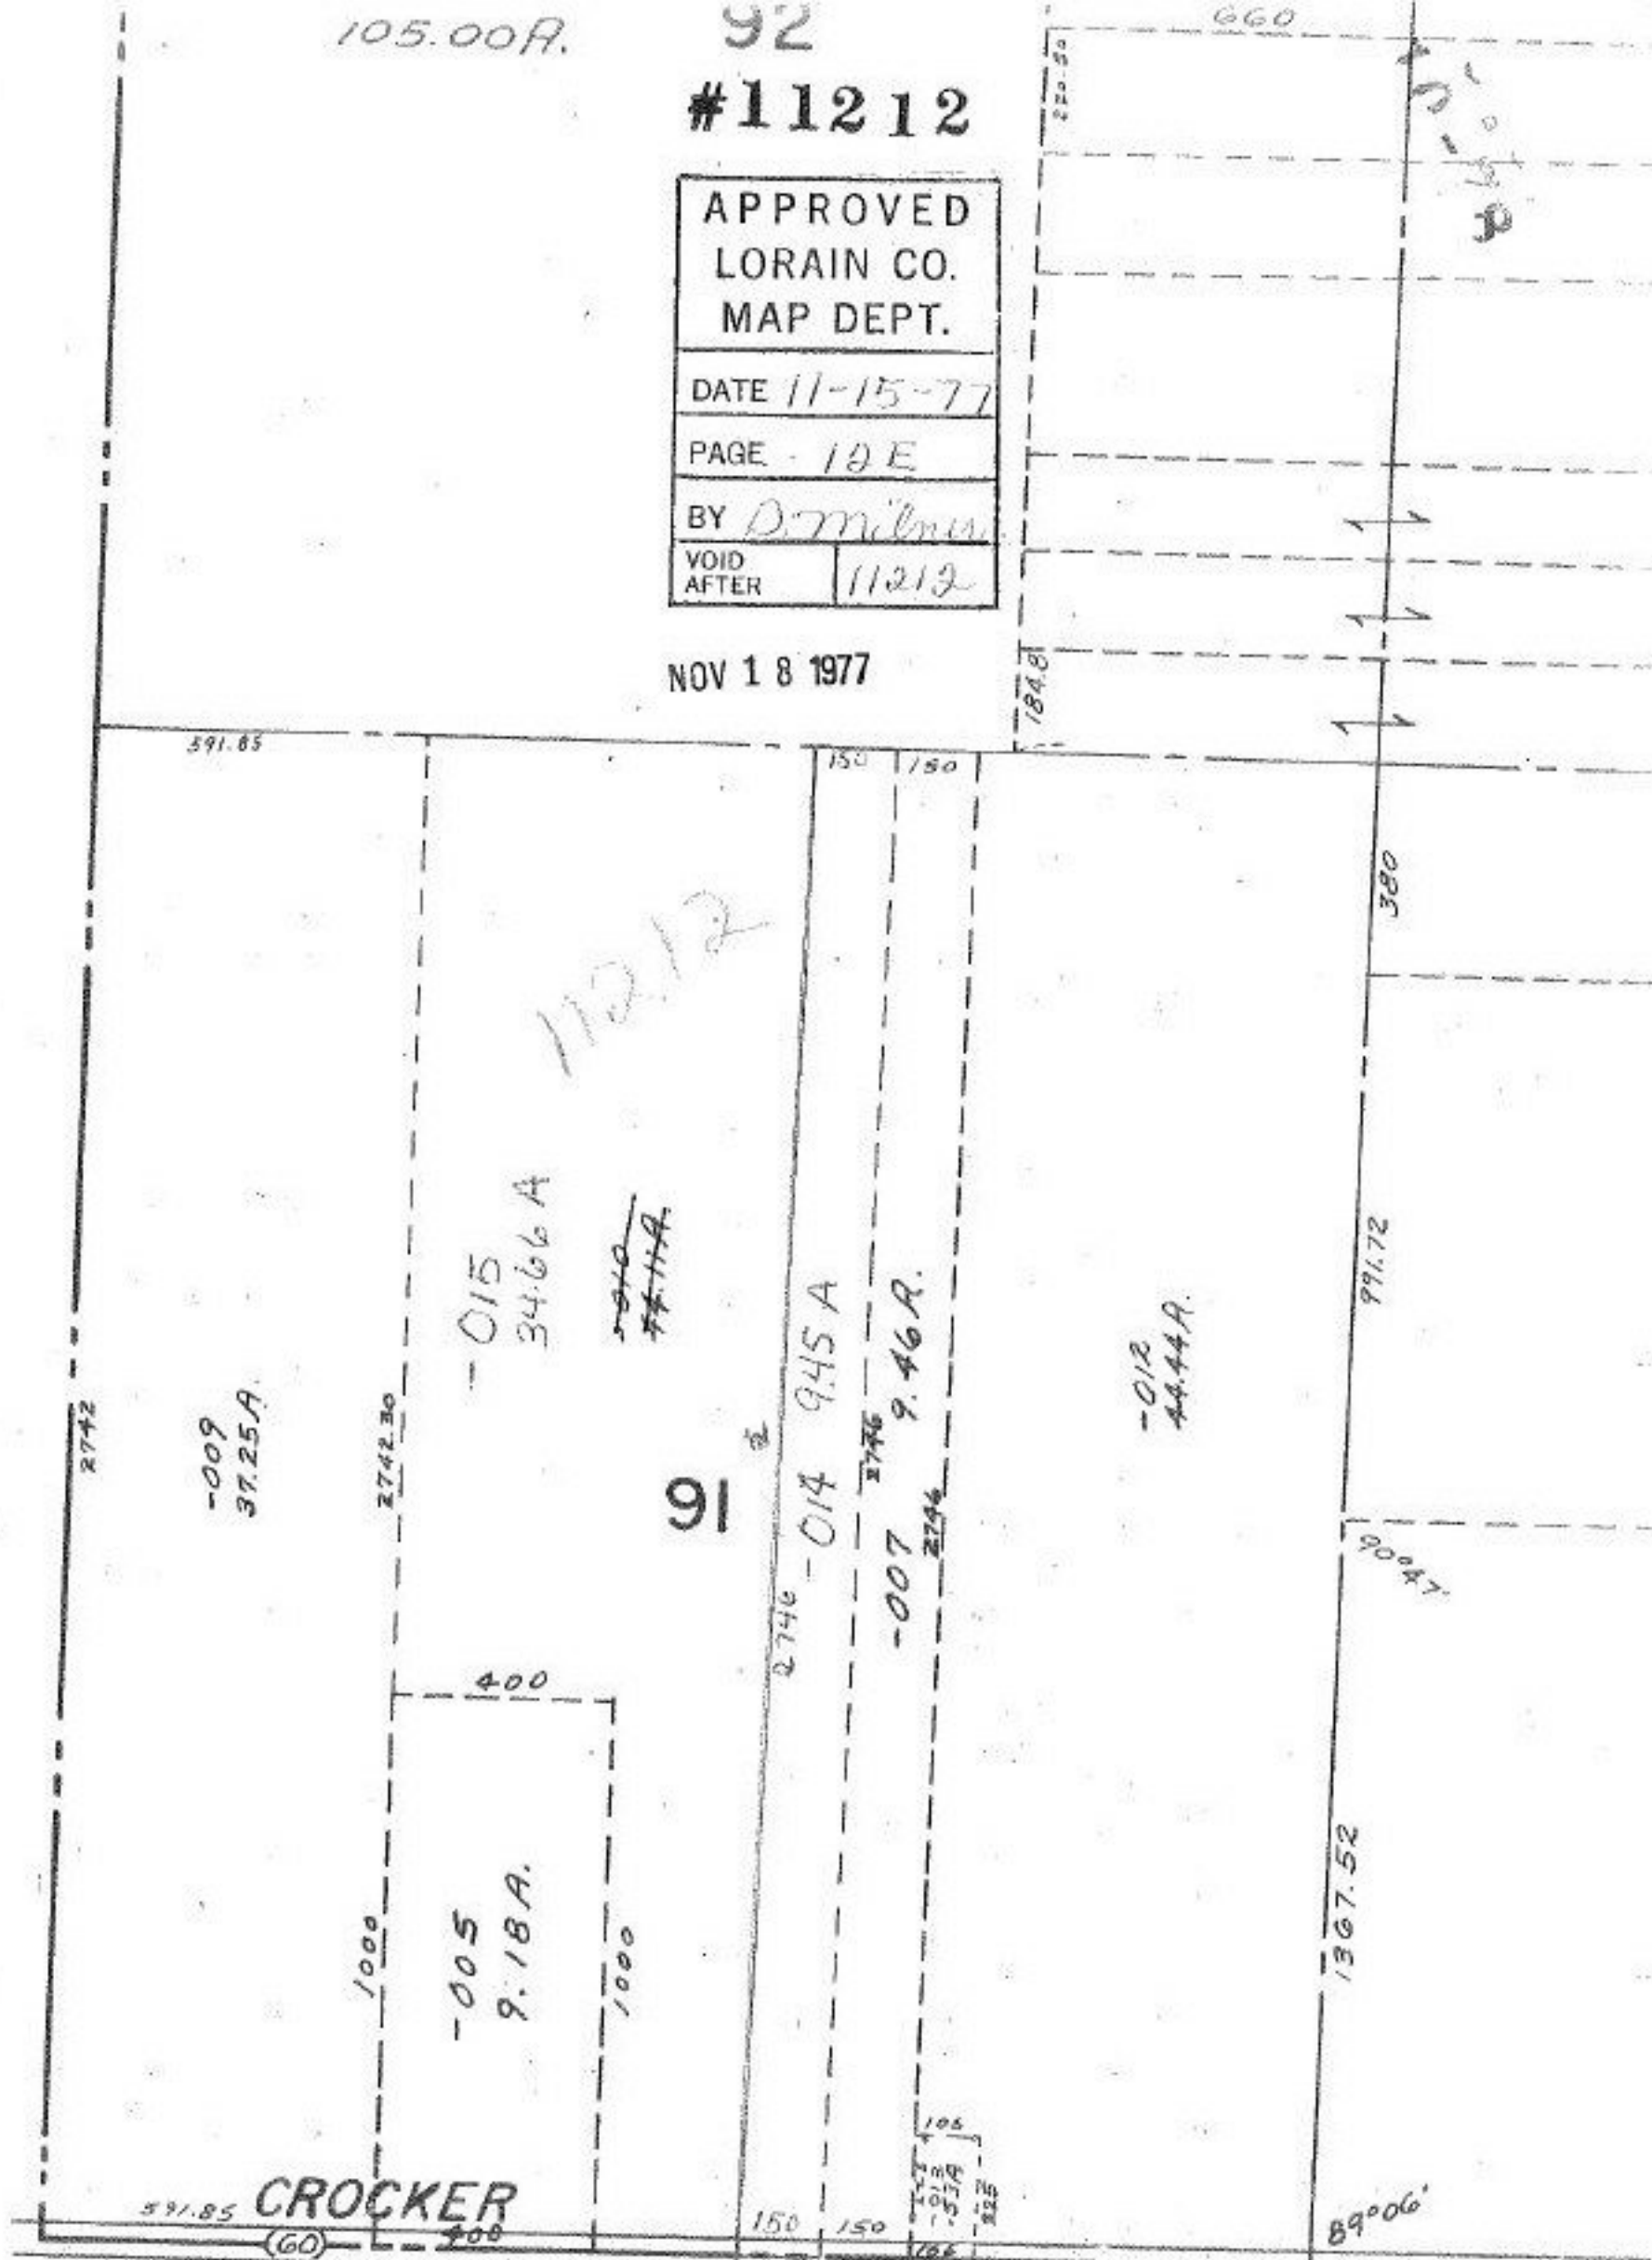

COLUMBIA TWP