

2

14.96 A.
10-11223
8

88°48'

3/8/43
Co Com Res 63-160

1304.91
60 120

LORAIN CITY ORD 26-66 3/8/66
732.96

~~058~~
~~062~~
9.19A
~~056~~
9.56A
-062
8.82A


9.56
37
9.79
-005
1.00A 37
8.82
-006
2.00A

#11223

M.S.
12-12-77

APPROVED LORAIN CO. MAP DEPT.
DATE 11-21-77
PAGE 5-00-001-A
BY M. Stouff
VOID AFTER 11223

NOV 22 1977

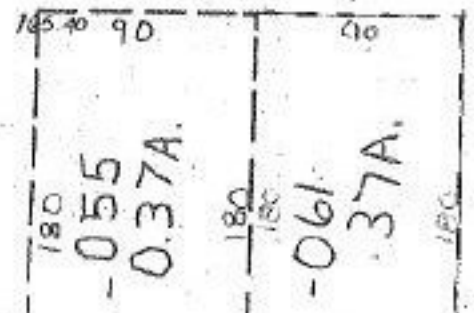

75.40 90 90 421.90
COOPER FOSTER-PARK 60 120

SEE 5-A