


11226
11-00-016-B

-050
~~-046~~
55-31A
52.91A

#11226
APPROVED
LORAIN CO.
MAP DEPT.
DATE 11-21-77
PAGE 11-00-016-B
BY *Hollist*
VOID
AFTER

NOV 22 1977

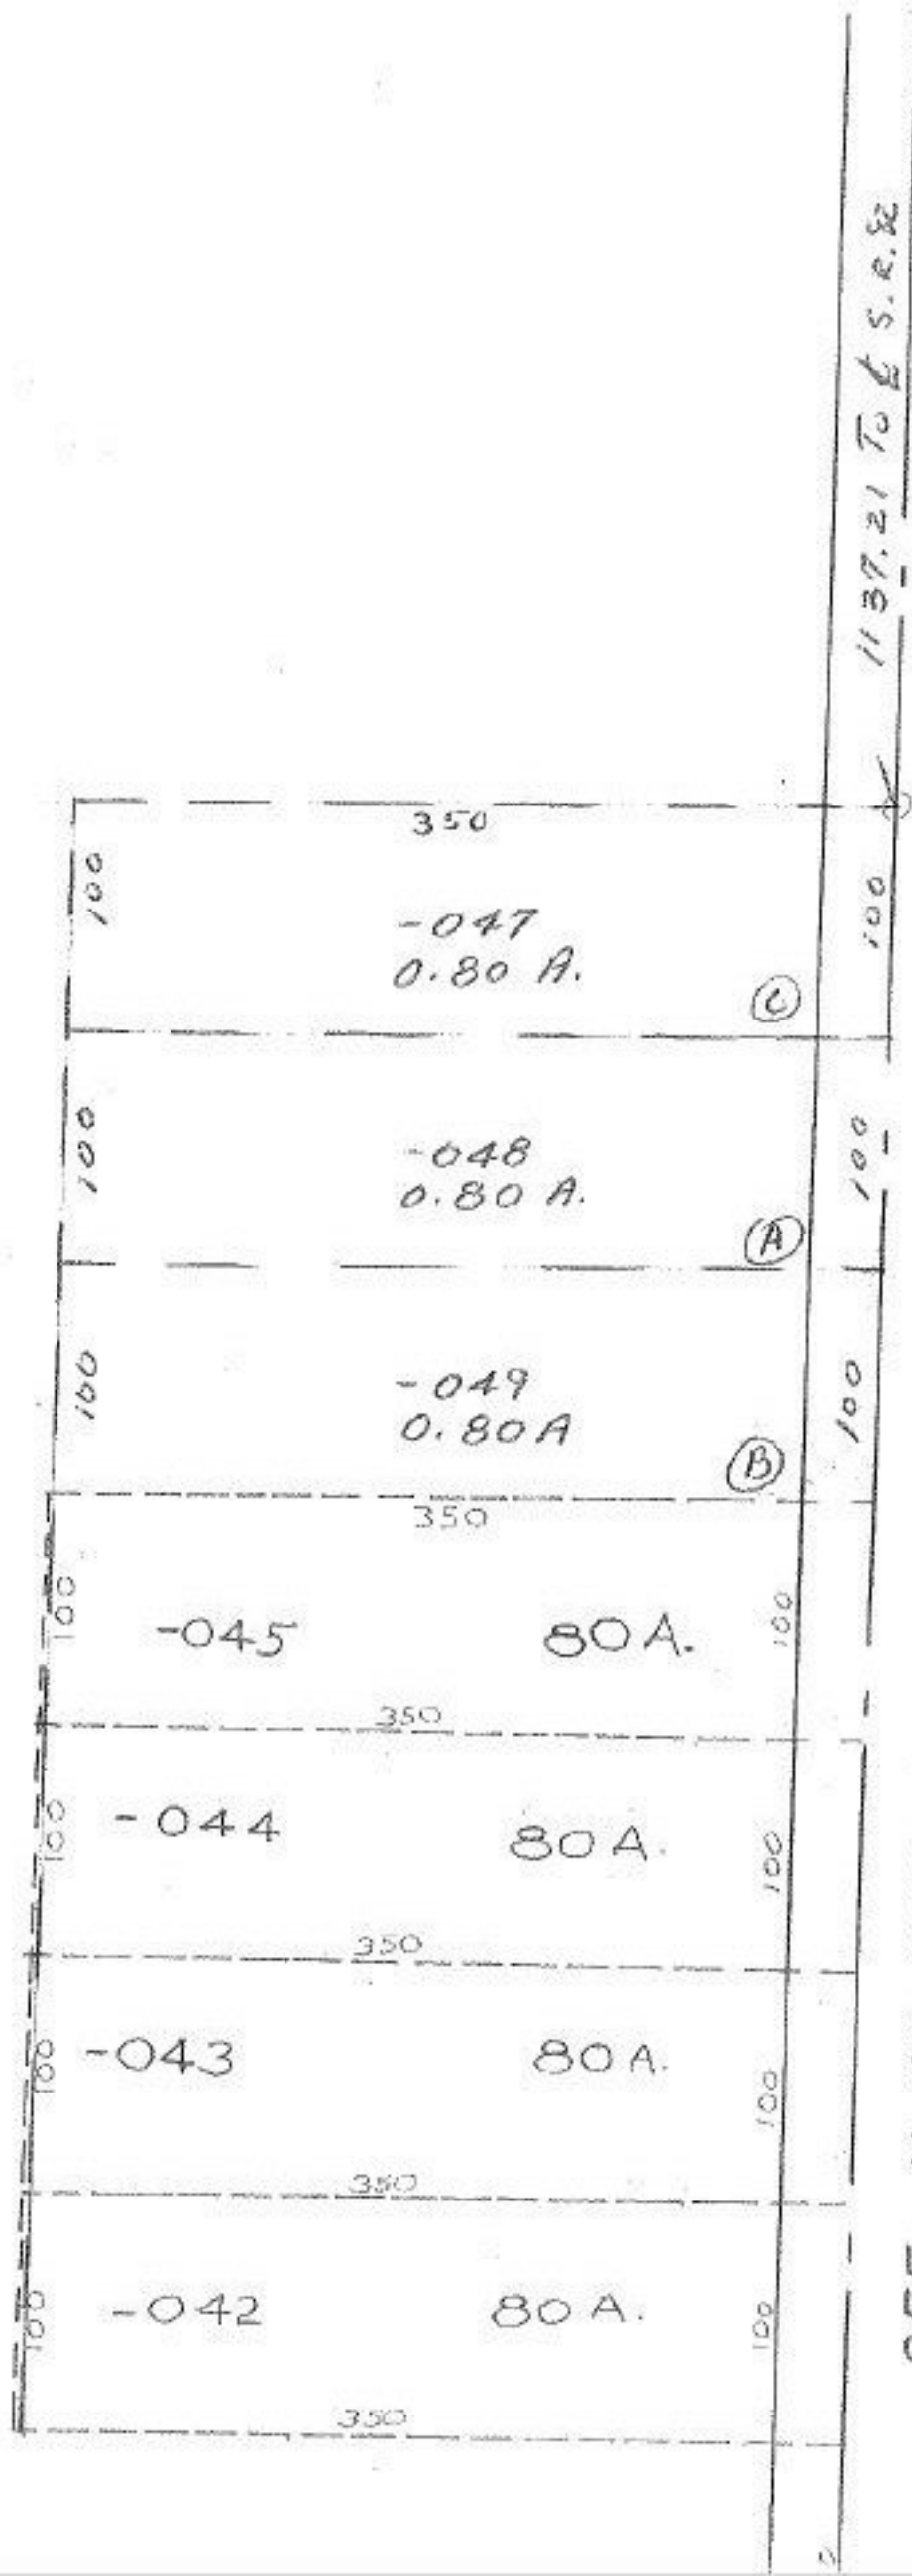

SEE 11-00-005-A