


#11260

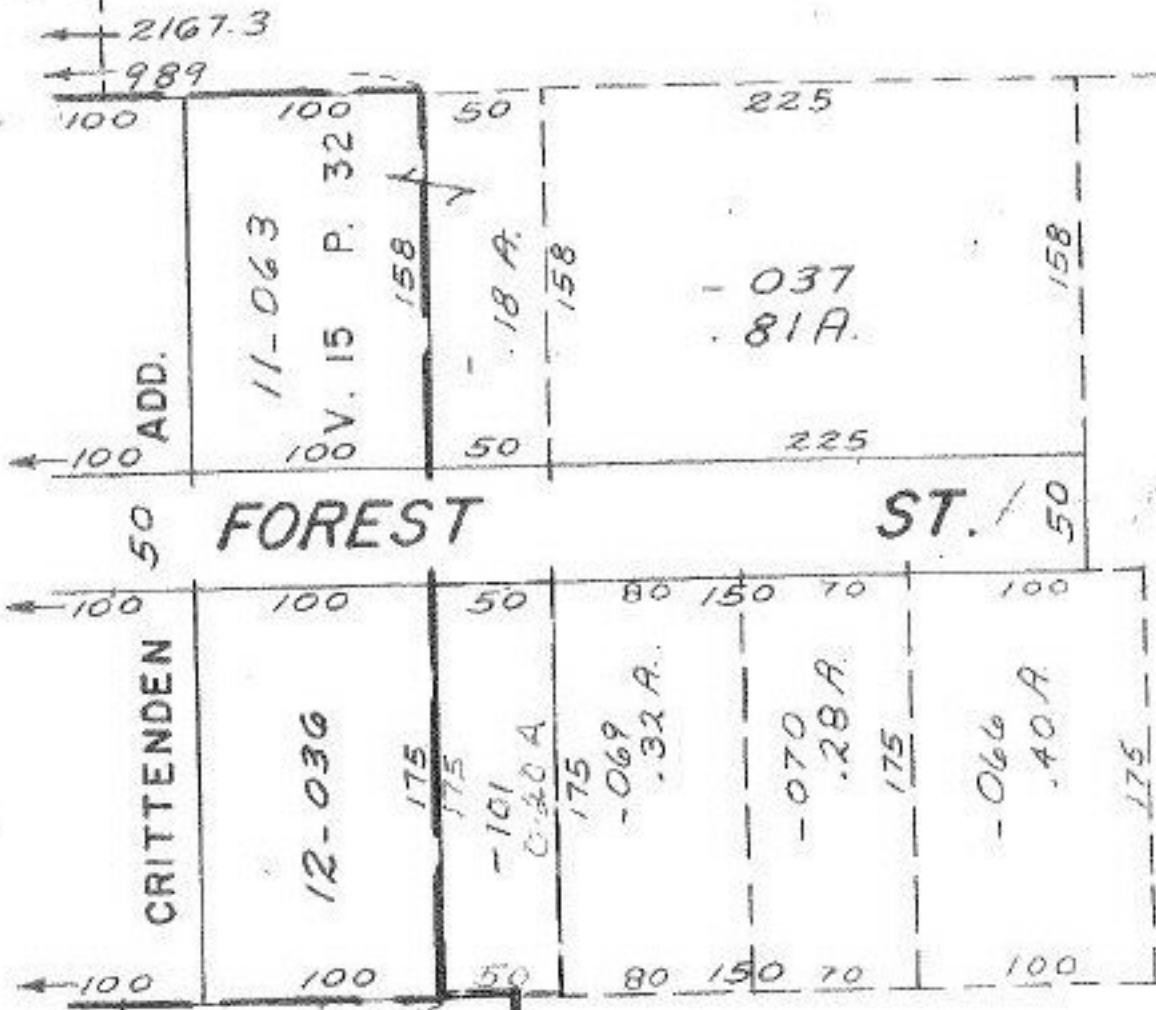

APPROVED	
LORAIN CO.	
MAP DEPT.	
DATE	11-30-77 11/1/78
PAGE	15-00-046 <sup>B</sup> 2A
BY	<i>D. M. G. ...</i>
VOID AFTER	11260

-102

17.30 A

SEE 15-00-04-A

#11260

Pt. - 065

100