

C.


05-25-010 1st-002  
812. 001 Leased  
LAND

500

Pt. -002  
Pt. 4.73A.

10-78 11270

SEE 6-108

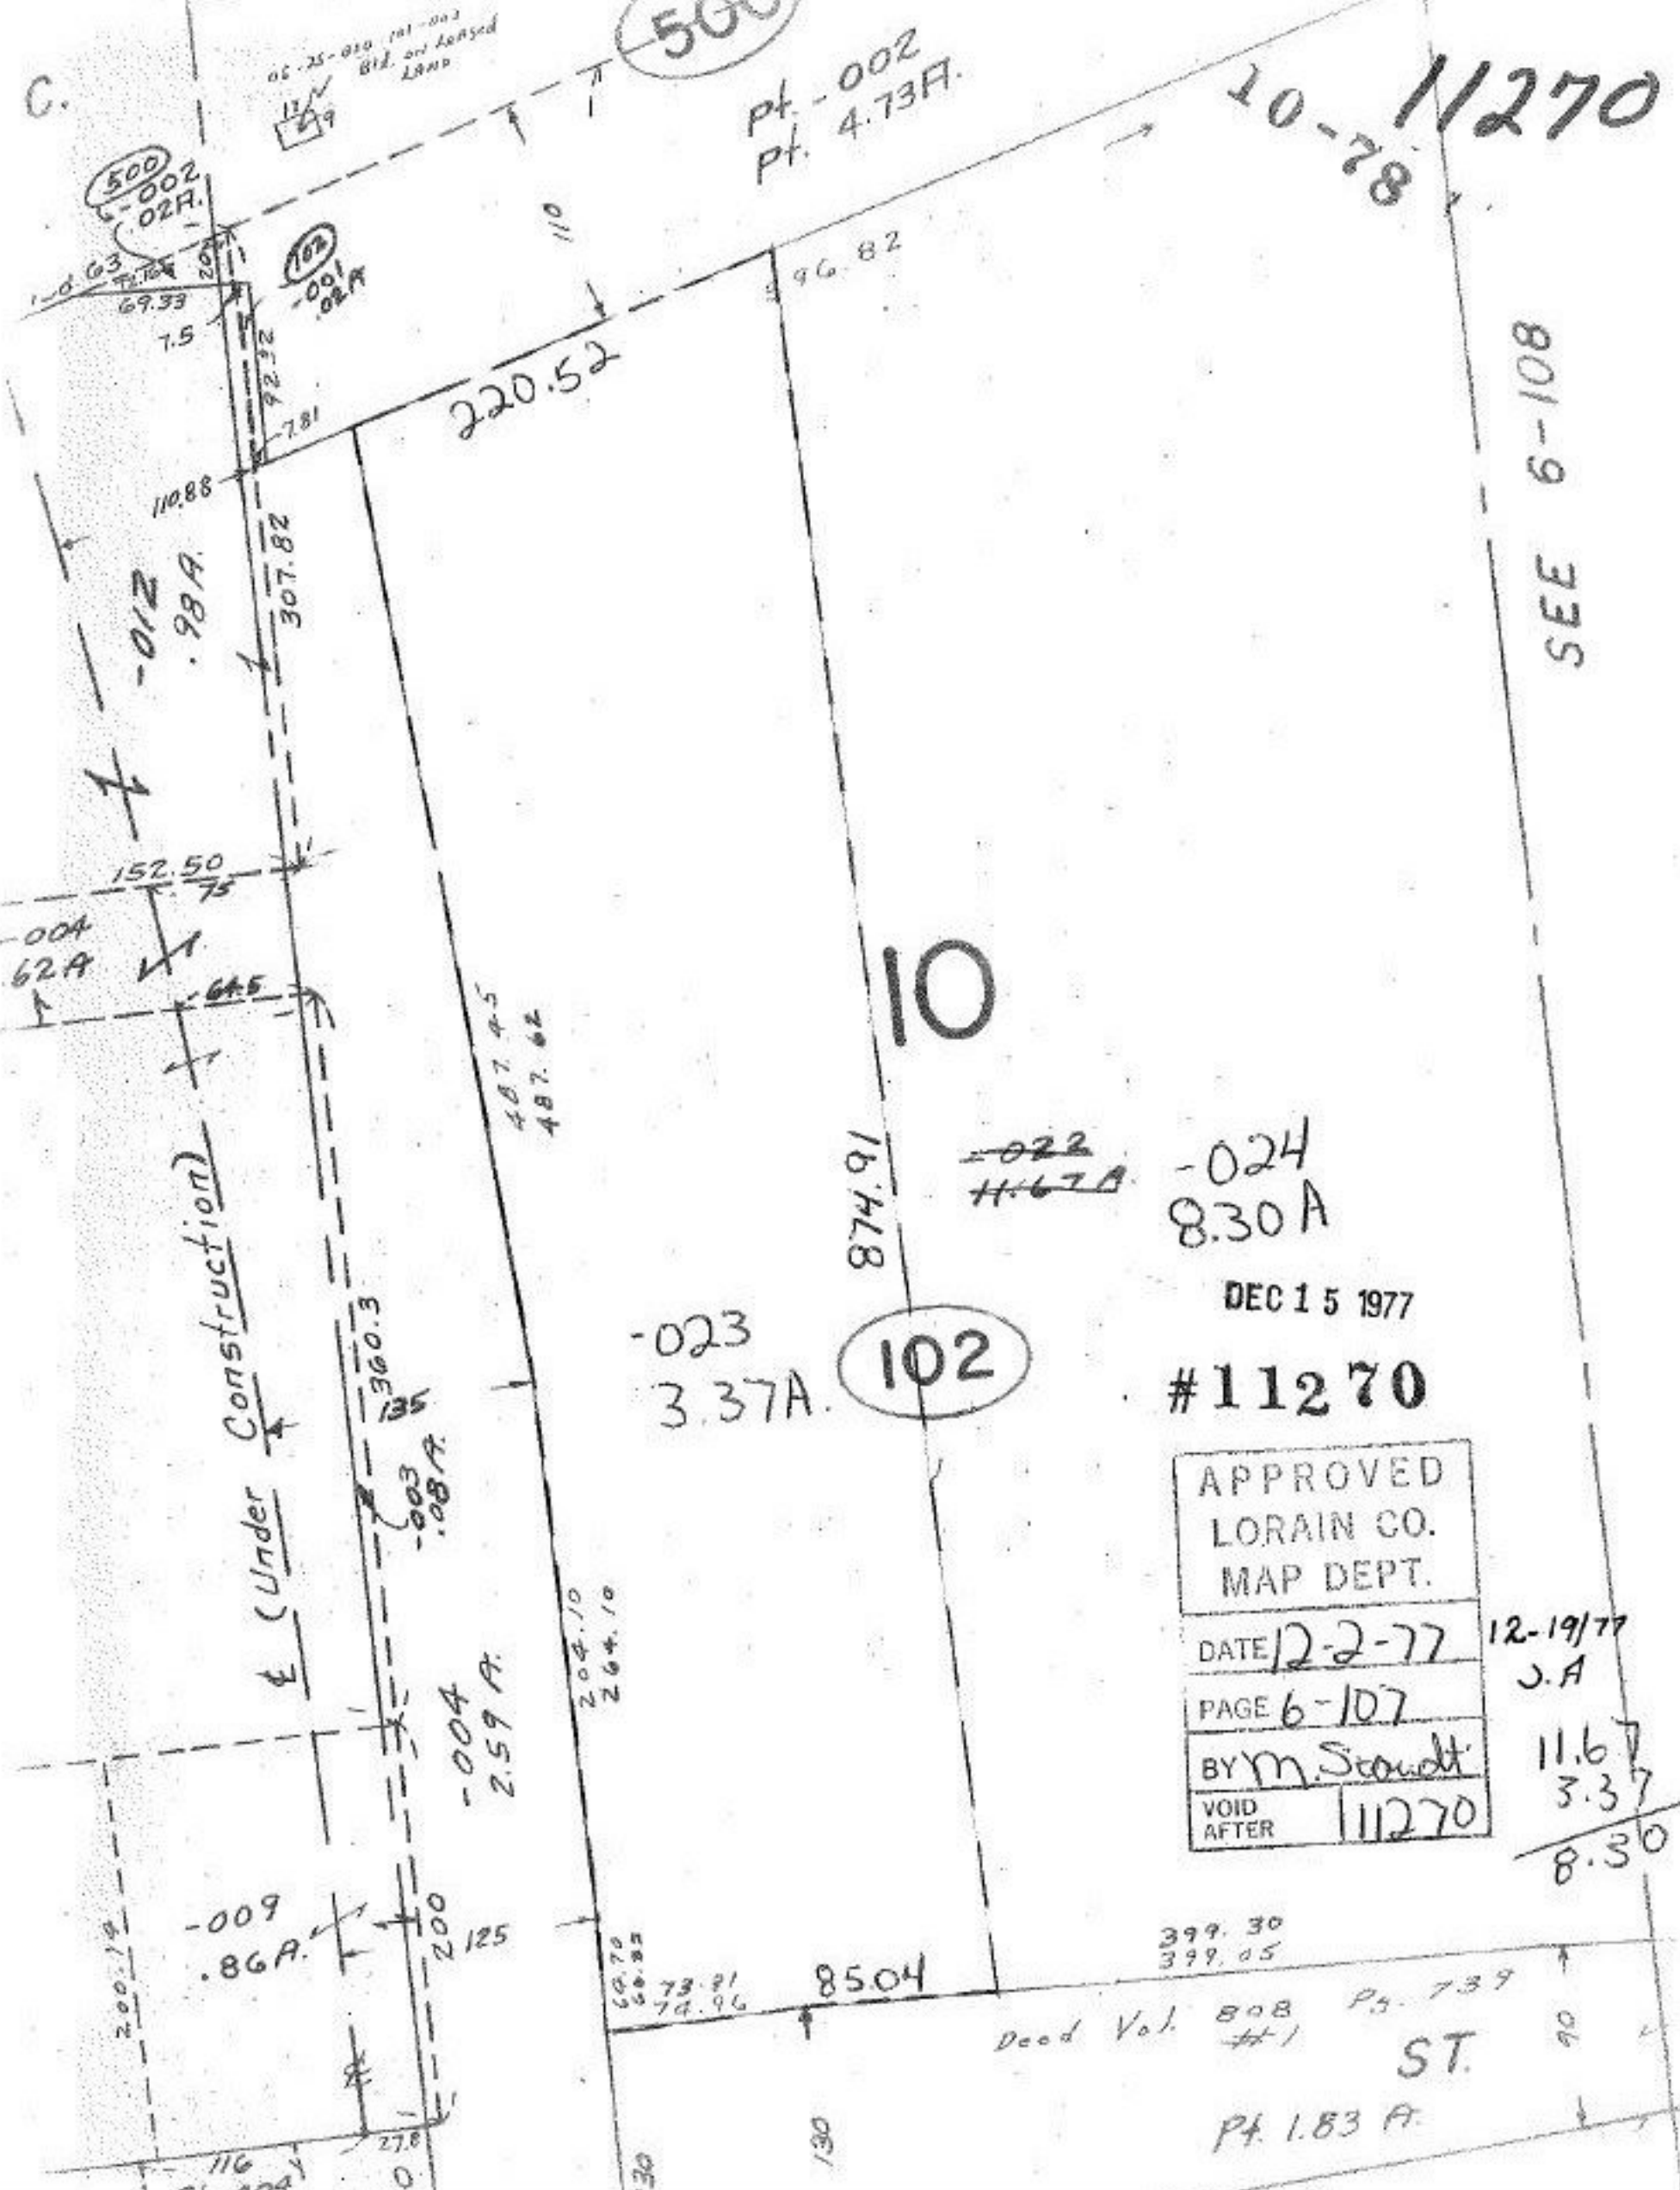

-024  
8.30A

DEC 15 1977

#11270

APPROVED LORAIN CO. MAP DEPT.
DATE 12-2-77
PAGE 6-107
BY M. Stoult
VOID AFTER 11270

12-19/77  
J.A  
11.67  
3.37  
8.30

-023  
3.37A.

102

874.91

-022  
H.67A

(Under Construction)

-004  
2.59A.

-009  
.86A.

399.30  
399.05  
Deed Vol. 808 P. 739 #1  
ST.  
Pt. 1.83 A.

-004  
62A

500  
-002  
02A.

100  
-001  
02A.

1-0-63  
71.16  
69.33  
7.5

-012  
.98A.

152.50  
75

-045

-003  
.08A.

-004  
2.59A.

200.19

116  
Pt -004

204.10  
264.10

60.70  
66.82  
73.91  
74.96

85.04

130

130

90