

11278

DEC 13 1977


RD.

APPROVED	
LORAIN CO.	
MAP DEPT.	
DATE	12-12-77
PAGE	07:00-0038
BY	T. W. McMan
VOID AFTER	

12-14-77
J.A.

DEC 13 1977
10

BUTTERNUT RIDGE

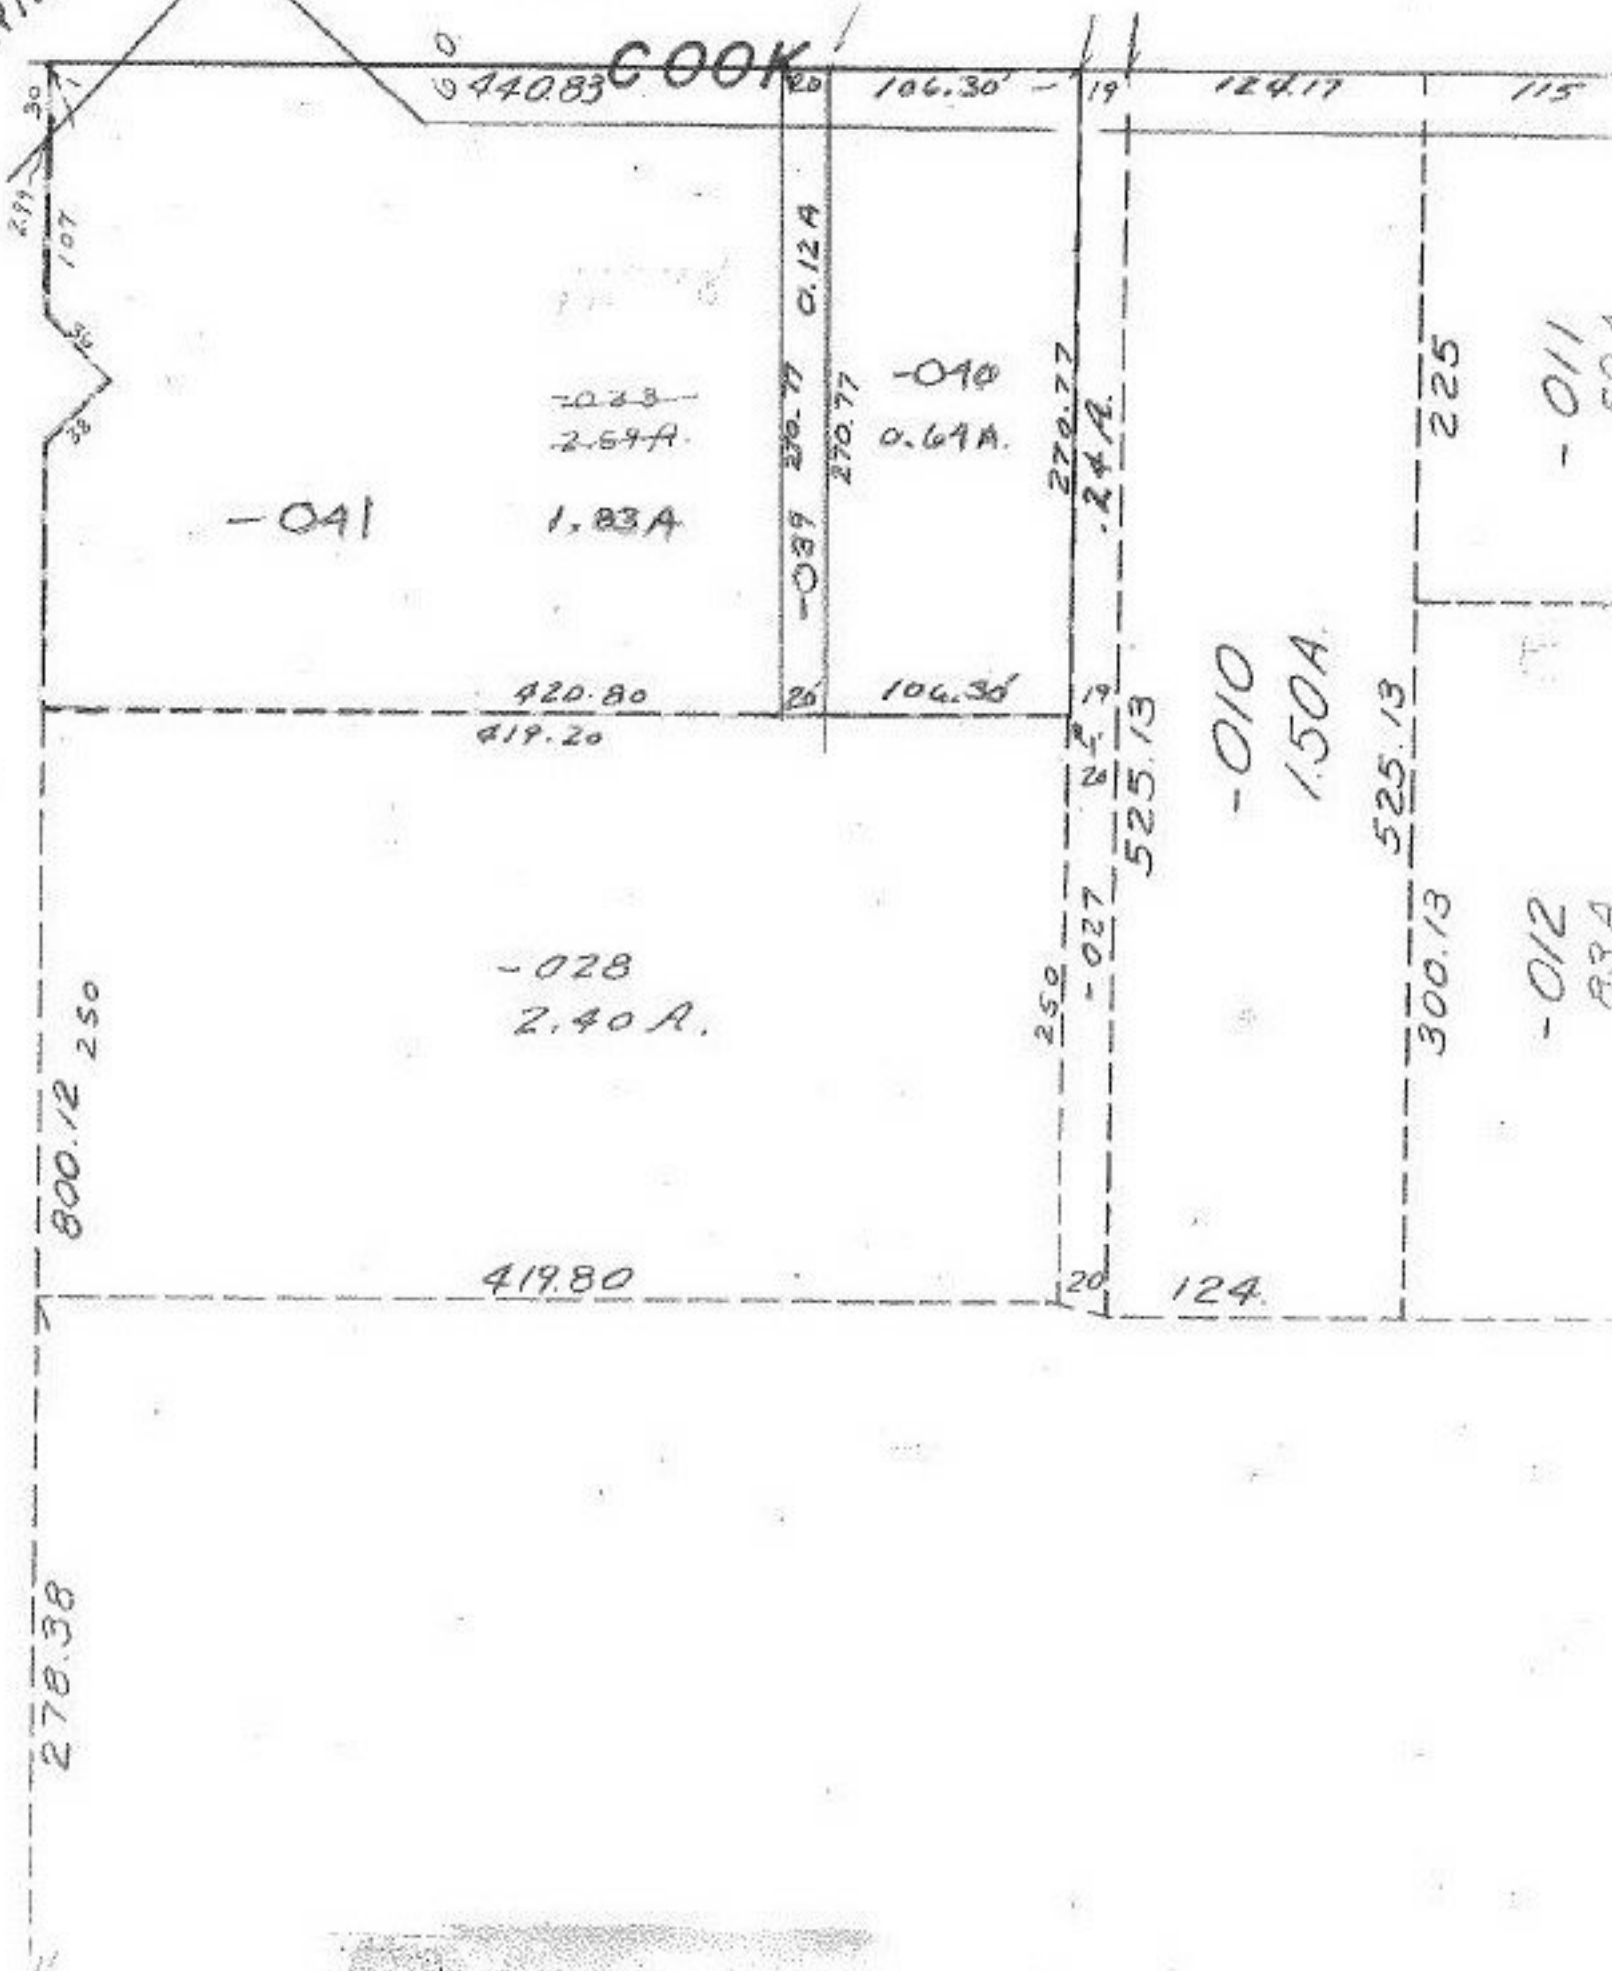

11278