


# 11283  
11283  
11283

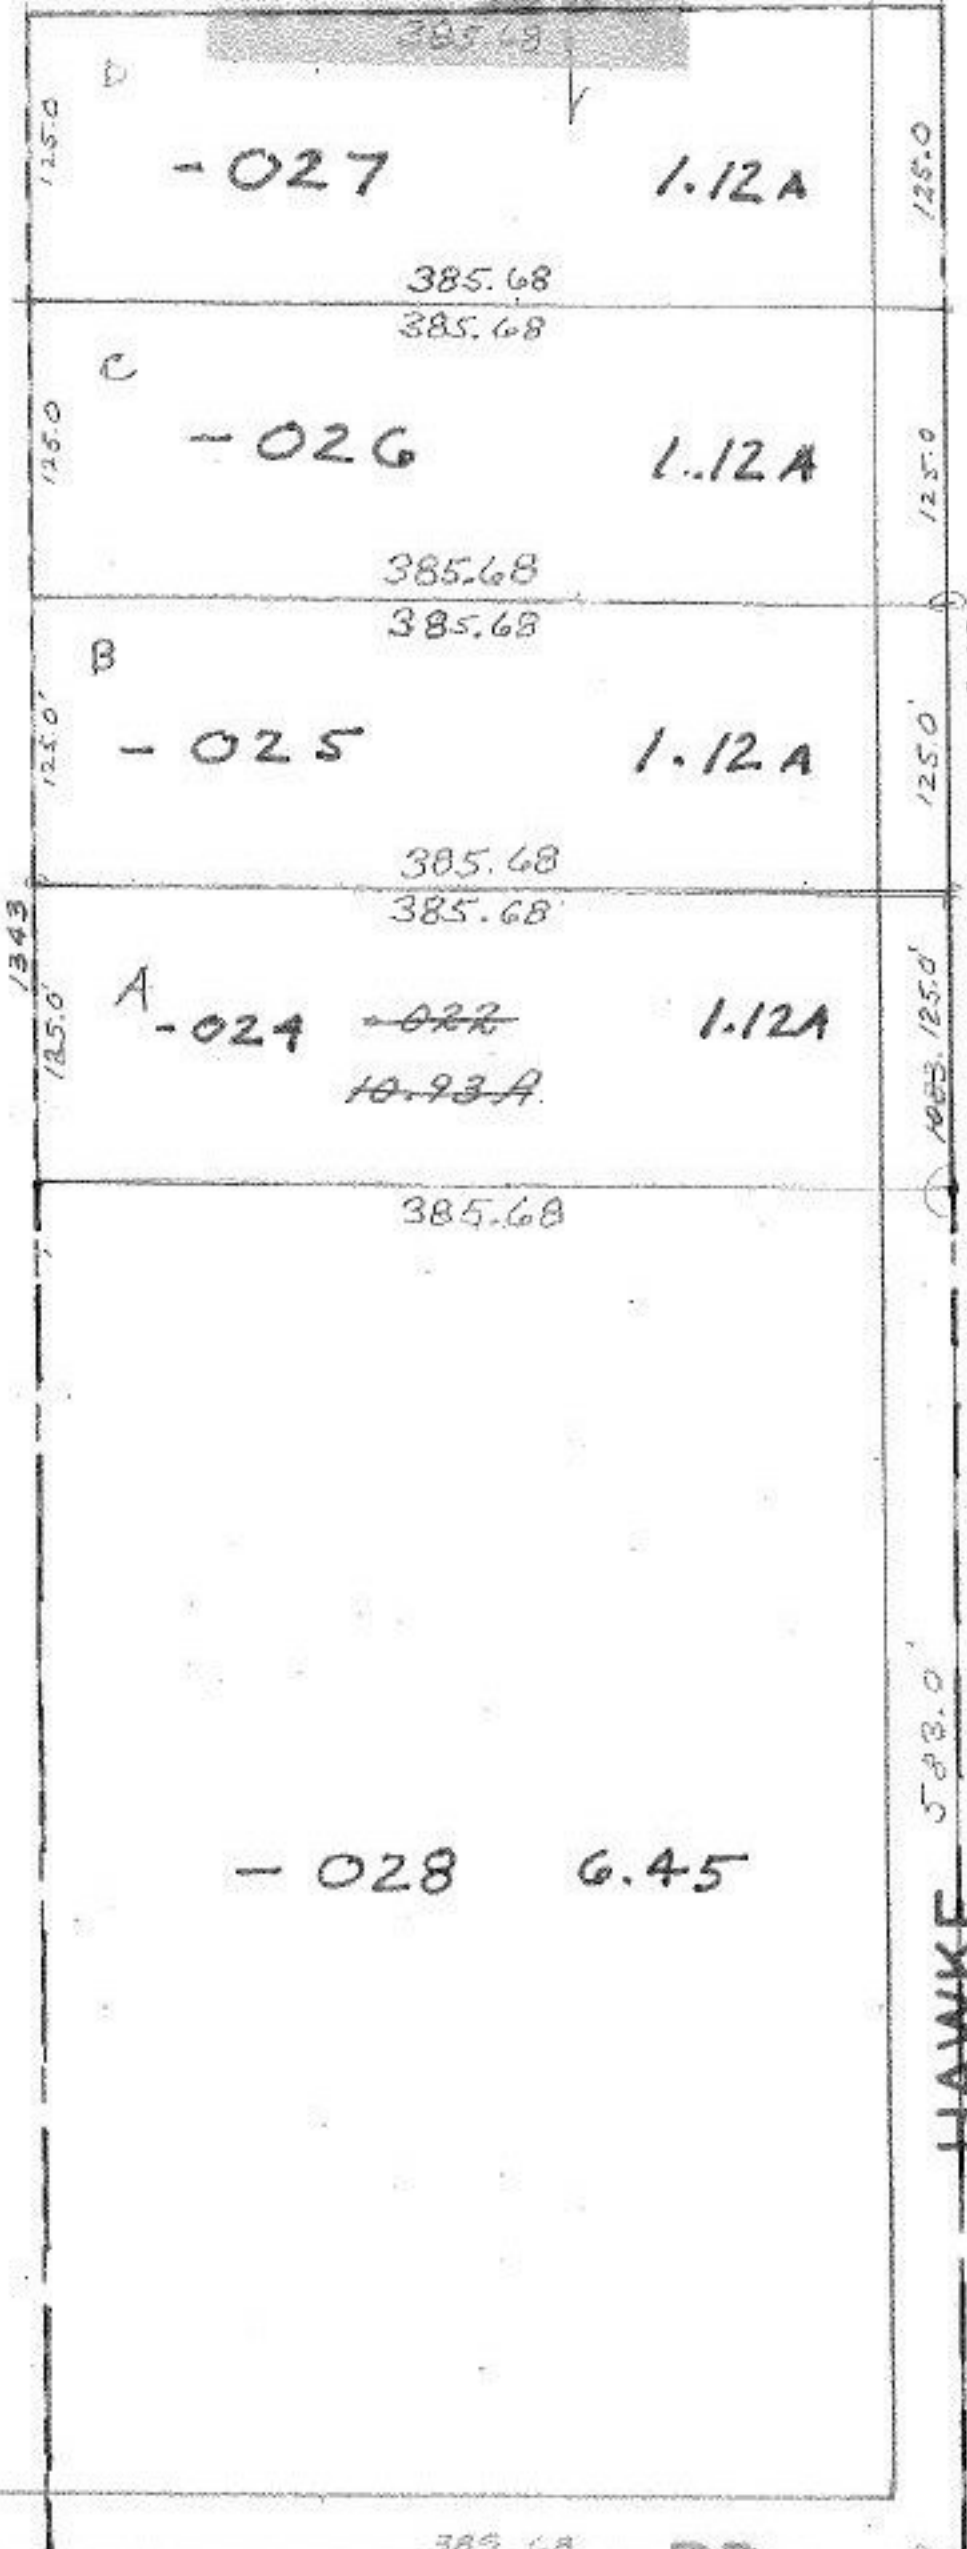

012  
9.24A.

0.59A.  
264

958

833

708

583

#11283

APPROVED  
LORAIN CO.  
MAP DEPT.

DATE 12-16-77

PAGE 11-00-006 B

BY T. McLean

VOID AFTER

C, F  
12-22-77

163

385.68

DD