


11285
10-78

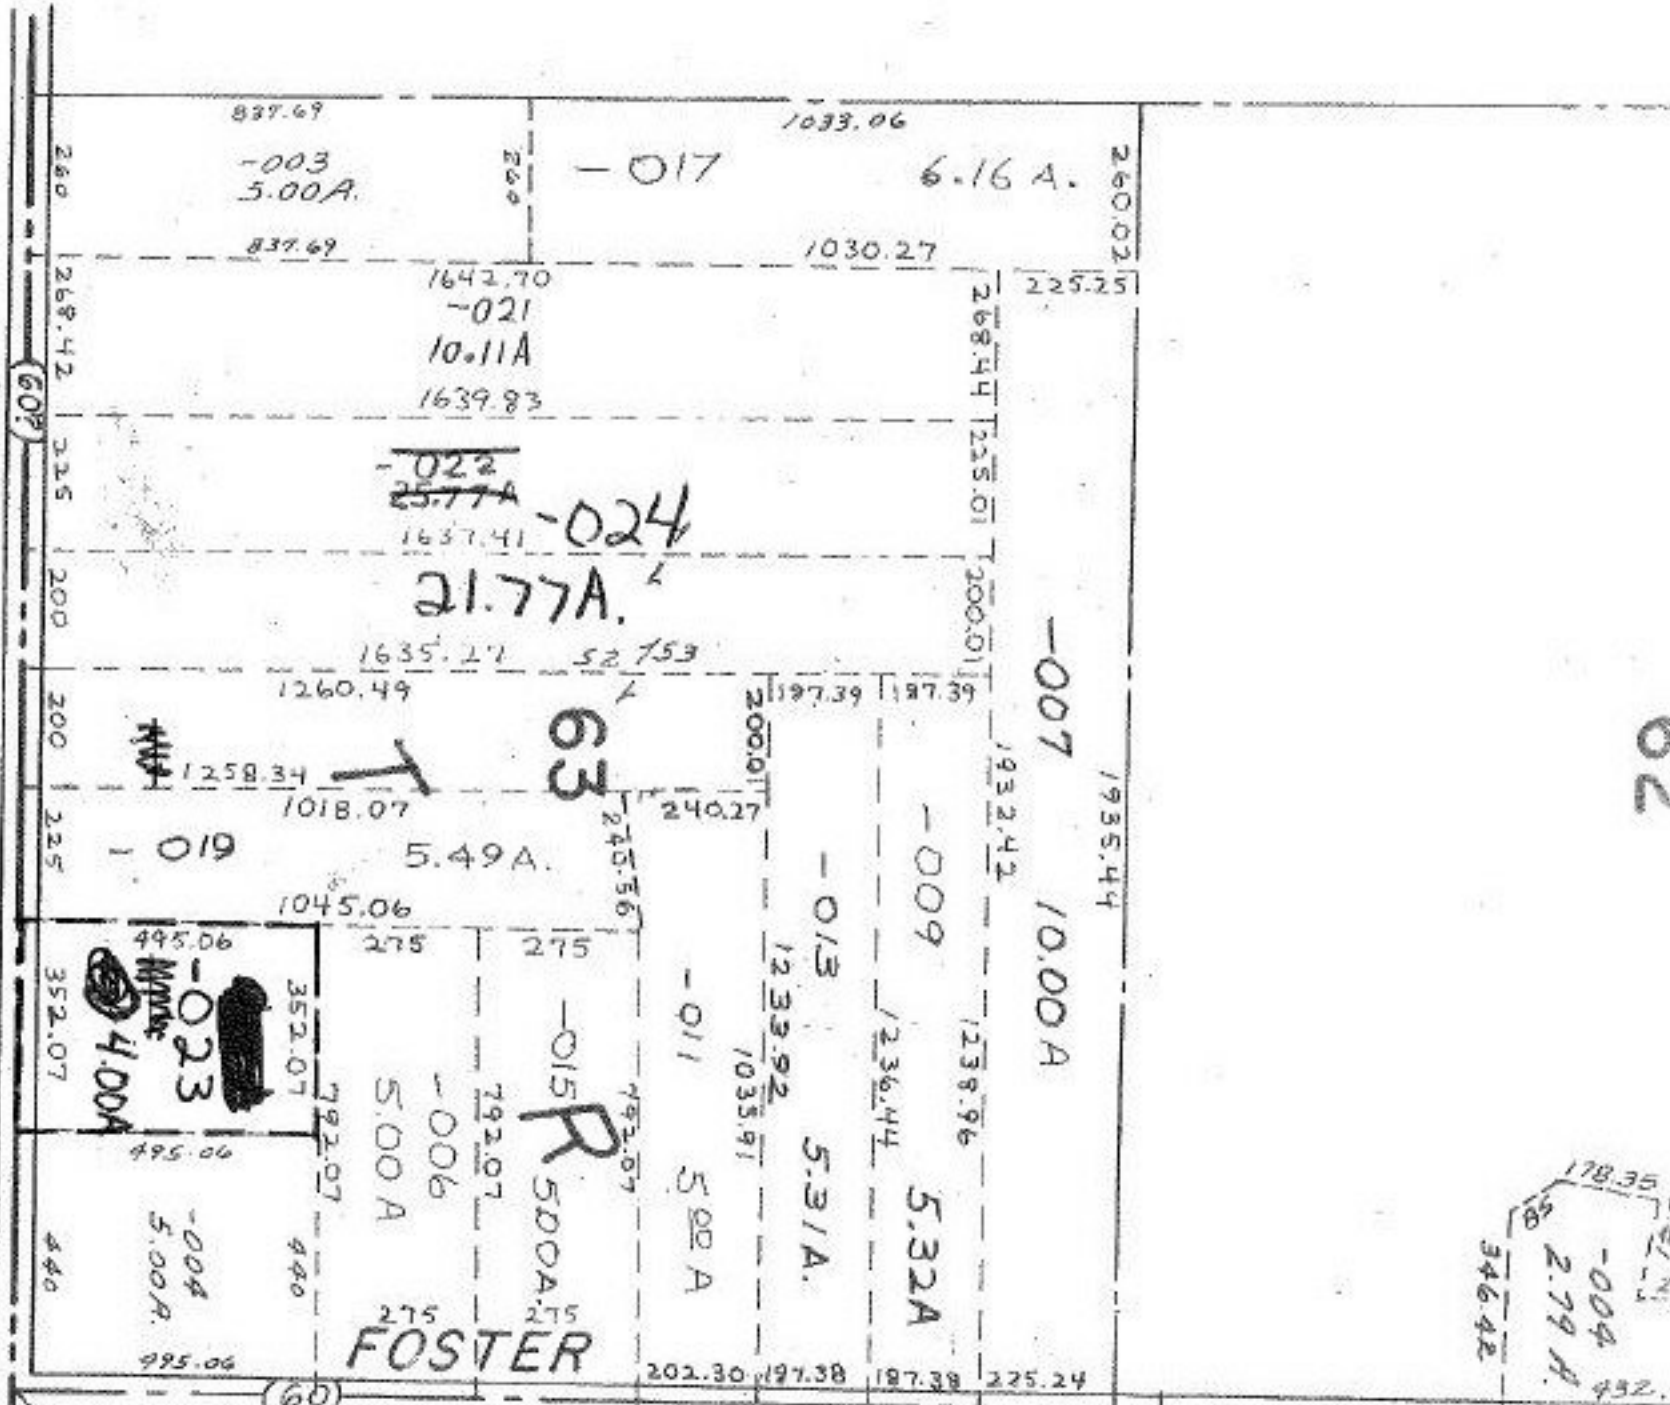

PENFIELD TWP.
SCALE: 1" = 400'

APPROVED
LORAIN CO.
MAP DEPT.
DATE 12-13-77
PAGE 19-H
BY M. Smith
VOID AFTER 11285

A11285

DEC 15 1977
47.93
12-15-77
J.H.

178.35
-004
2.79 A.
346.42