


11292

88

10⁰/₄ RD

49.88
46
49.42

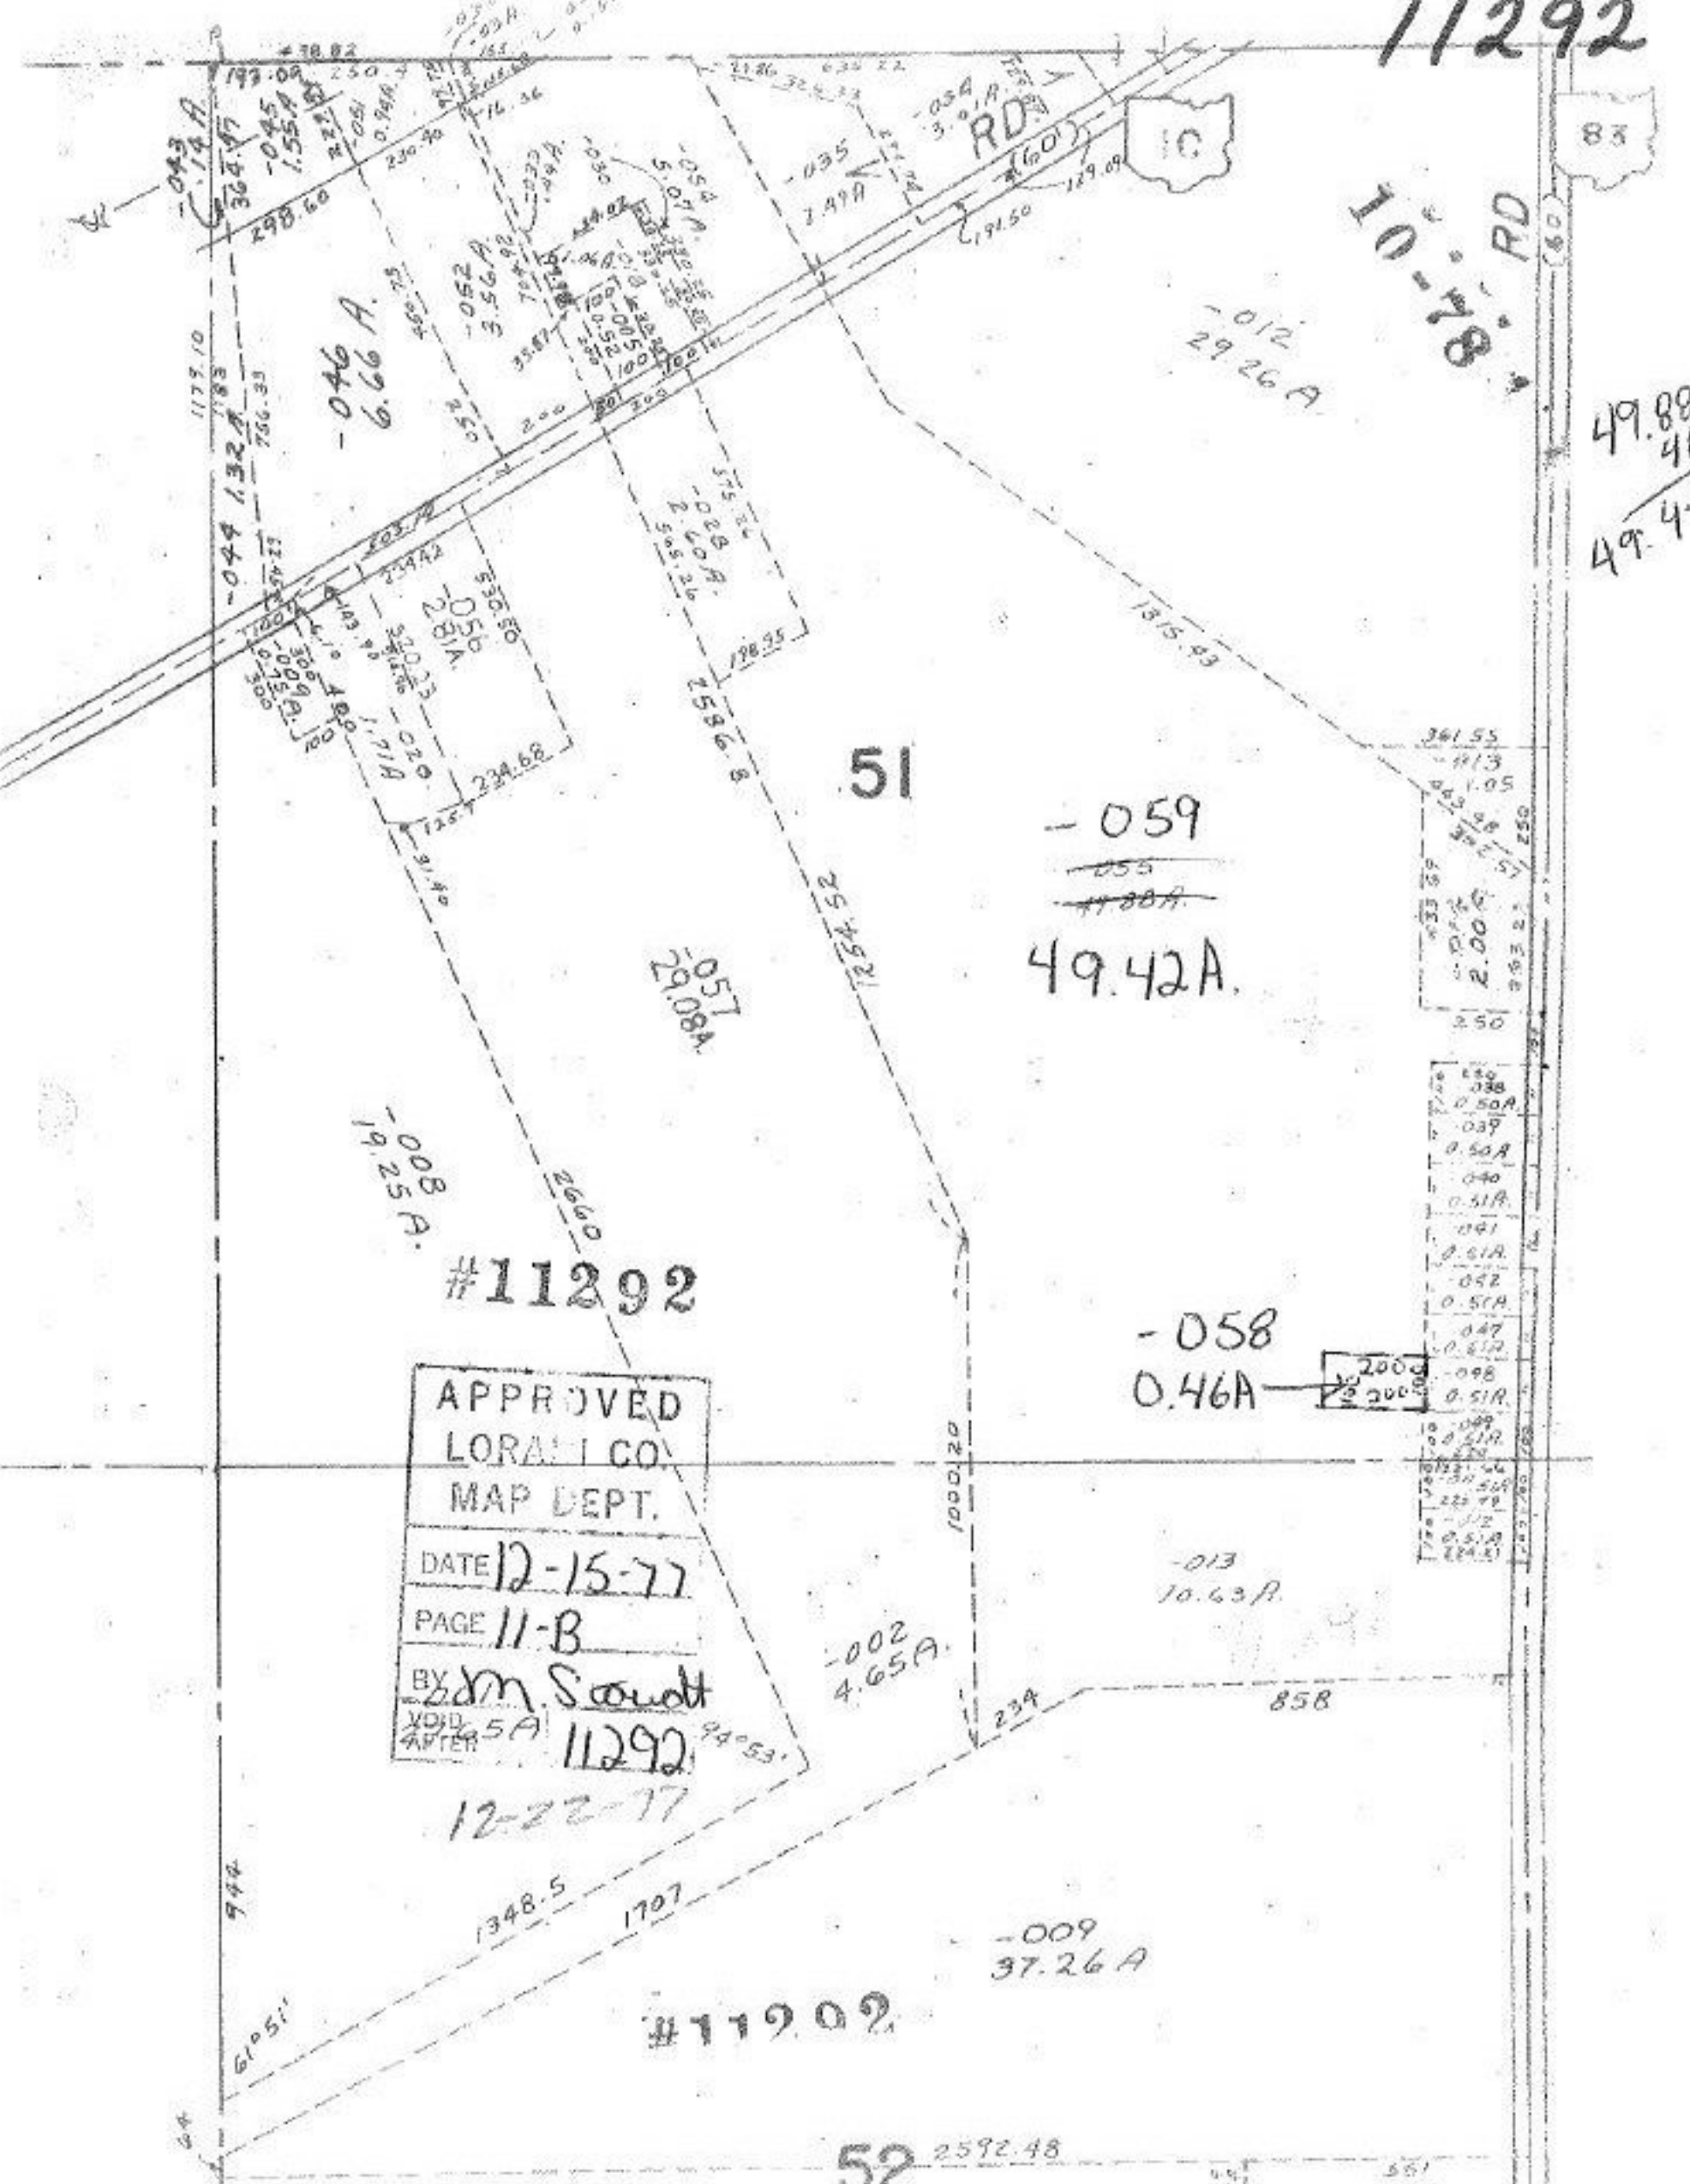

#11292

APPROVED
LORAIN CO.
MAP DEPT.
DATE 12-15-77
PAGE 11-B
BY Edm. Scowett
VOID AFTER 5A 11292

12-22-77

#11202

52 2592.48