


11298
10-78

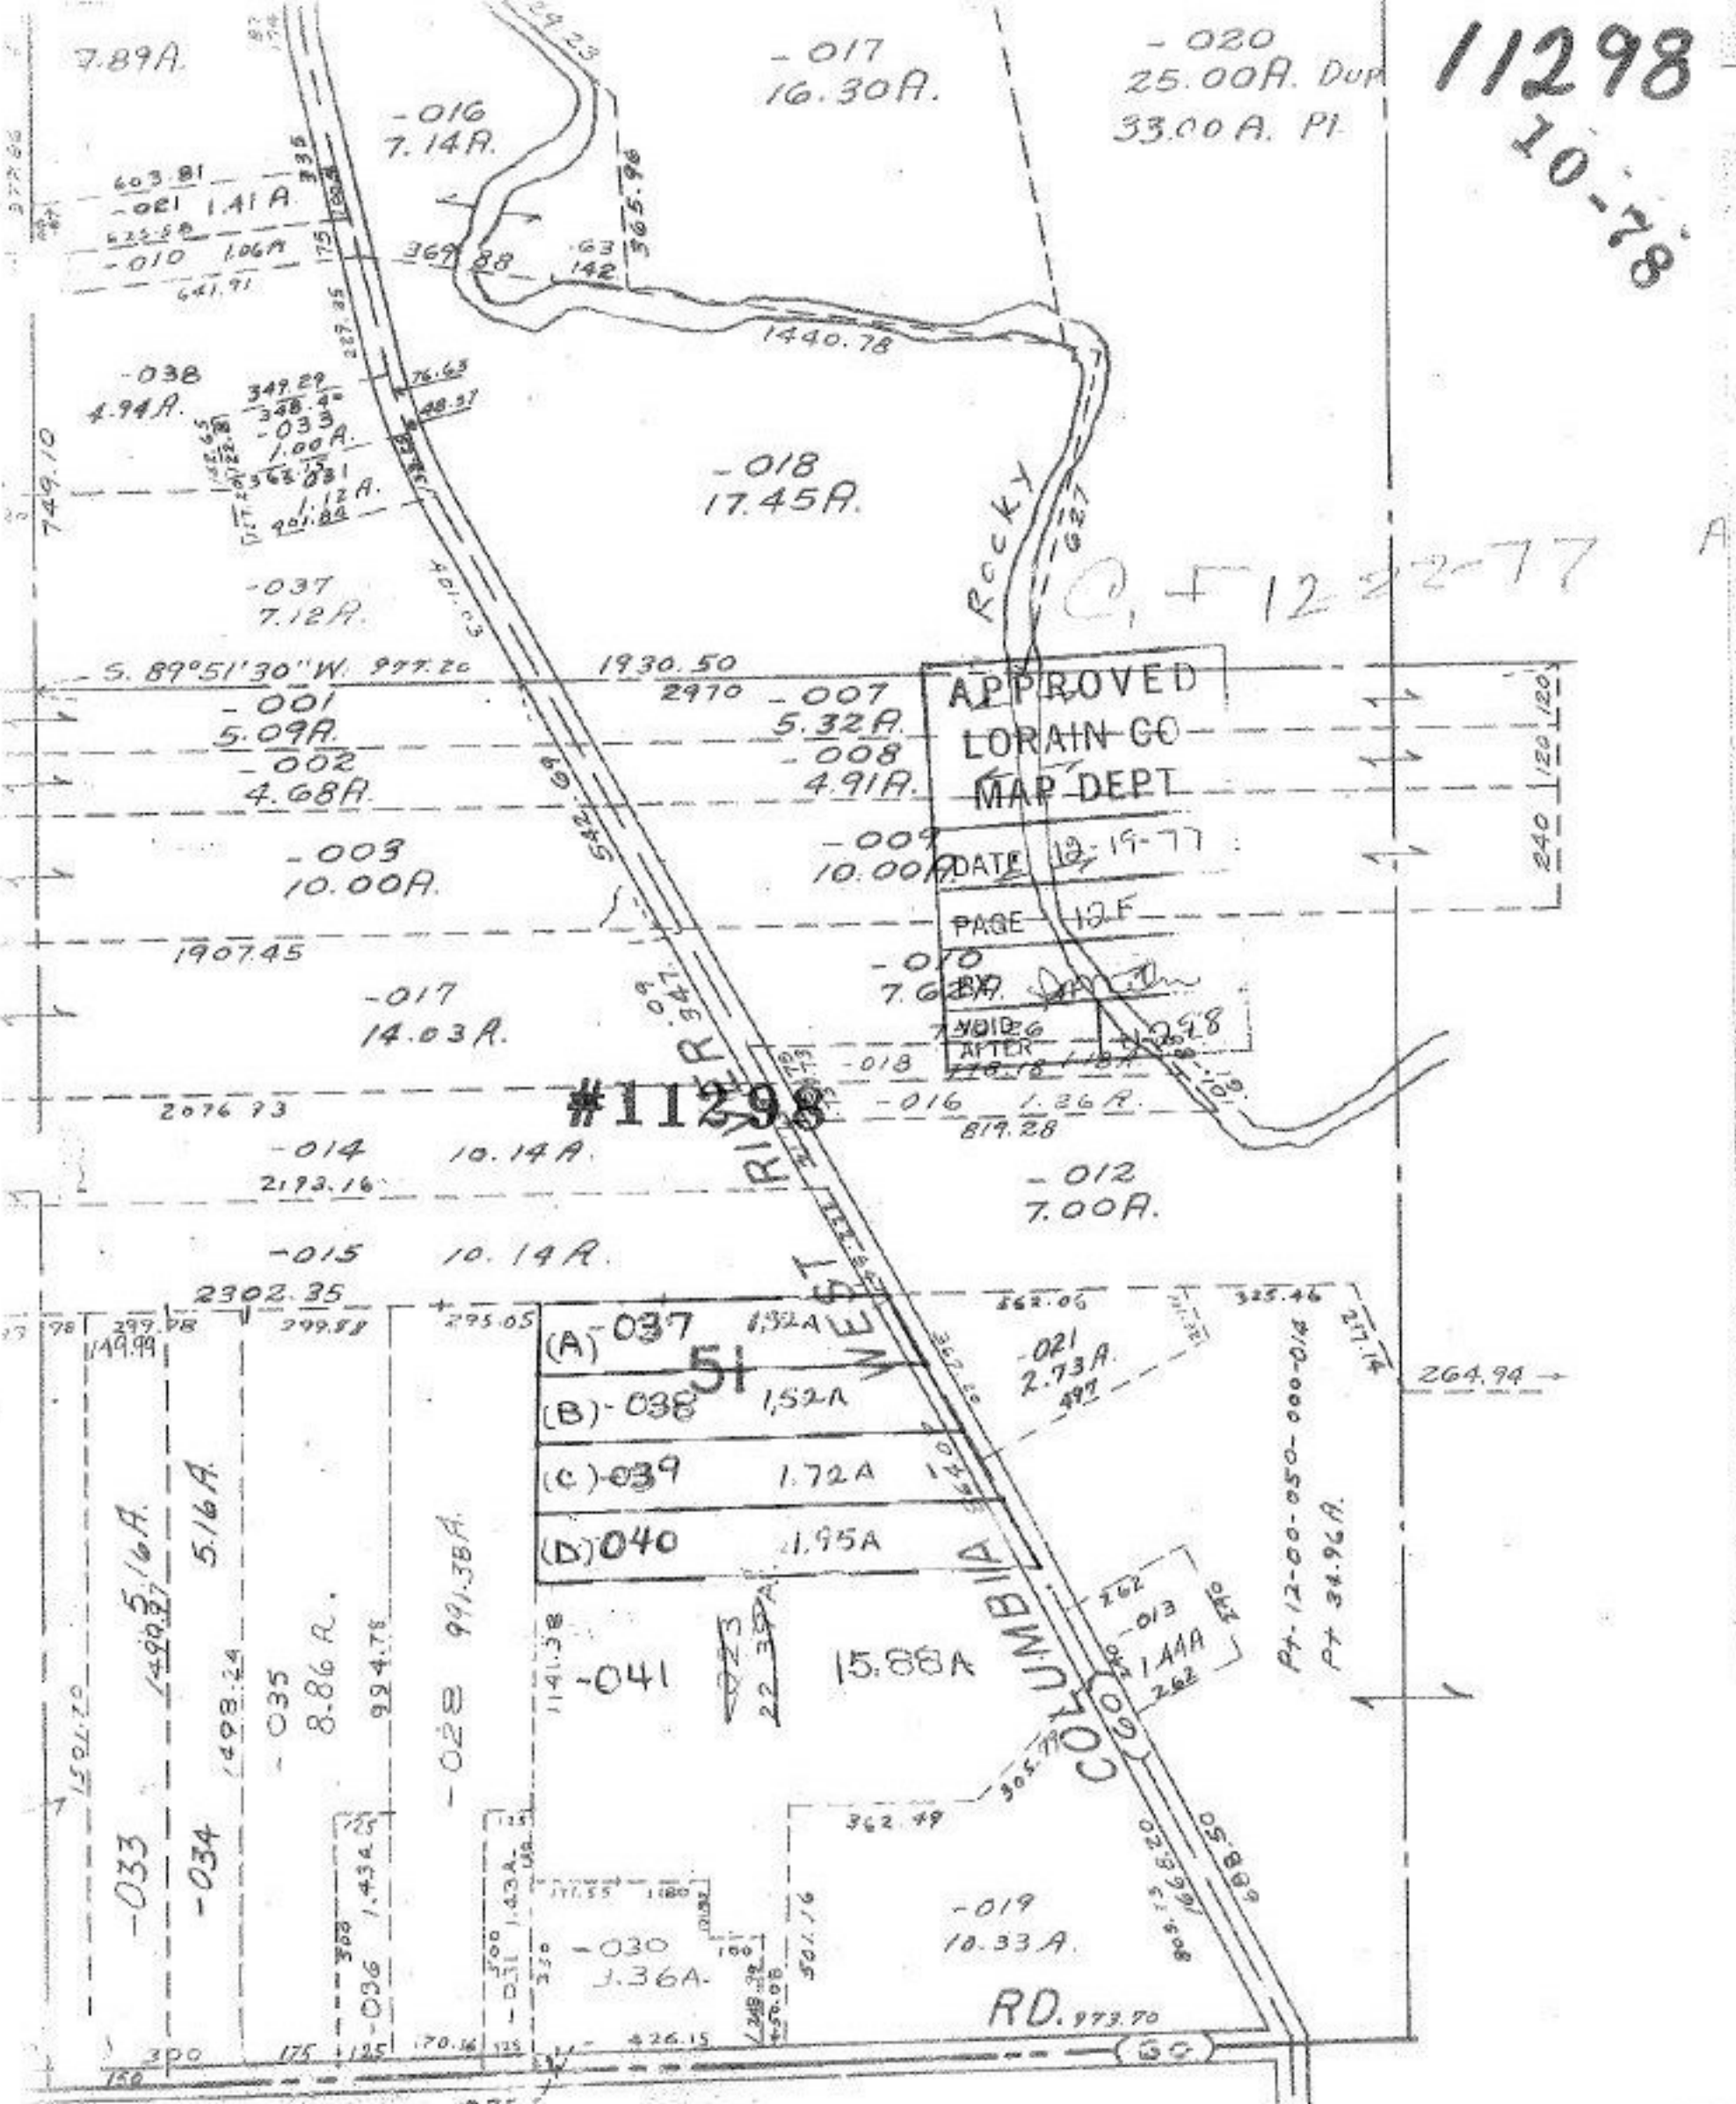

LOTS 51 THRU 55, 66 THRU 70