


STREET GARGASZ DEDICATION

URBAN CIRCLE SOUTH

R FOSTER PARK RD.

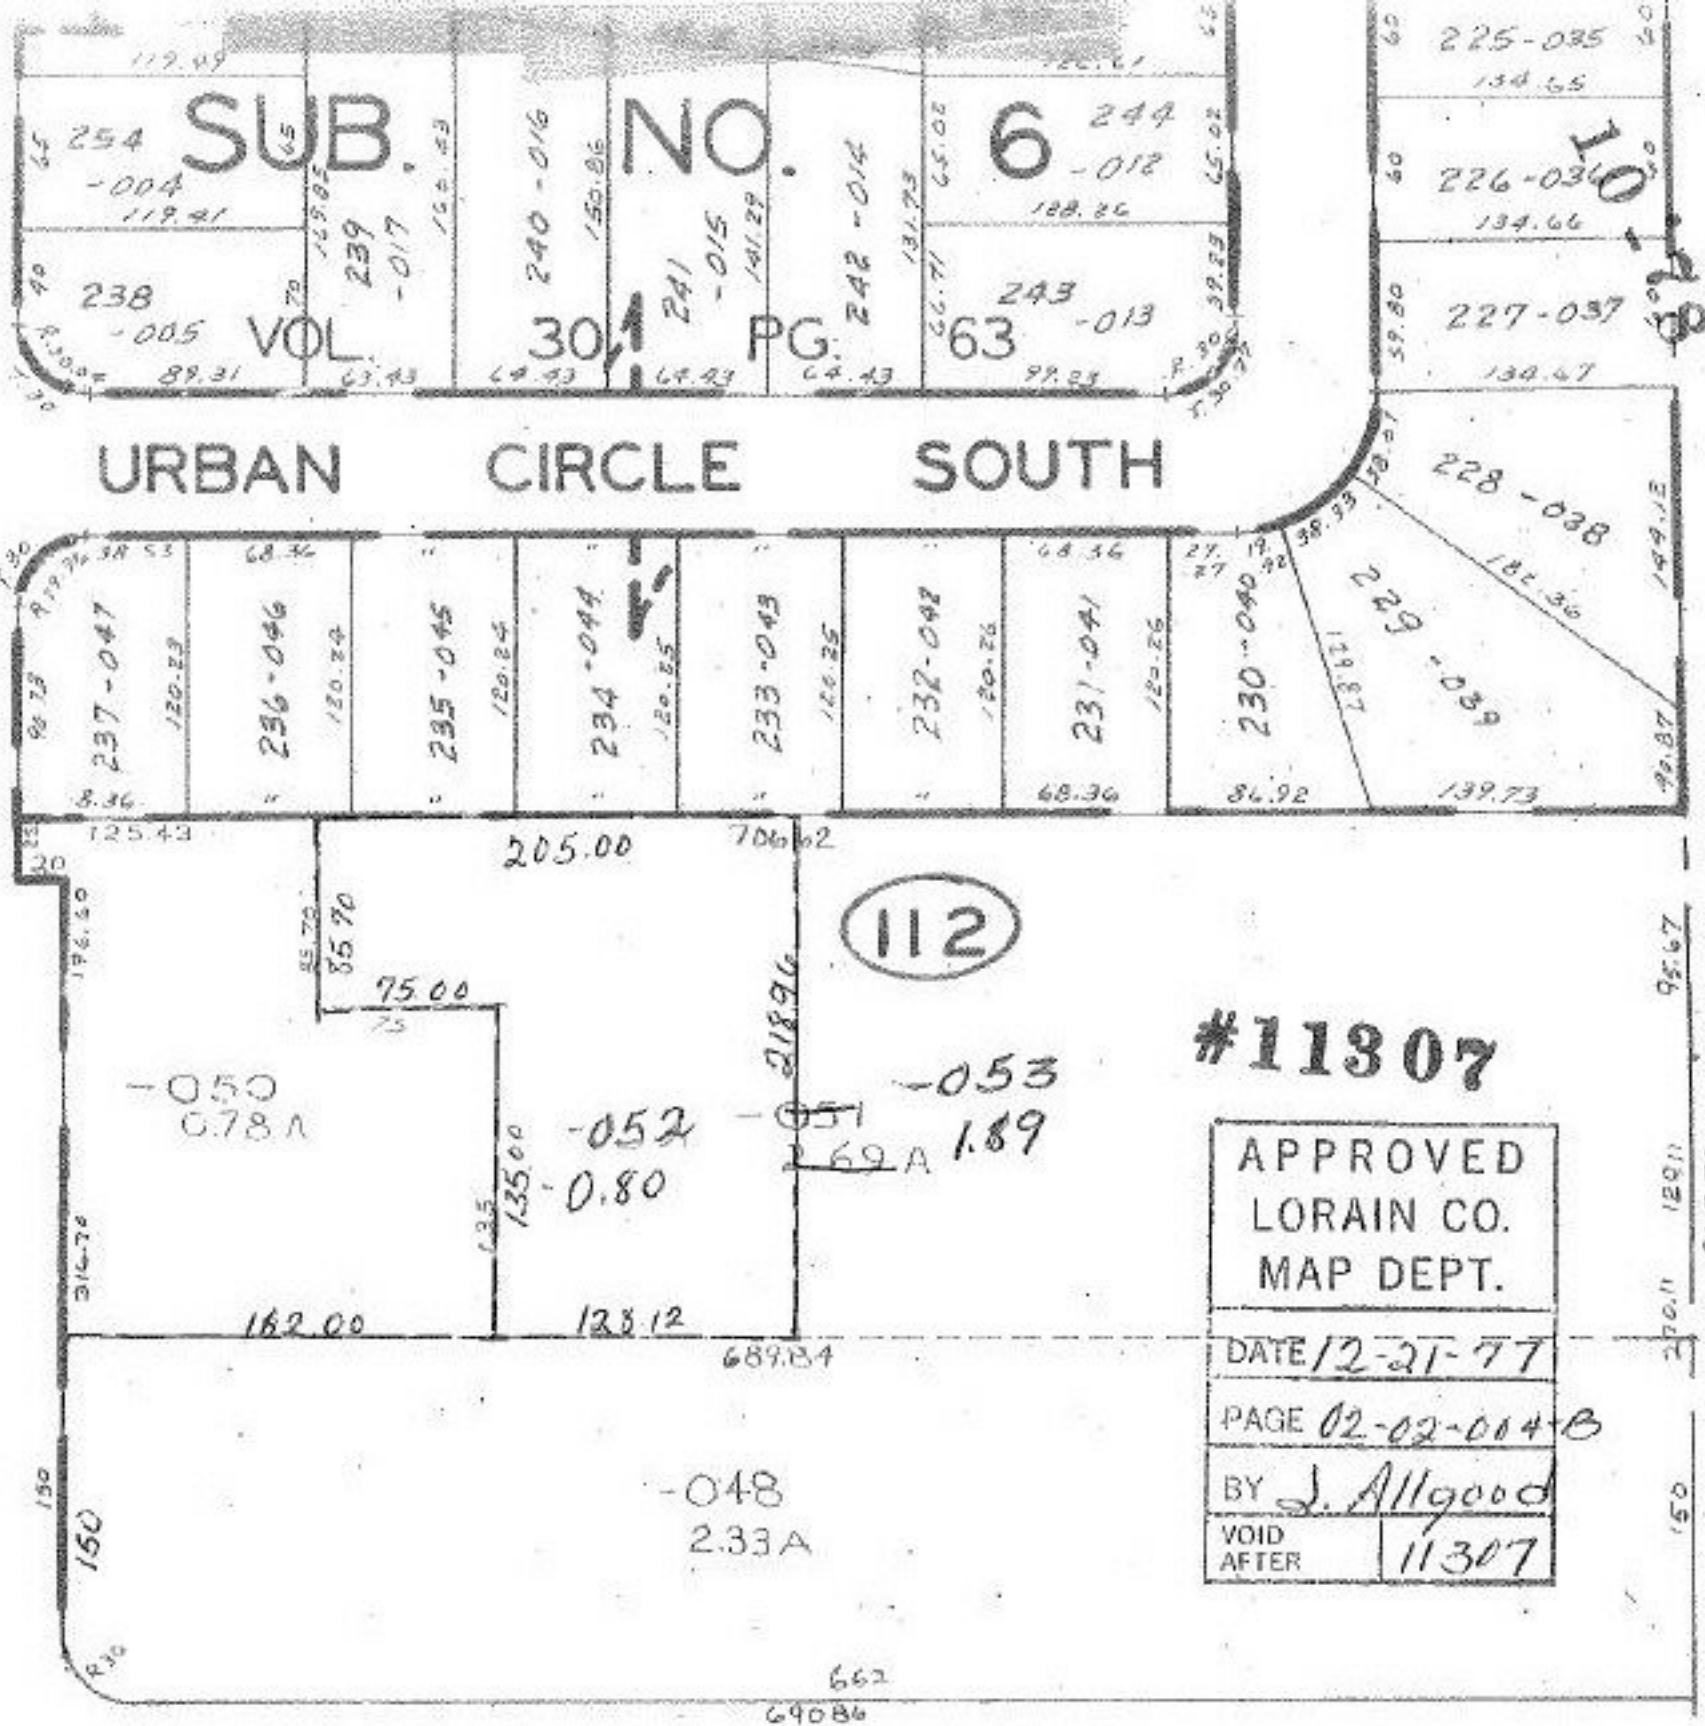

#11307

APPROVED LORAIN CO. MAP DEPT.	
DATE 12-21-77	
PAGE 02-02-004-B	
BY J. Allgood	
VOID AFTER	11307

#11307

#11307

WP

TRACT 2