

APPROVED  
LORAIN CO.  
MAP DEPT.

DATE 12-30-77

12-30-77

PAGE 01-00-73


J.A.

BY *Dr. [unclear]*

VOID AFTER 11/30/80

SEE

11308

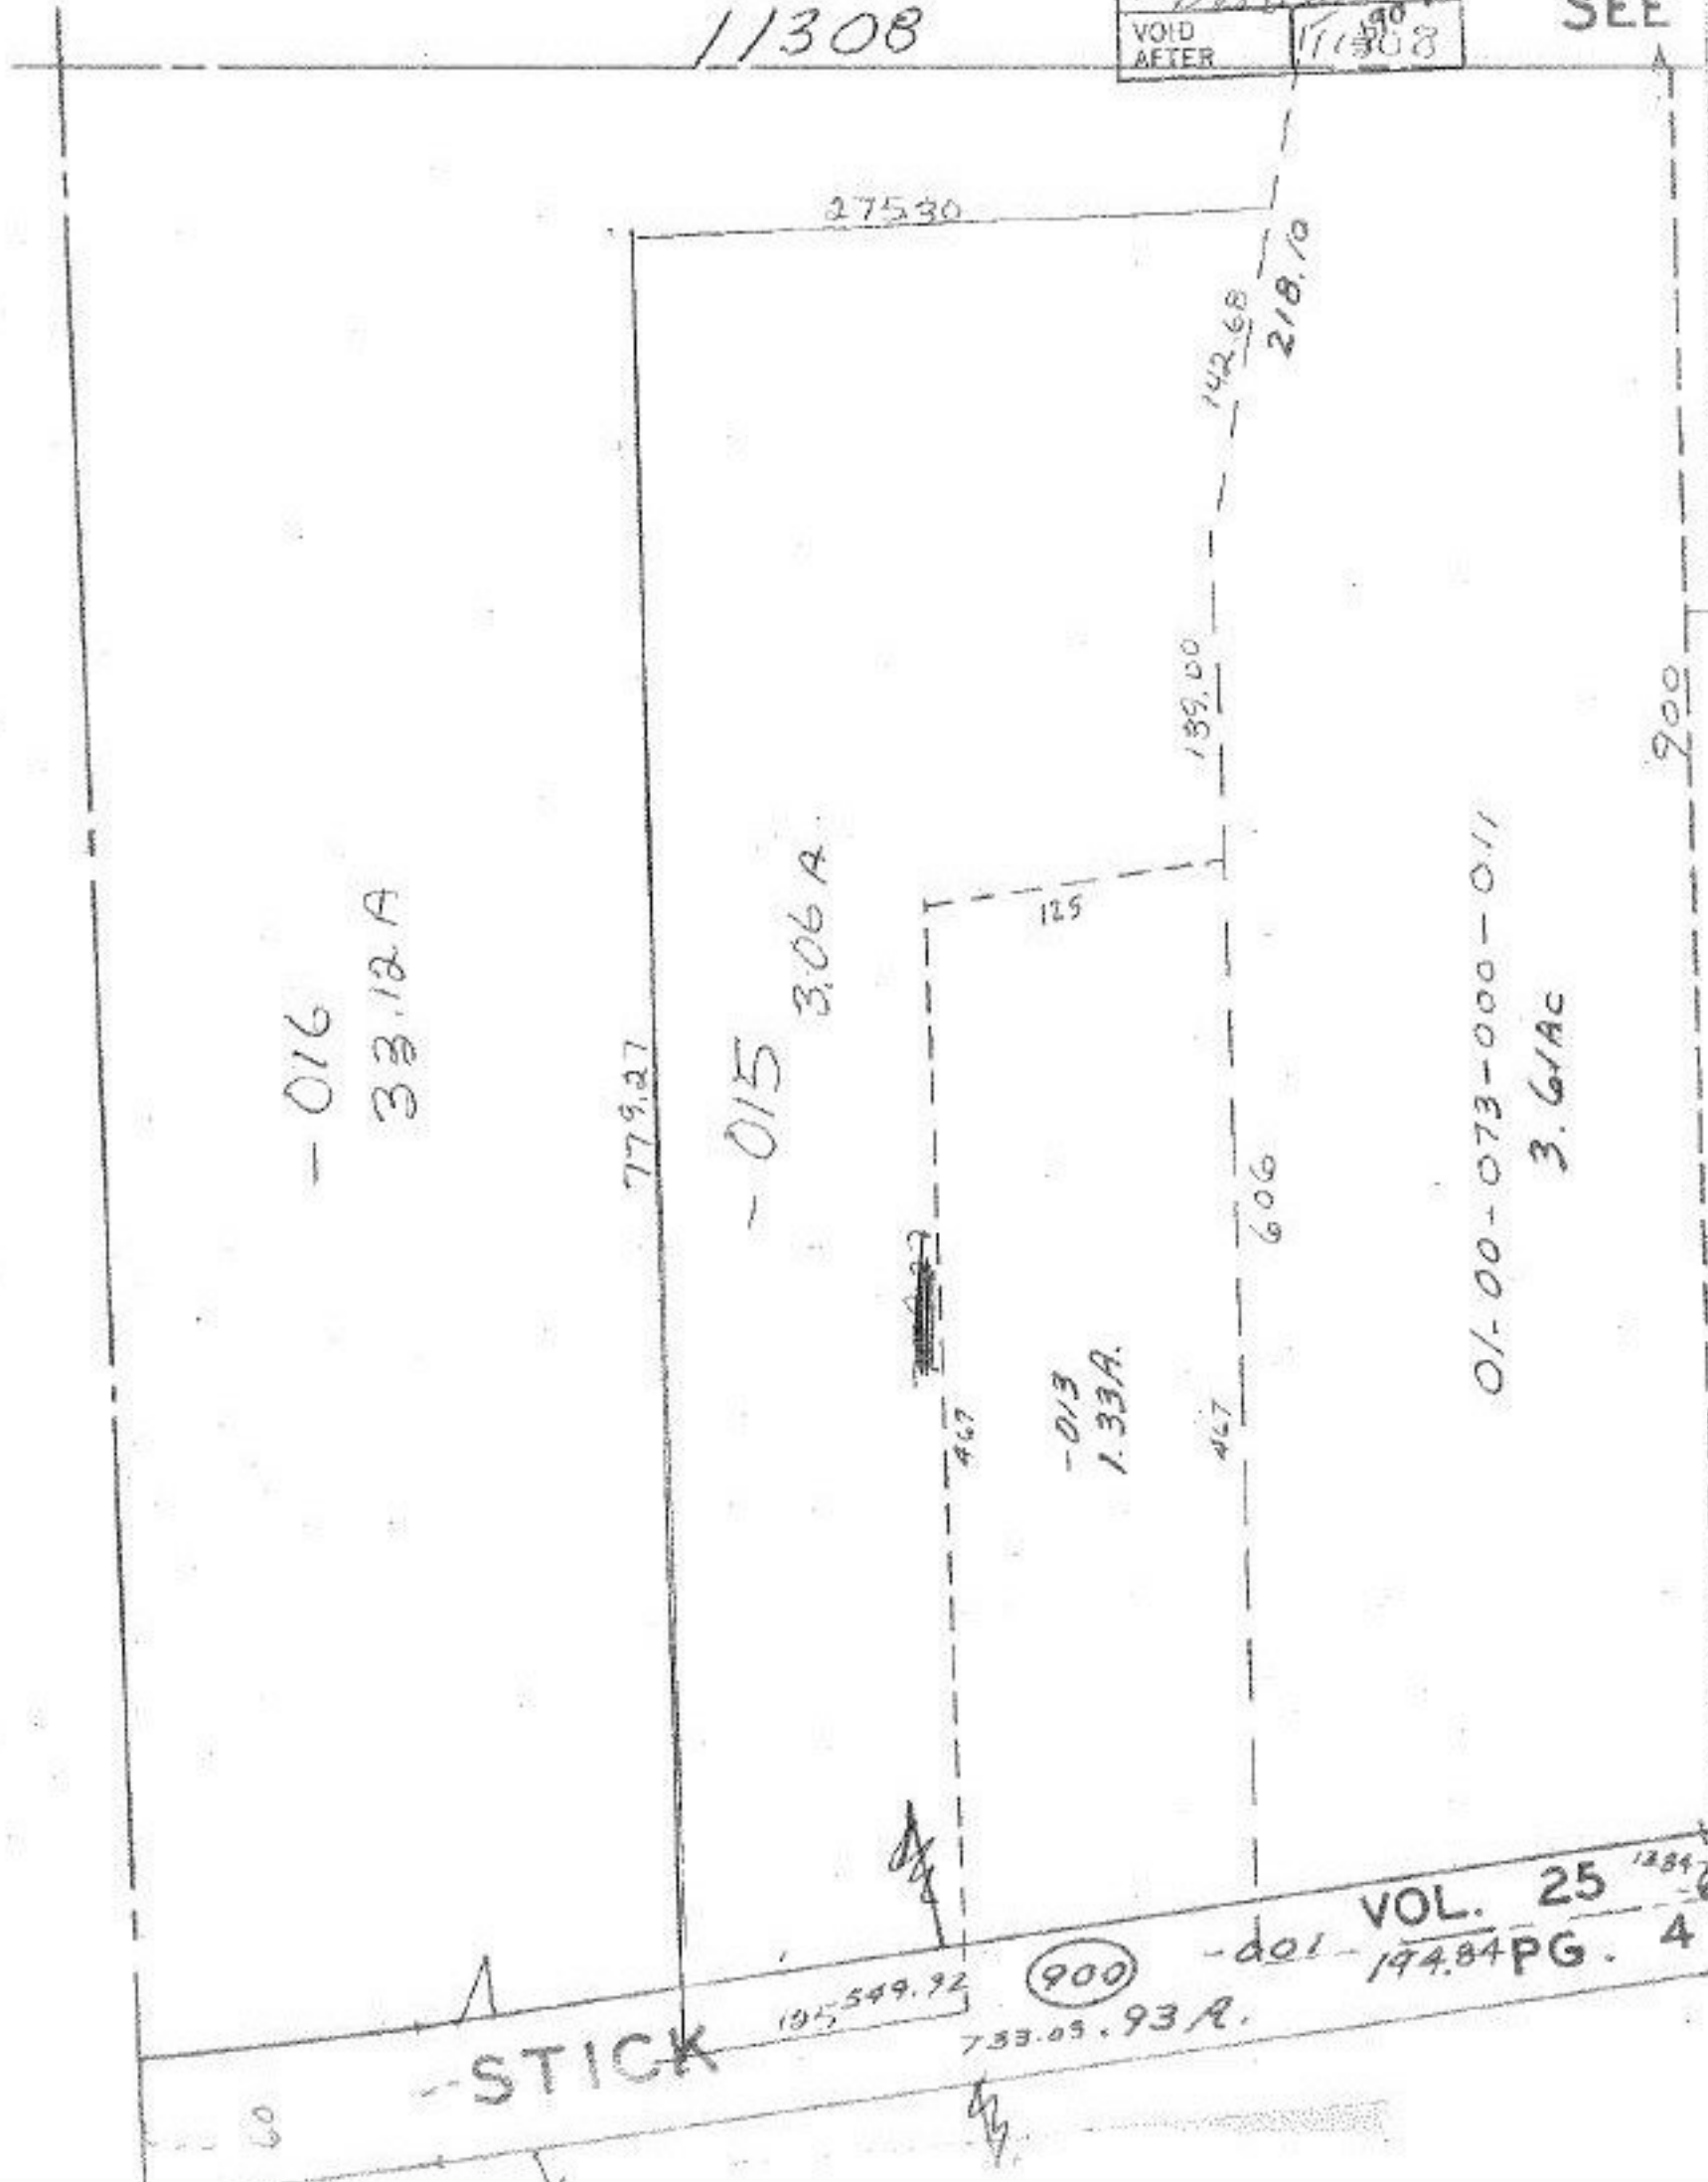

STICK

900

VOL. 25

194.84 PG. 4