


100.0007.

11319

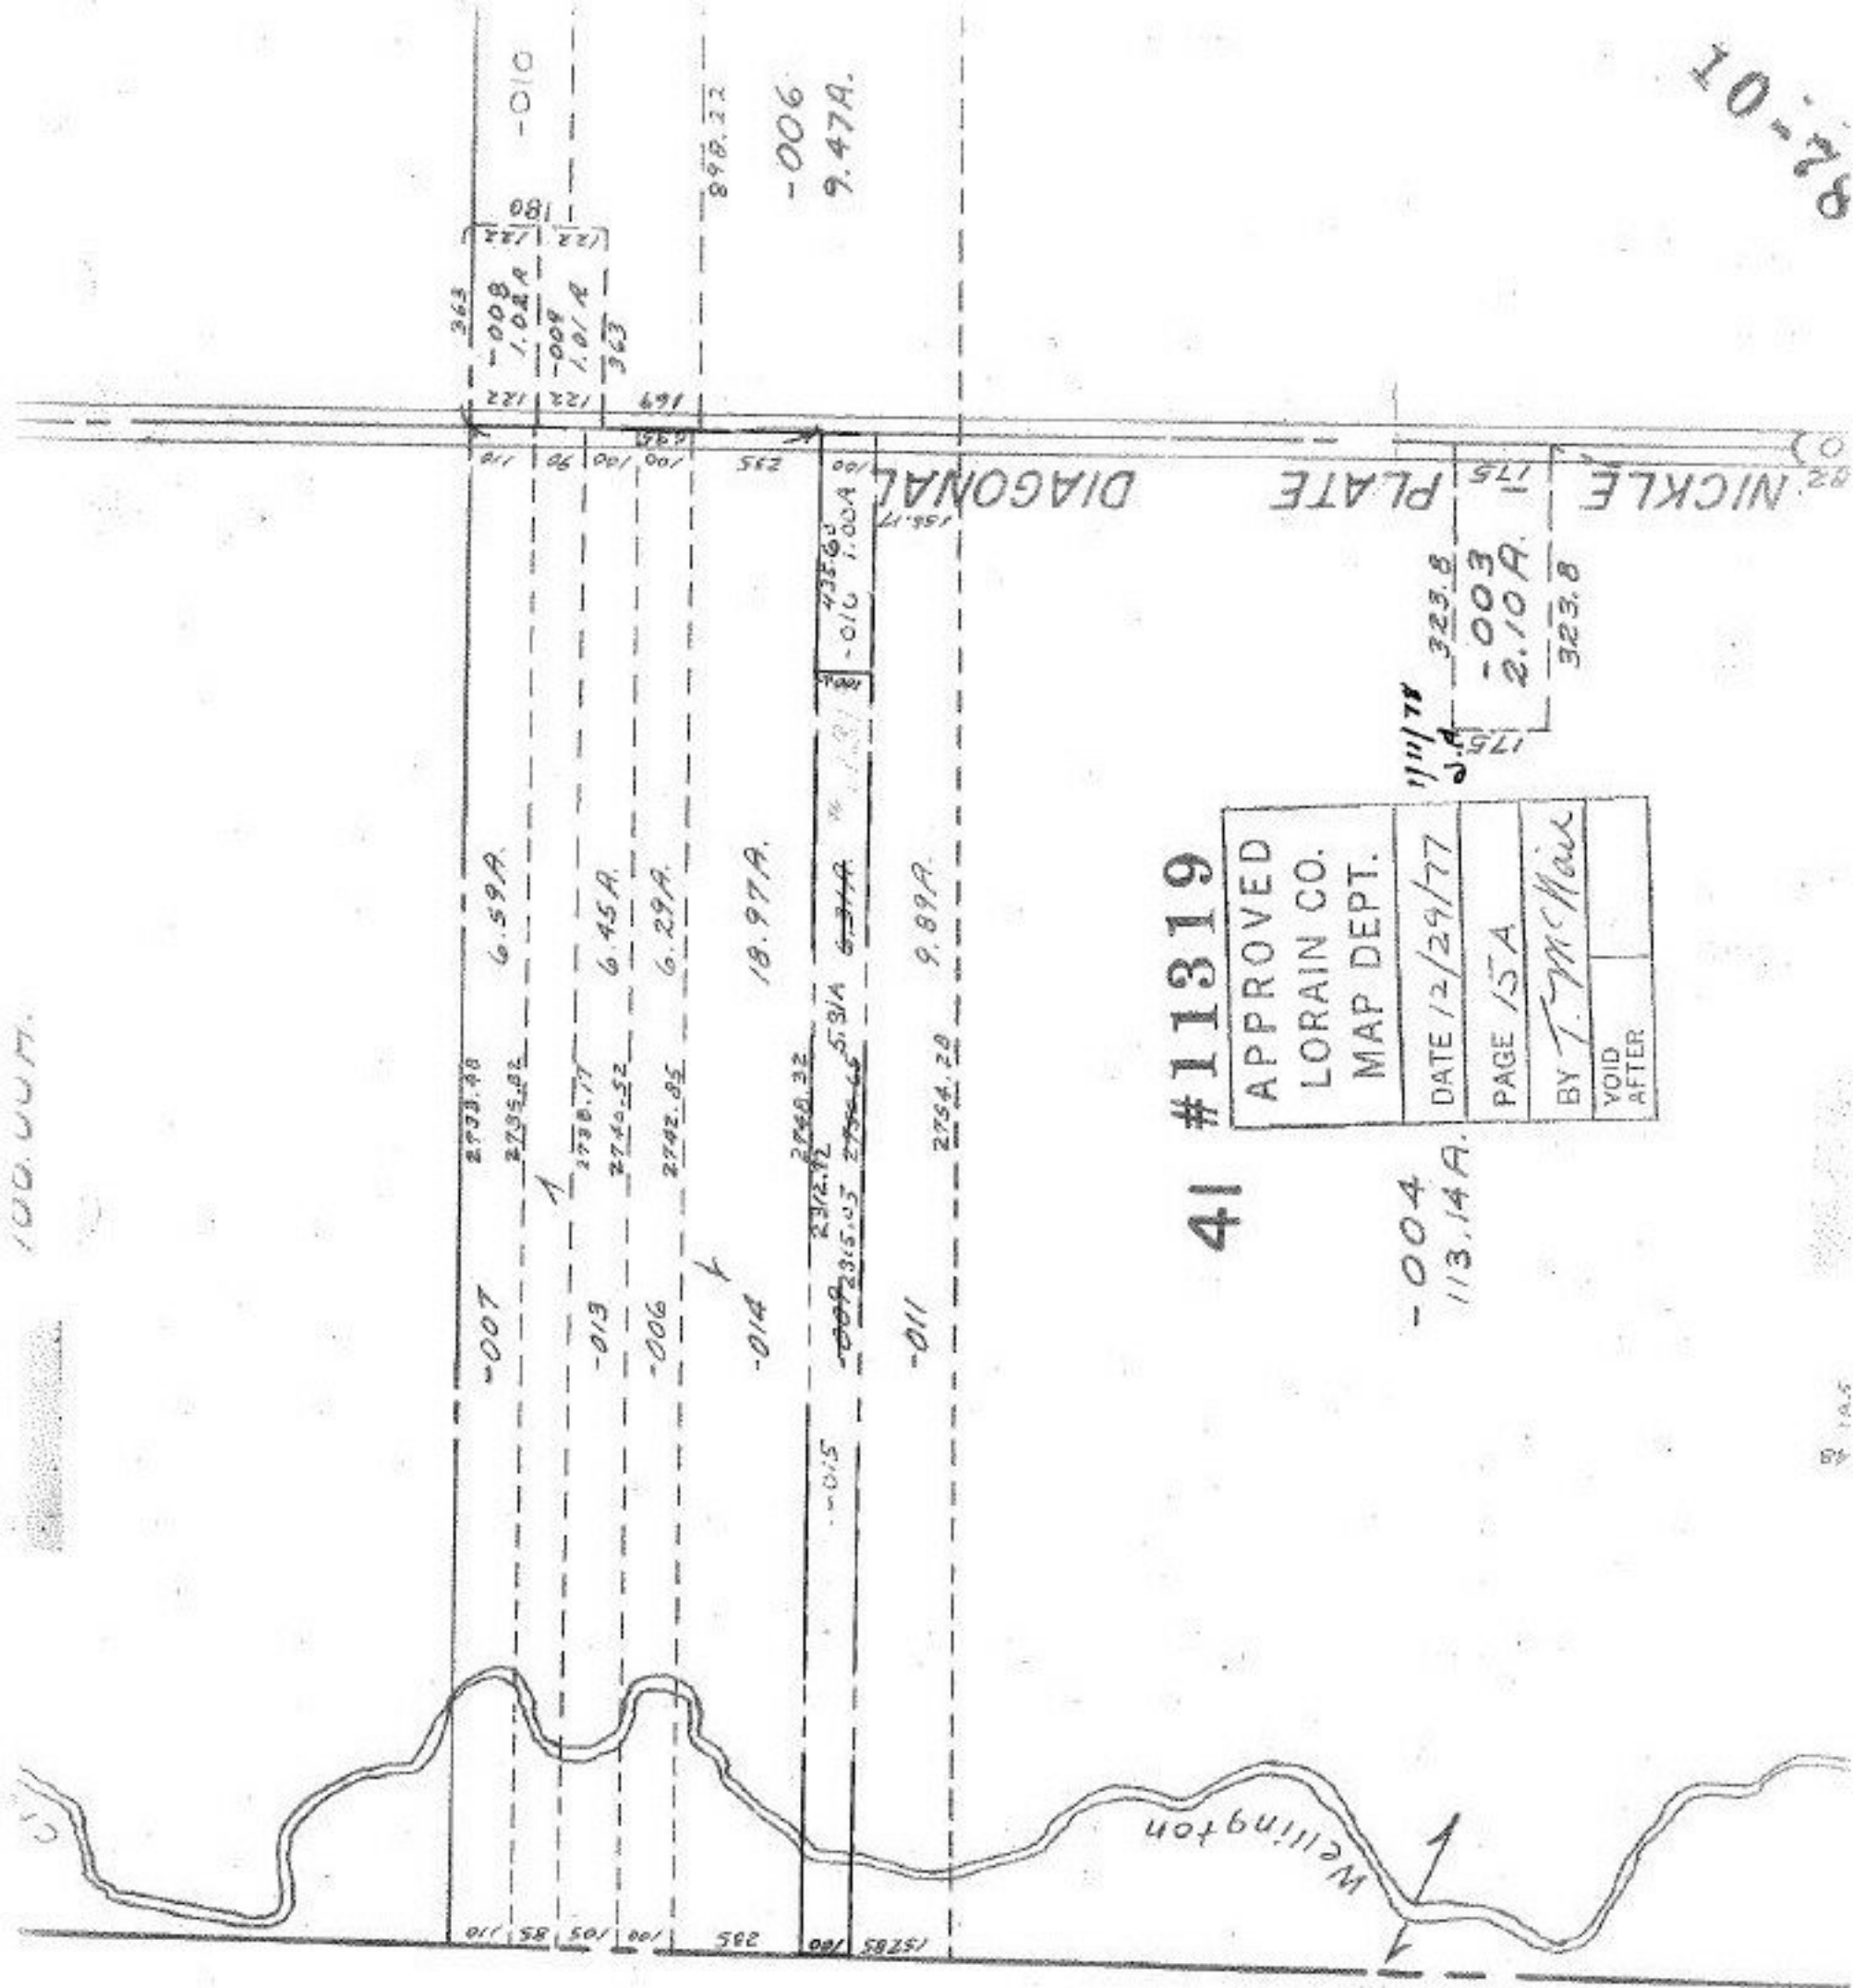

82-10-01