


C.7 1-17-1977

#11324

APPROVED	
LORAIN CO.	
MAP DEPT.	
DATE 12-22-77	
PAGE 04-00-003B	
BY D. Milner	
WENT AFTER	11324

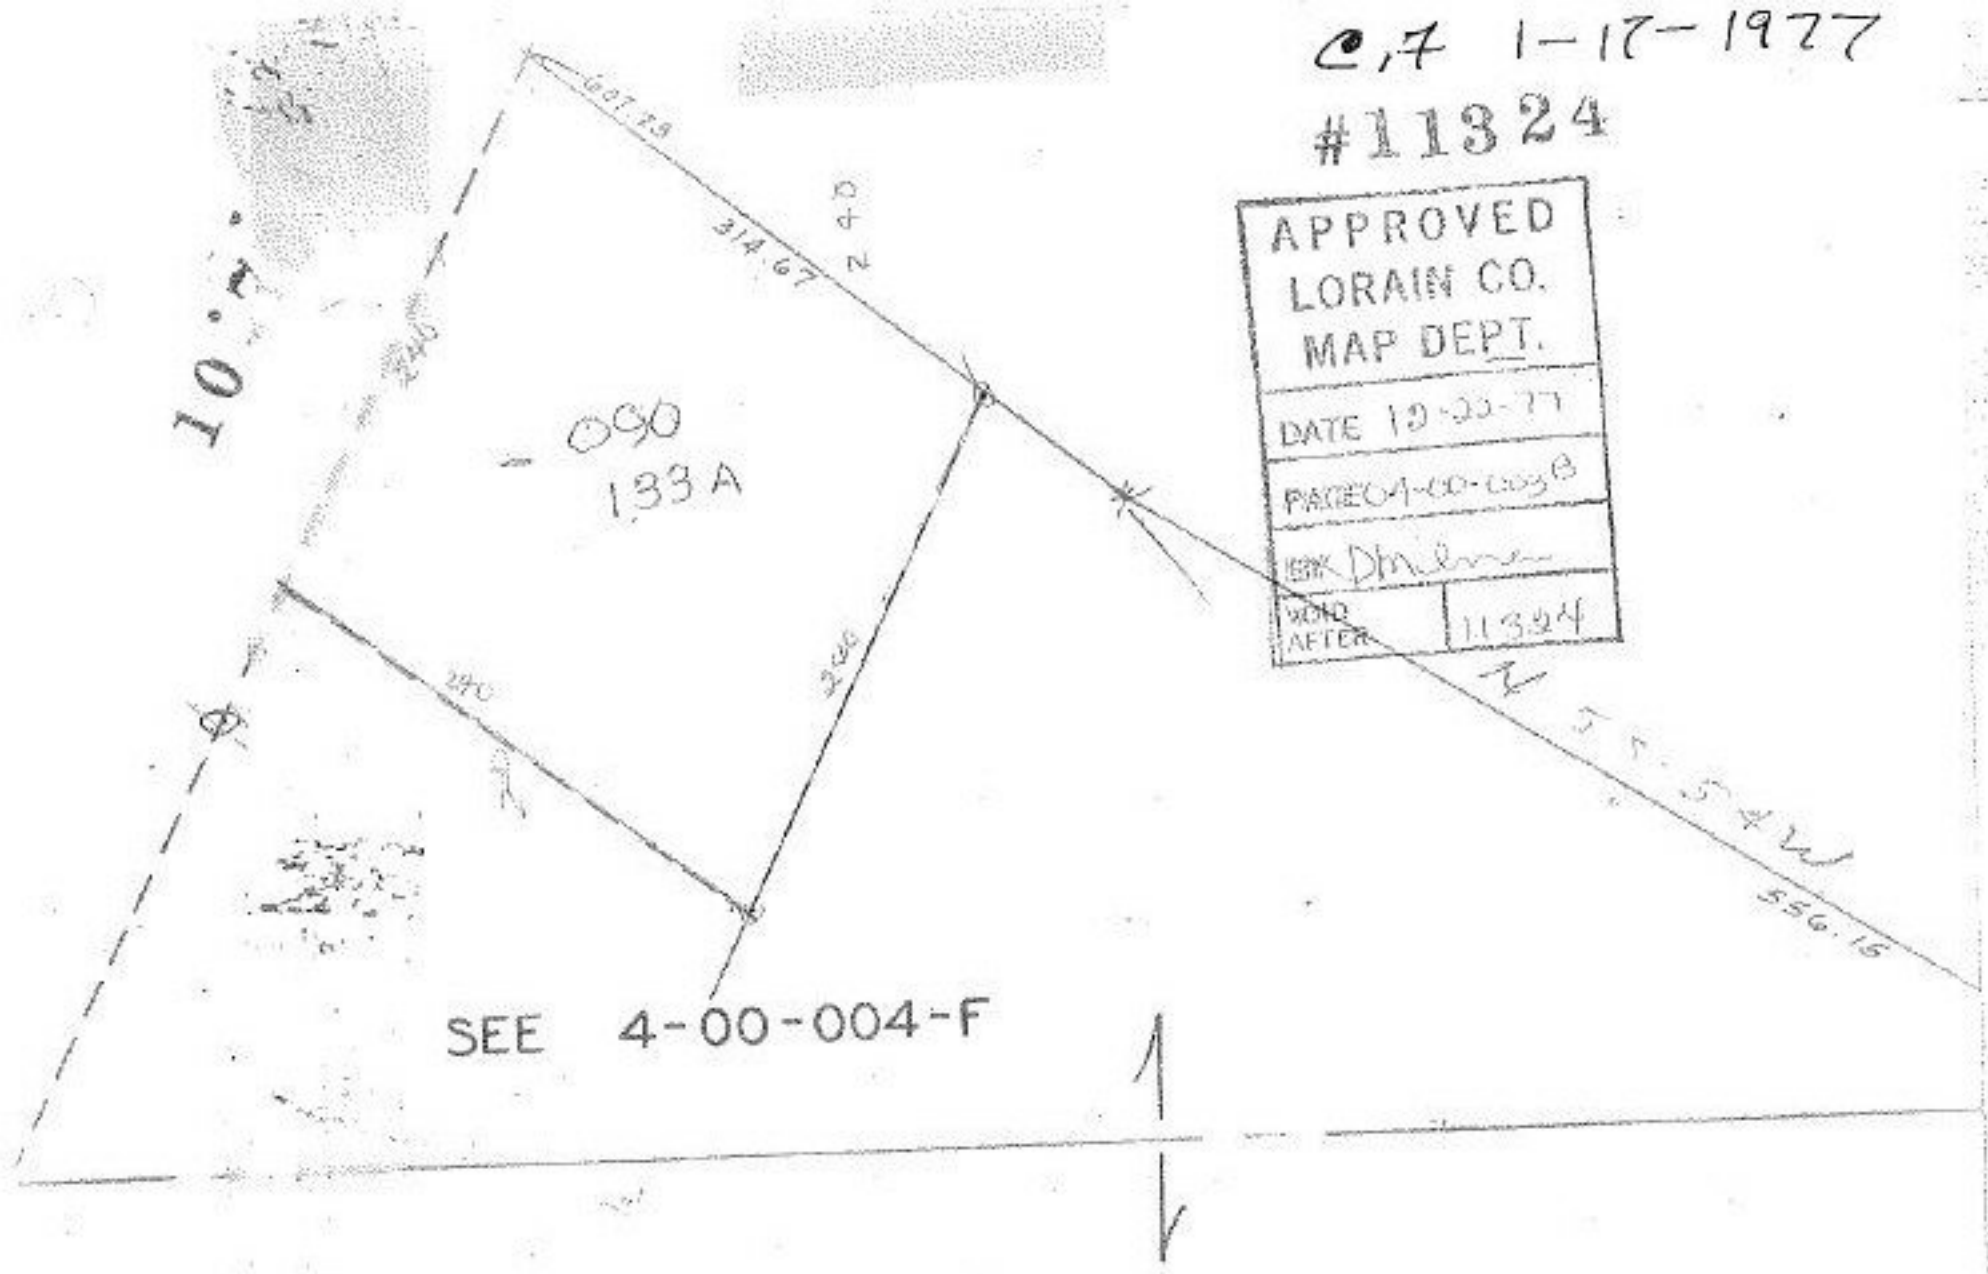

Pt - 086 - 089  
 Pt. ~~37.28A.~~ 35.90 A.