

#11353


APPROVED	
LORAIN CO.	
MAP DEPT.	
DATE 1-9-78	1/23/78
PAGE 1-B	S.A.
BY: <i>[Signature]</i>	
VOID AFTER	#11353

01-00-013-000-025

1196/349

1-6-78 Gerald + Mary Beckman

10-7-78
11353

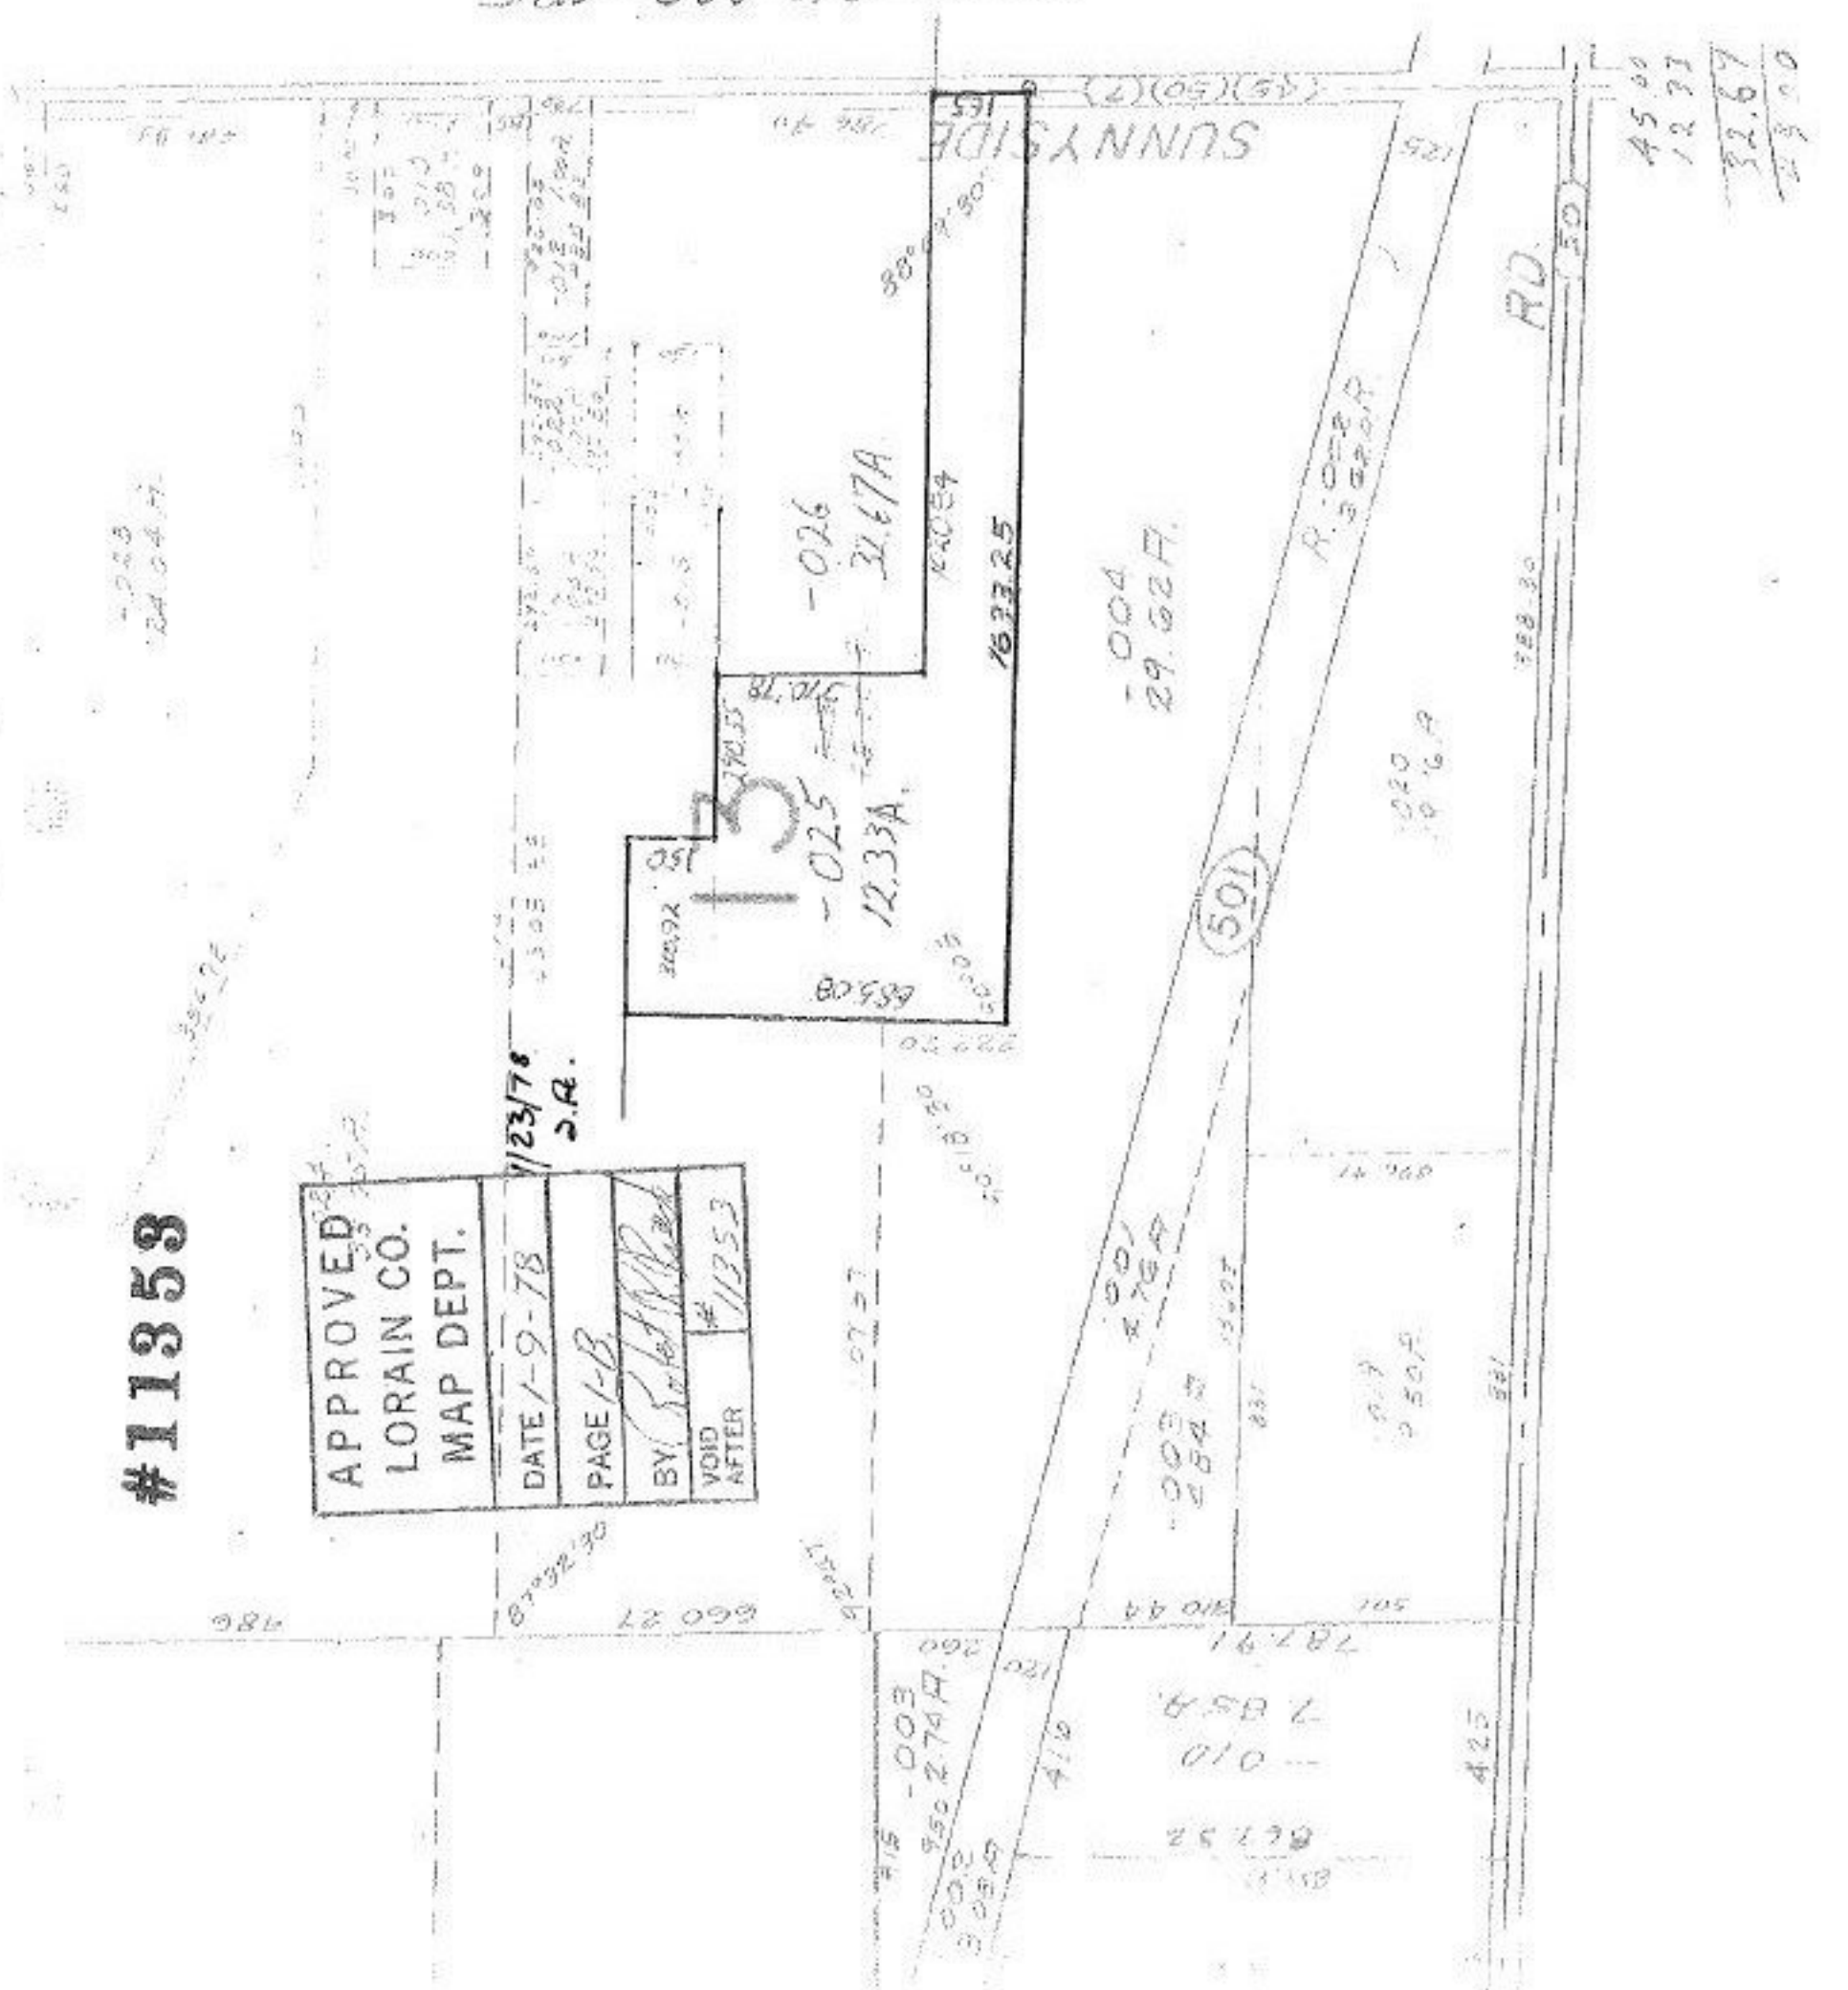

45.00
12.71
32.67
22.00