


SEE 9-00-083-A

11357

425

275

87-01-18

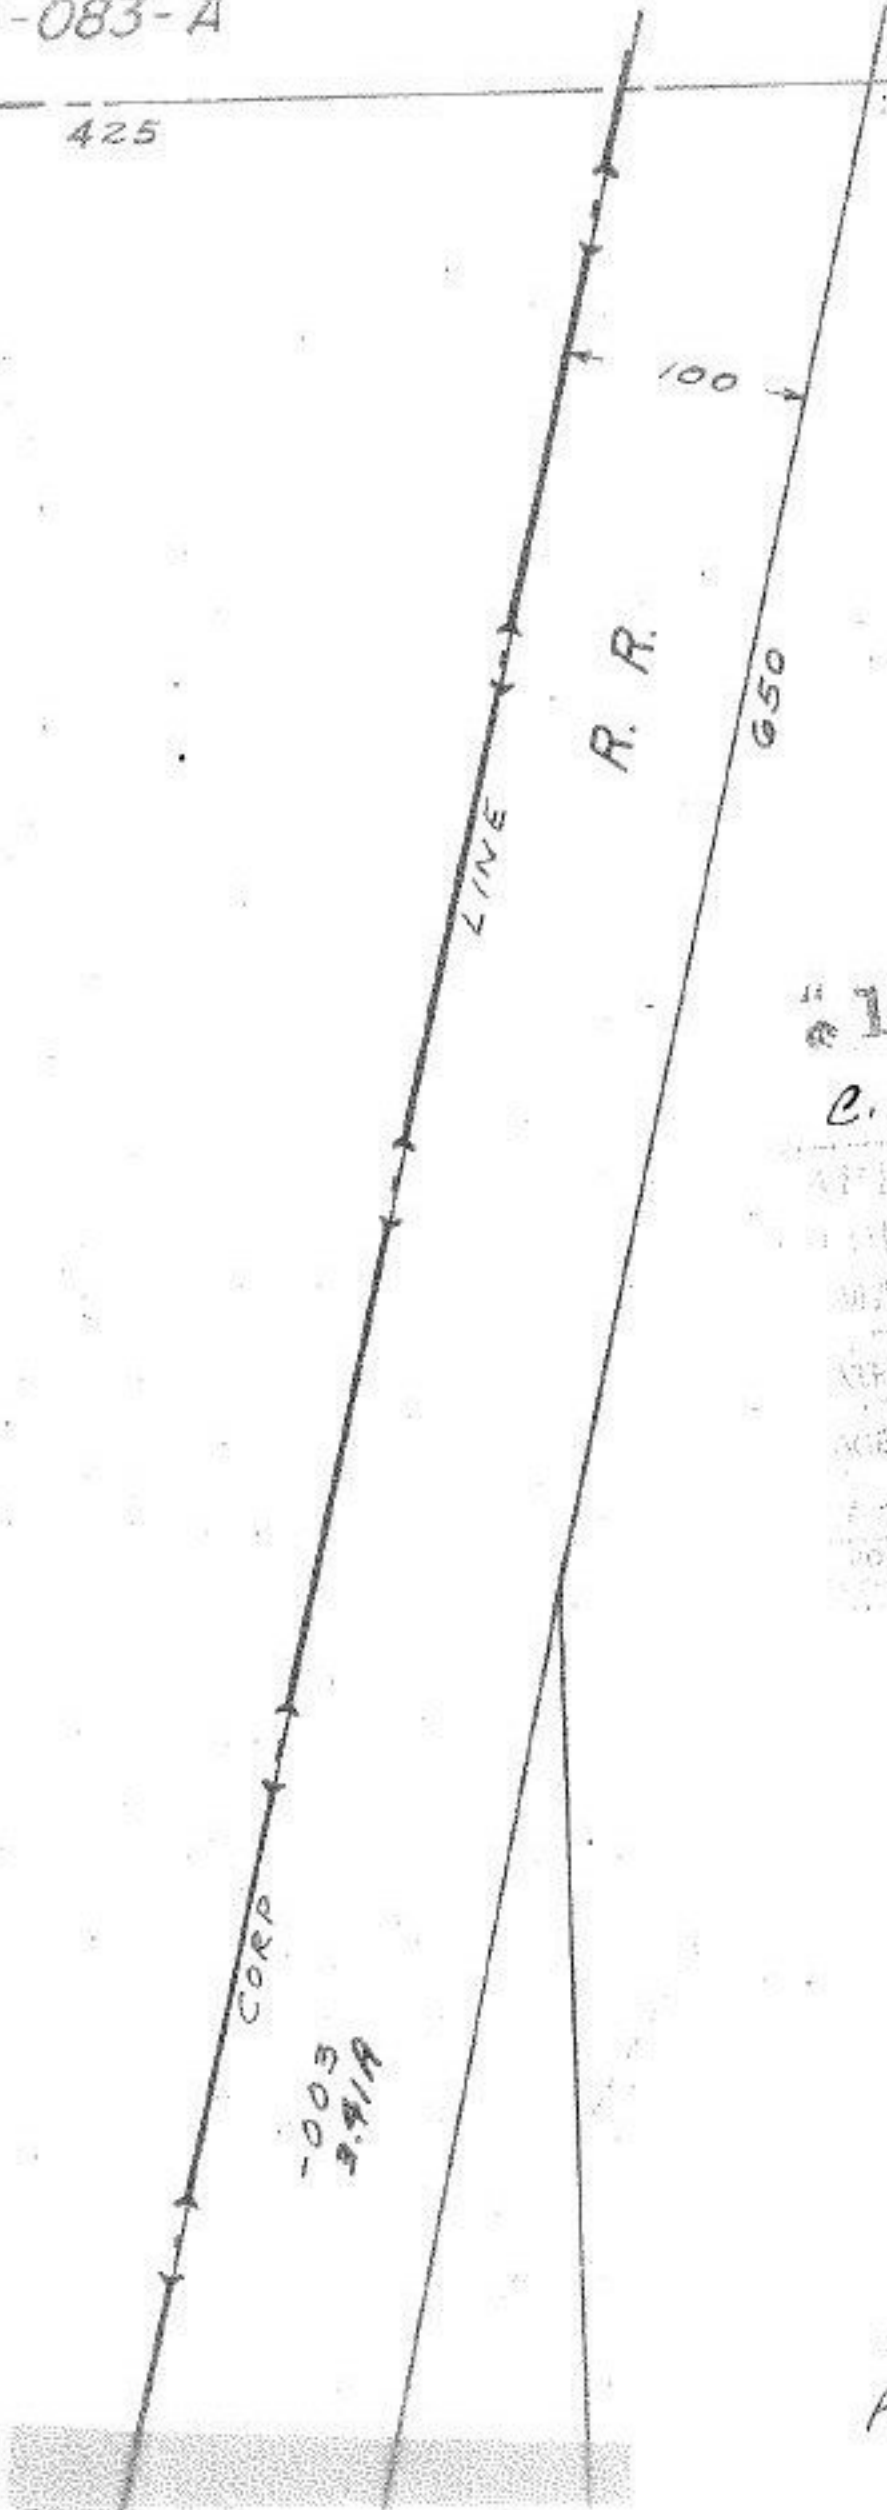

11357

C. F. 2-10-78

APPROVED  
RAILROAD CO.  
MAP DEPT.

APR 2-8-78

SEE 9-00-093 AFB

T. McNaic

11357

CORP

1003  
3.9/1A

11357

1003  
12-82A

PT. - 028

PT. ~~13.67A~~

13.71A