


11357

82-01

1172 RY

Q 7.2-10-78

APPROVED
LORAIN CO.
MAP DEPT.
DATE 2-8-78
PLAN 9-00-093A/B
BY T. McNamee
AND 11357

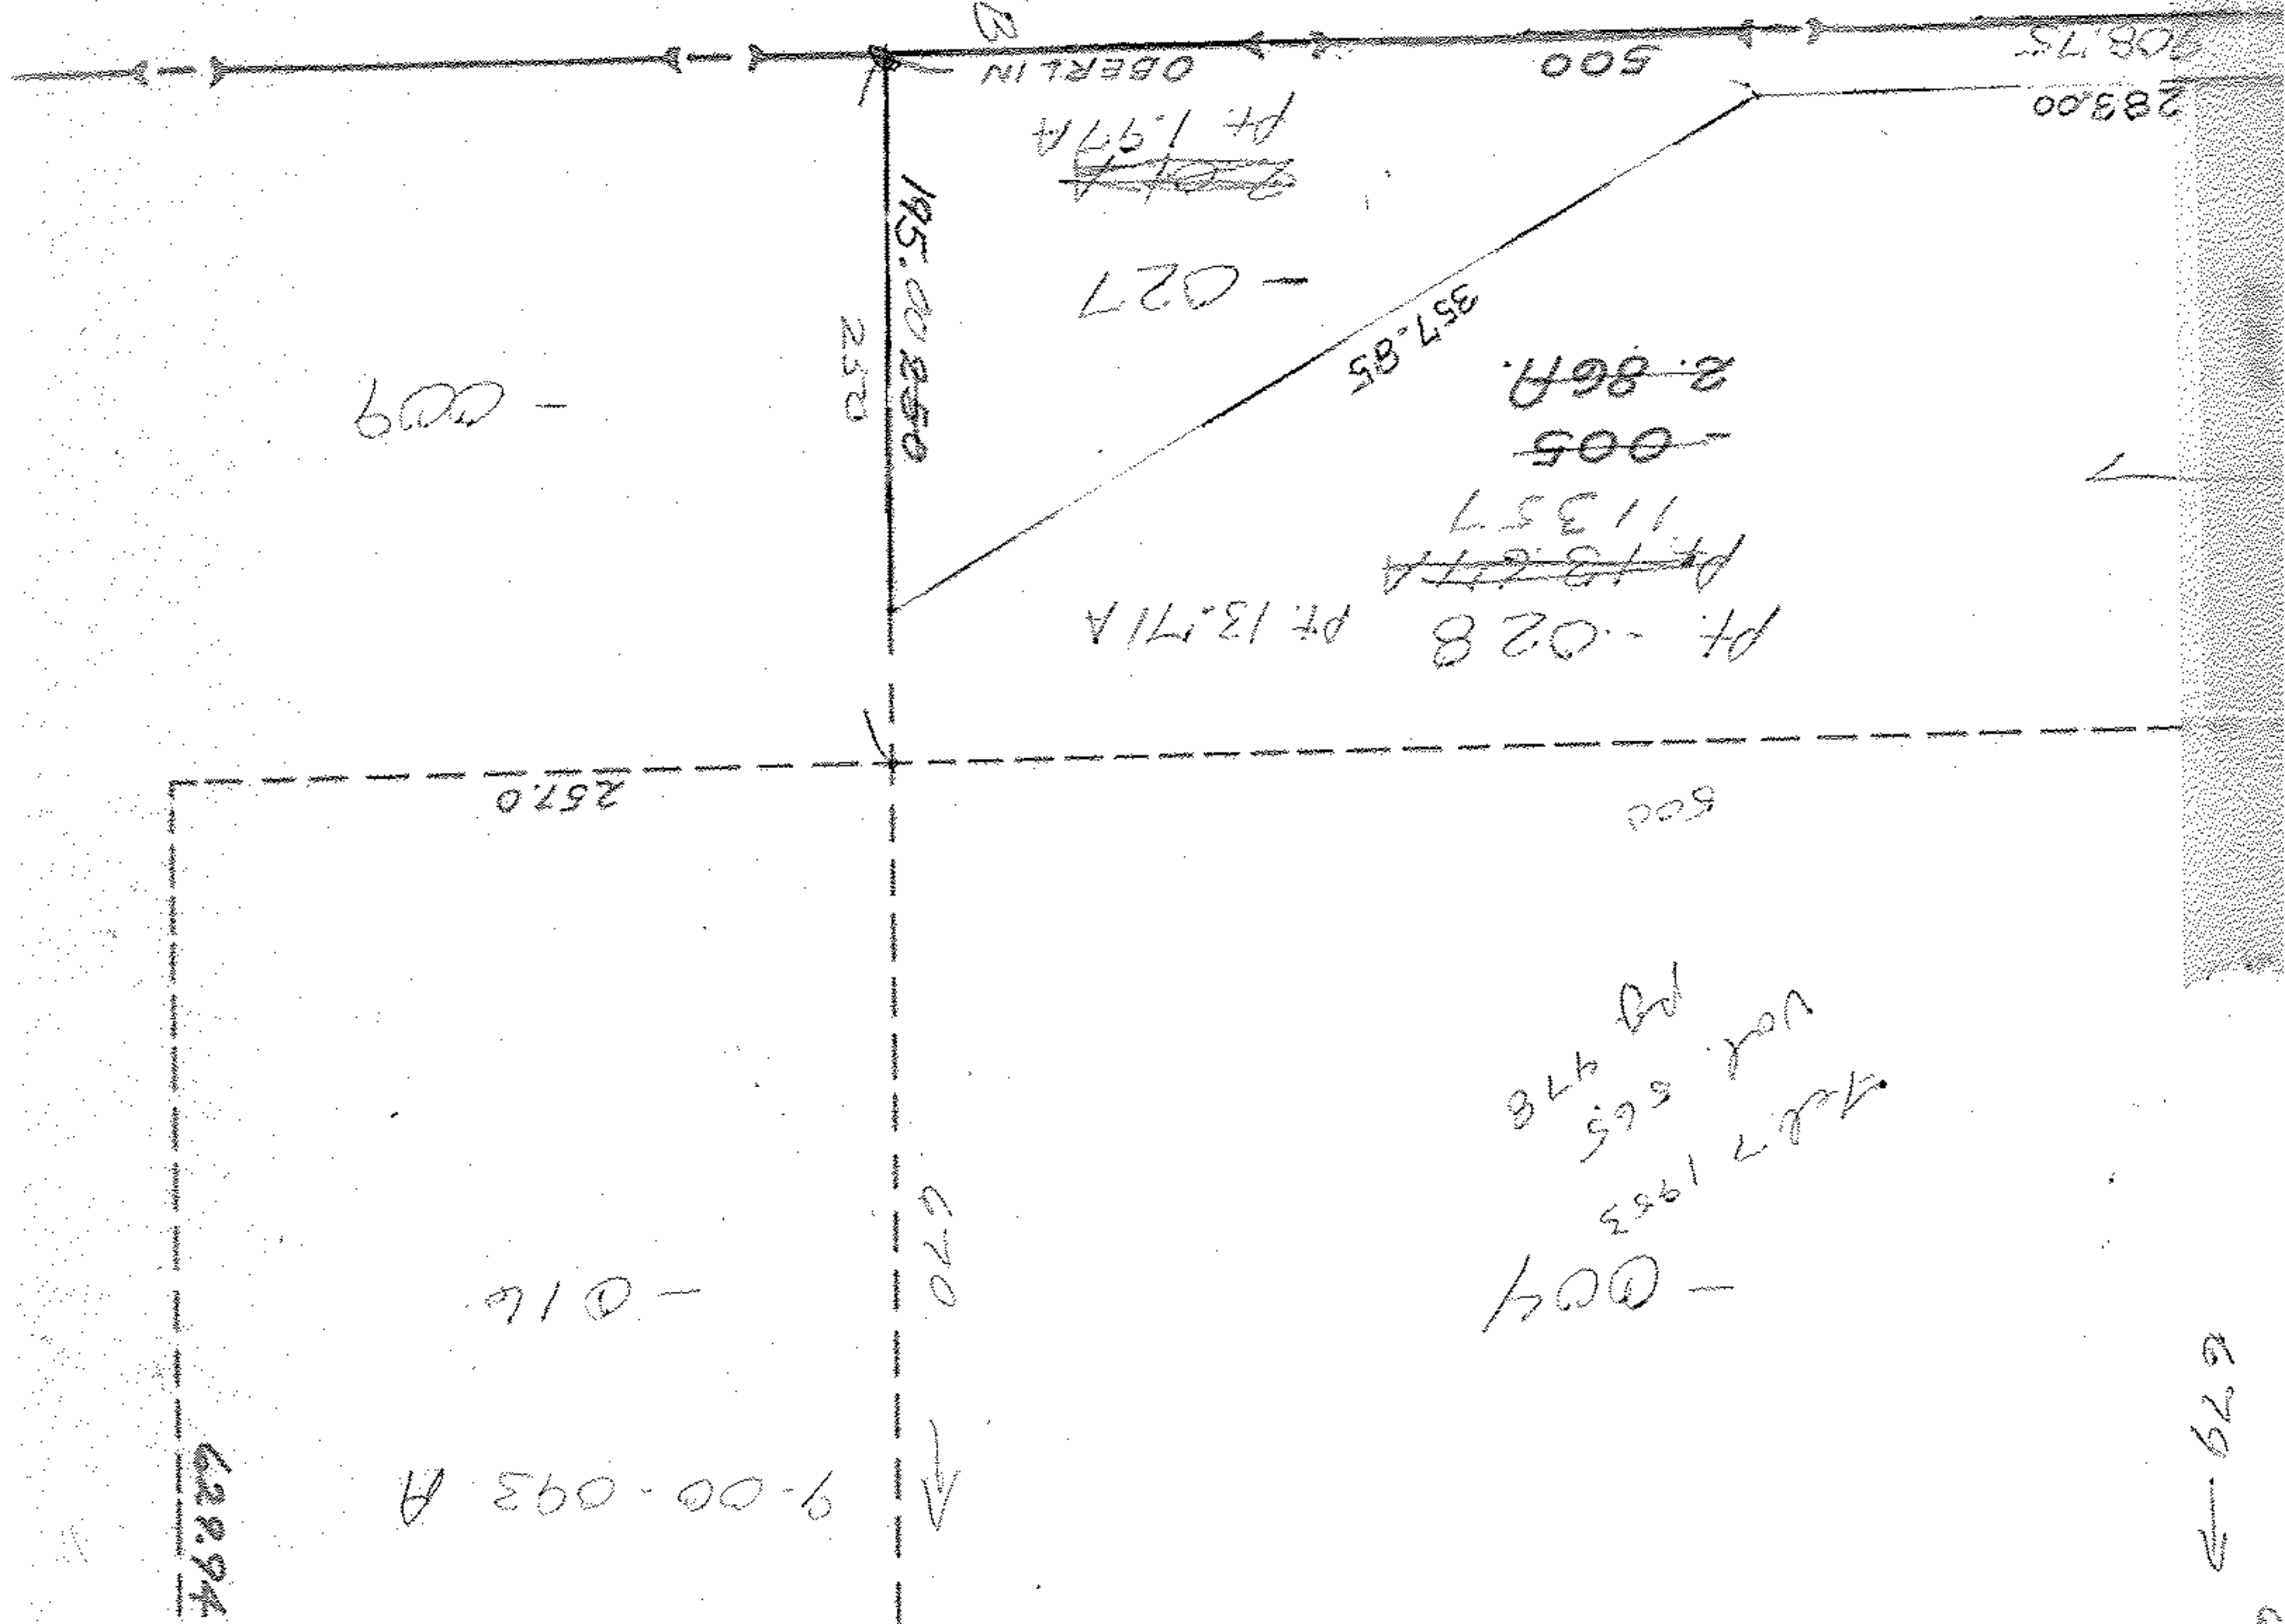

622.94  
 1953  
 Vol. 565  
 pg 478

679 →

622.94