


-010
4.30 A.

Pf. 03-00-033-109-032

Pf. 578A

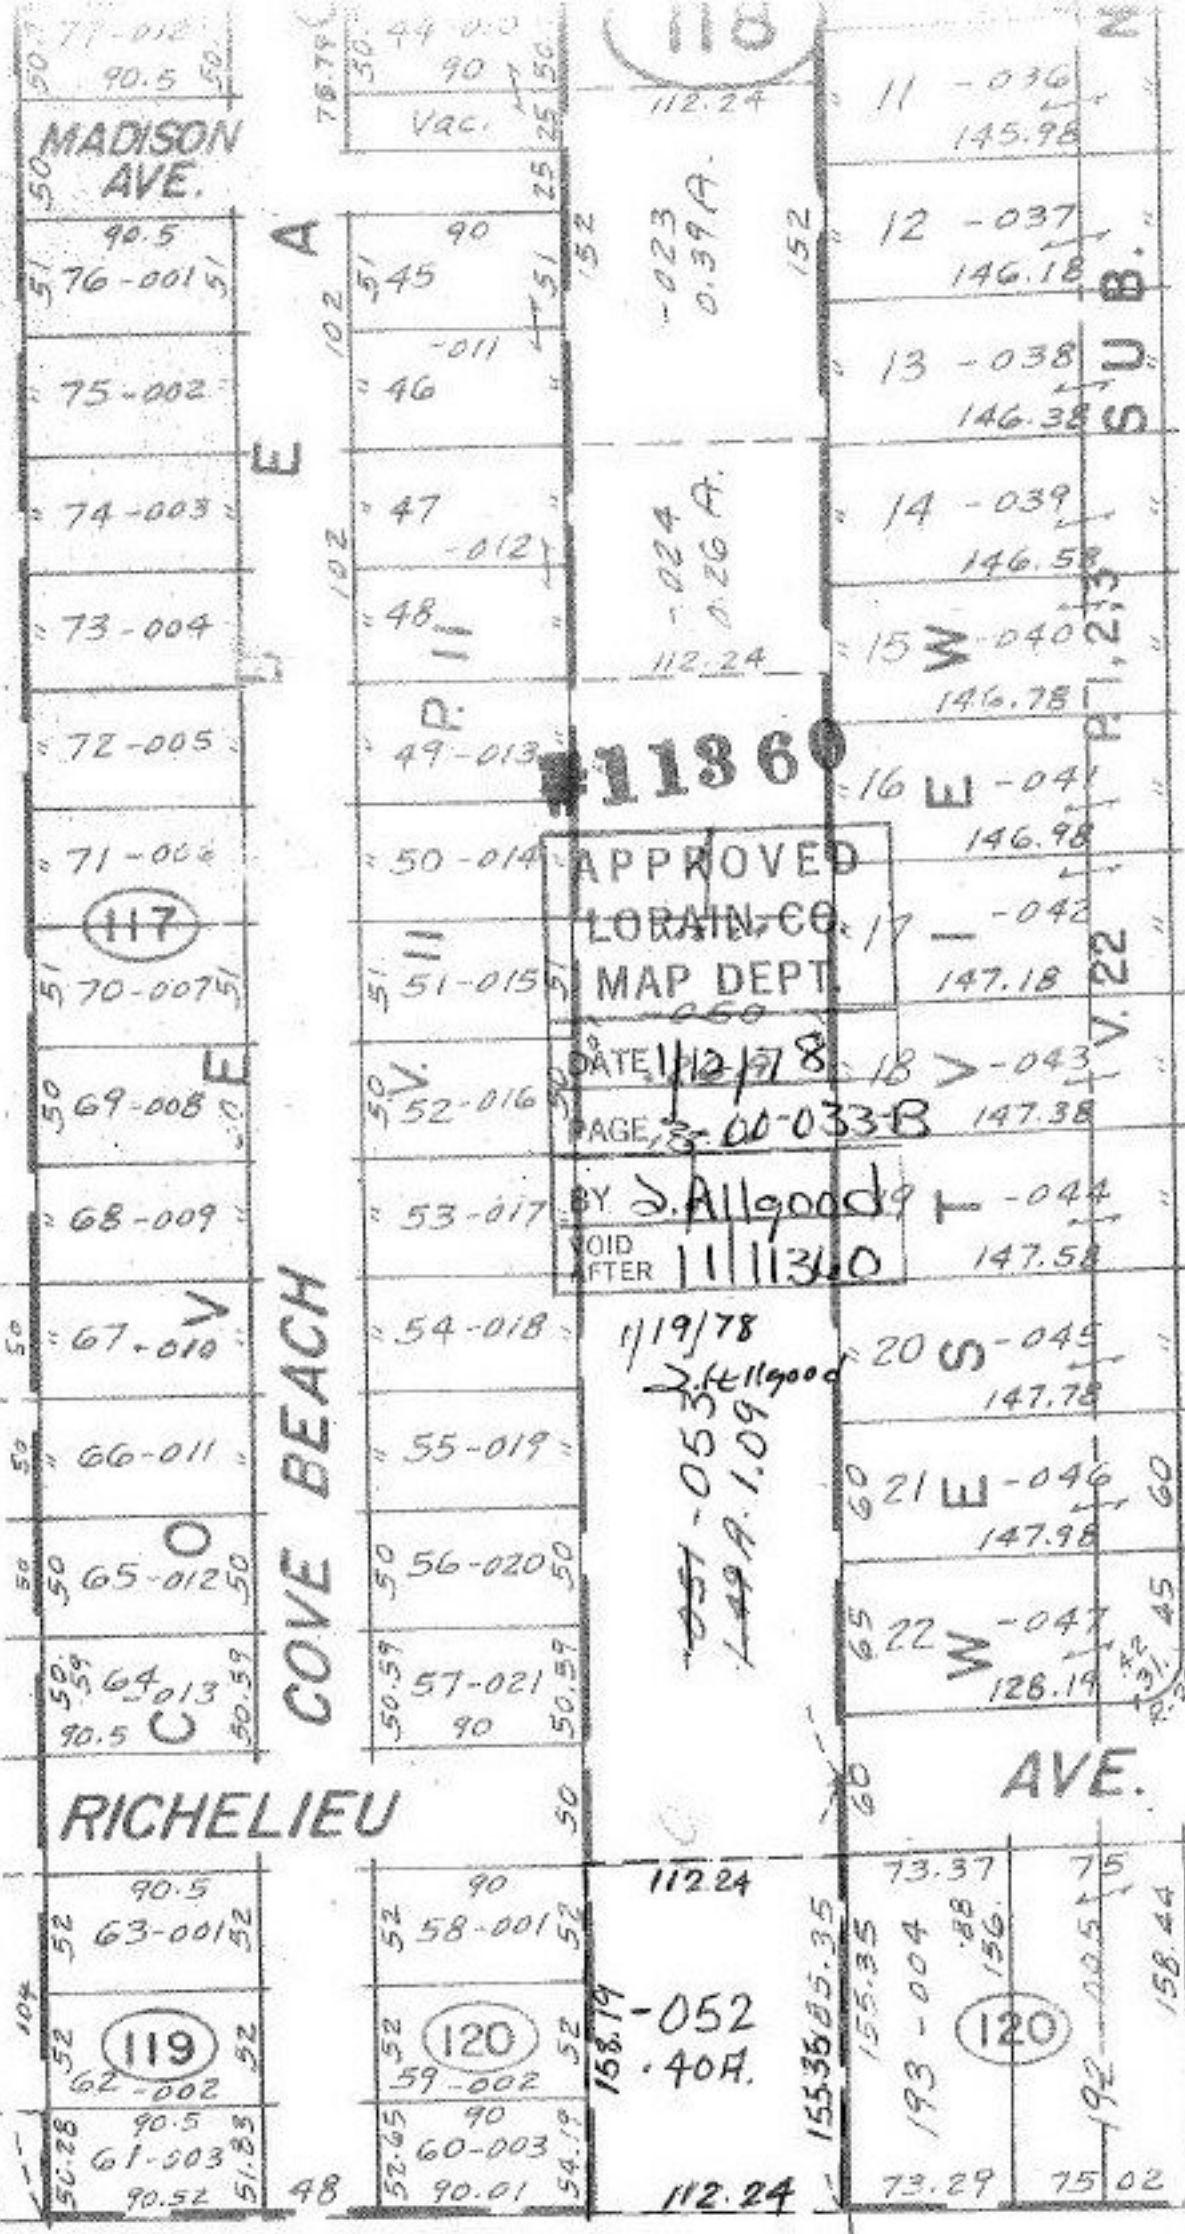

SEE 3-00-03

84-01

SEE 3-D