


10-18-78
11367

E r i e

THRU 83
A16.20

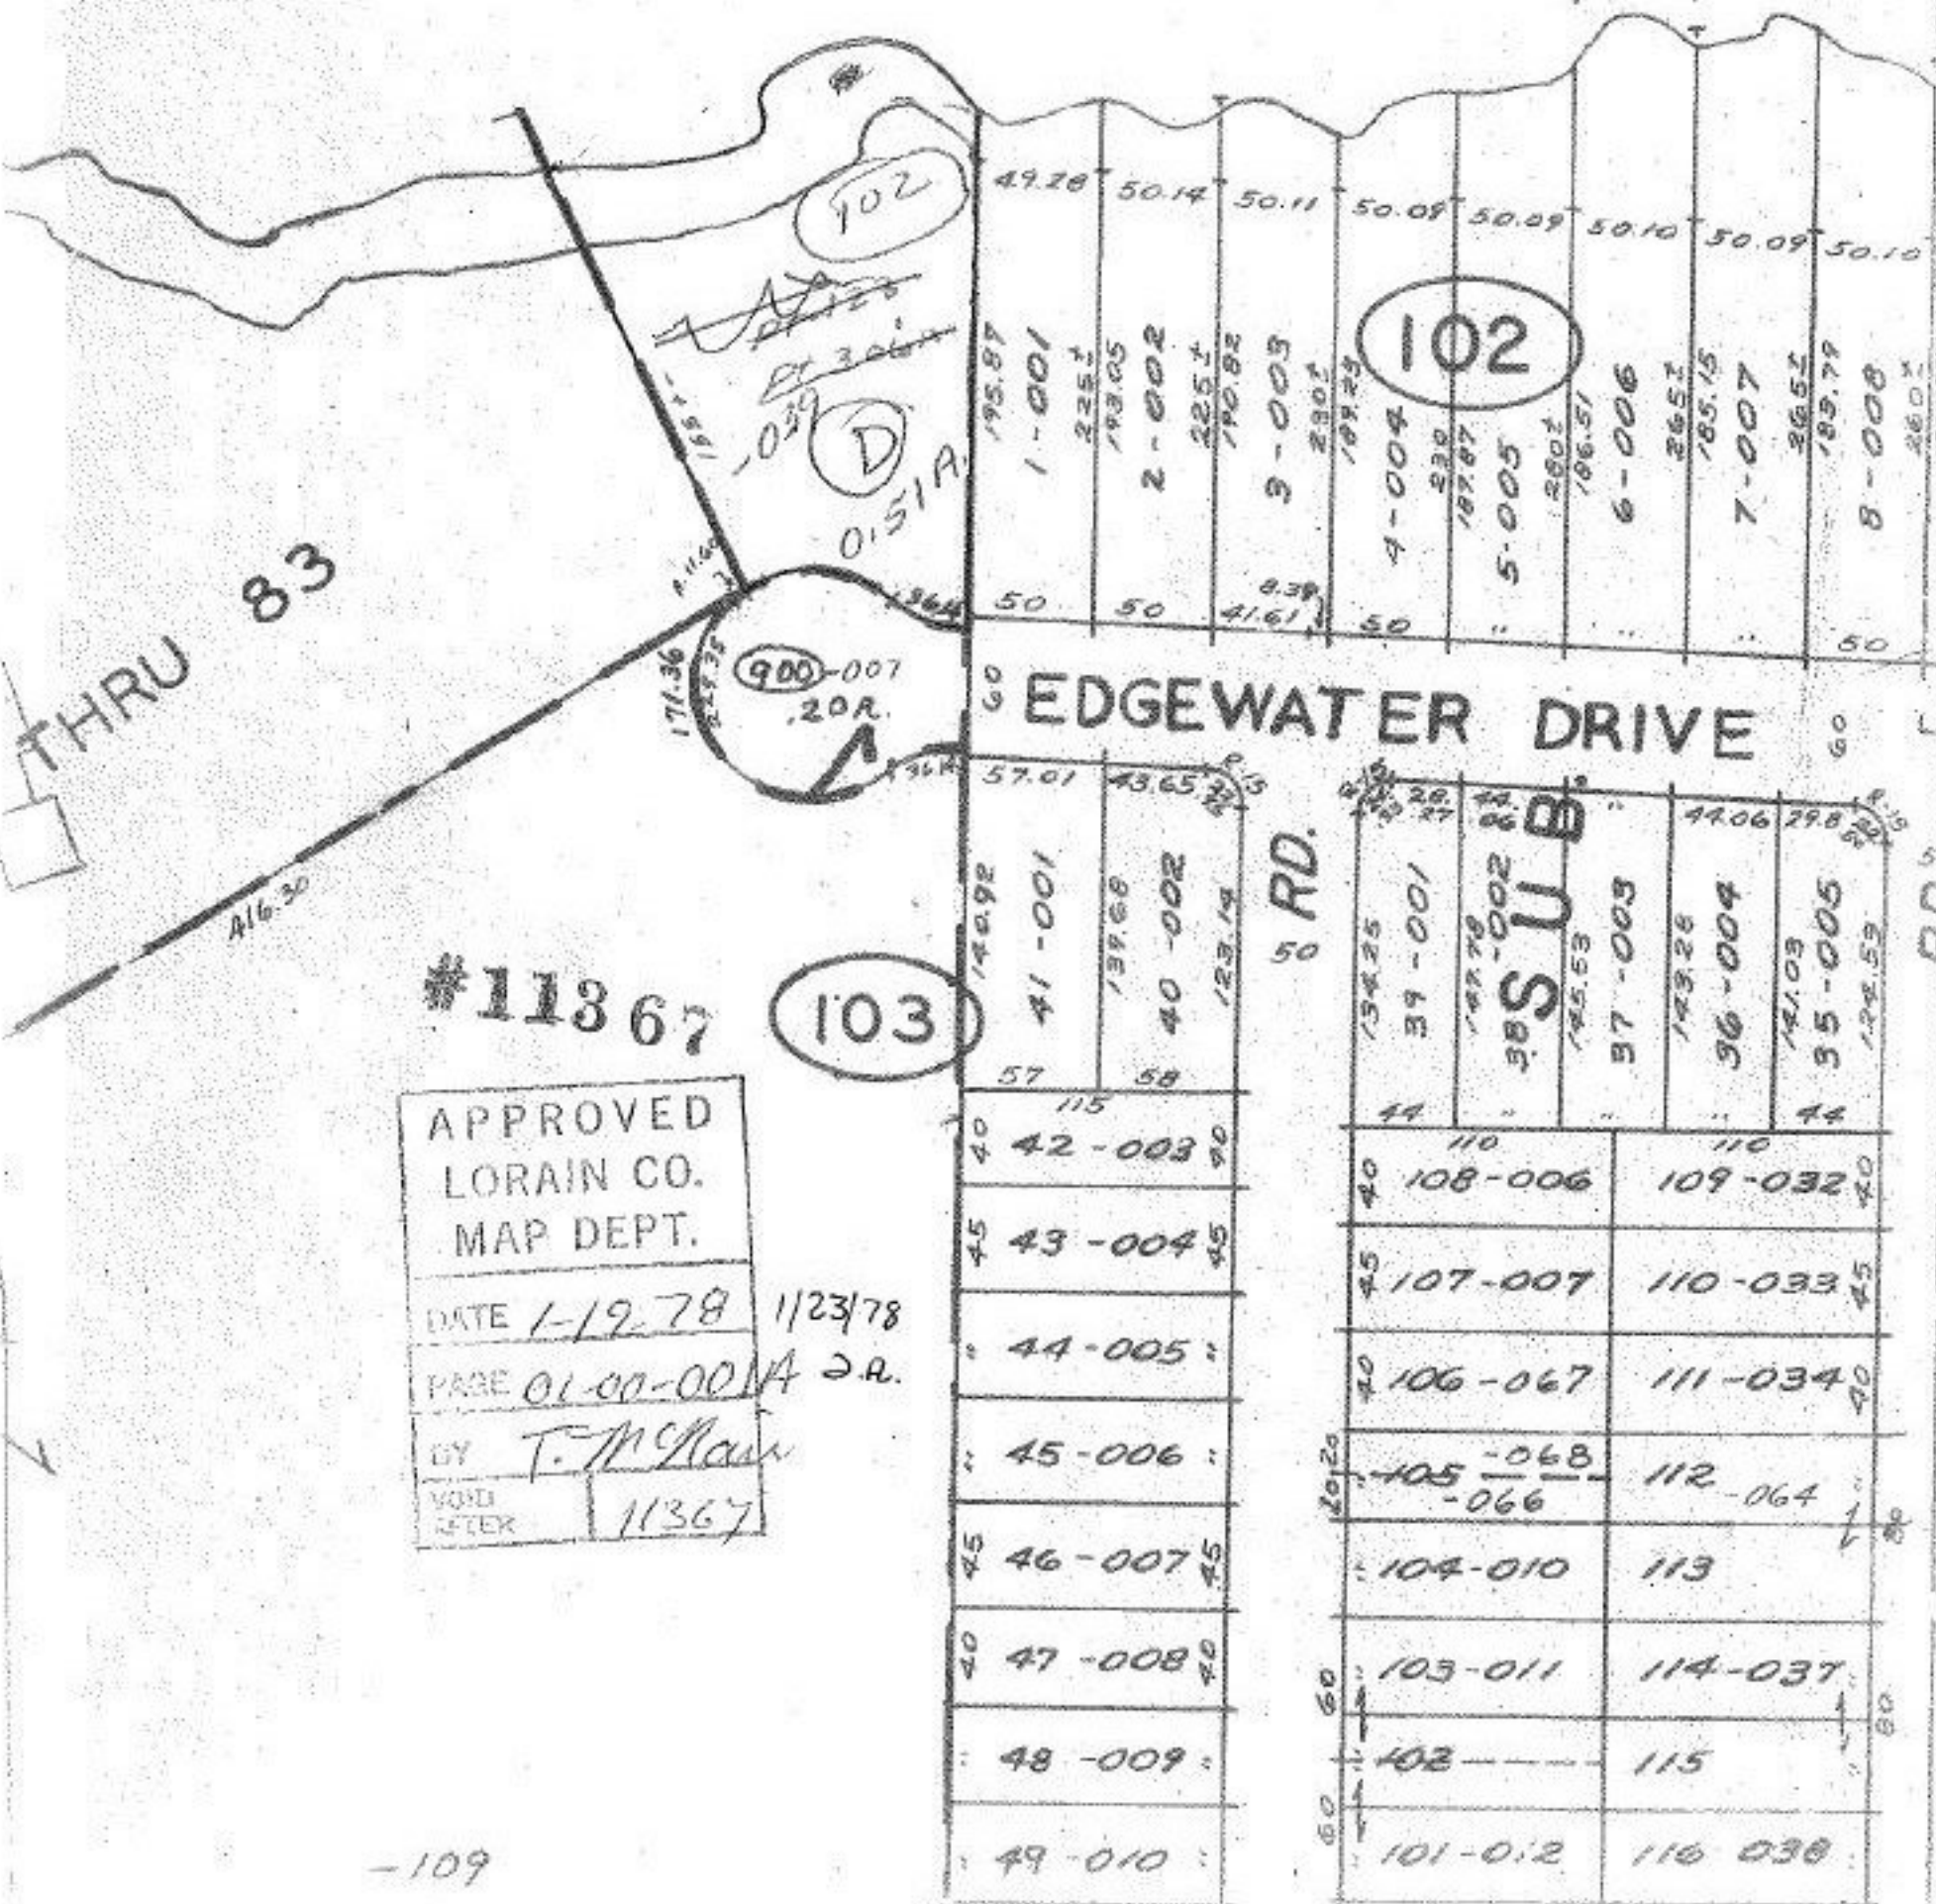

#11367

103

APPROVED	
LORAIN CO.	
MAP DEPT.	
DATE	1-19-78 1123/78
PAGE	01-00-00 A 2A.
BY	T. McLean
VOL	11367
SER	