

1032.39

T

-020  
55.18 A.

1755.32

-013  
13.48 A.

#11377

#11377

~~11377~~

-001  
59.55 A.

APPROVED	
LORAIN CO.	
MAP DEPT.	
DATE	1-23-78
PAGE	21-E
BY	T. McNaic
VOID AFTER	11377

2/1/78  
J.A.

799.63

11377

~~-001~~  
49.00 A.  
-003  
44.00

15


2

-002  
40.00 A.

14

660

2653.3

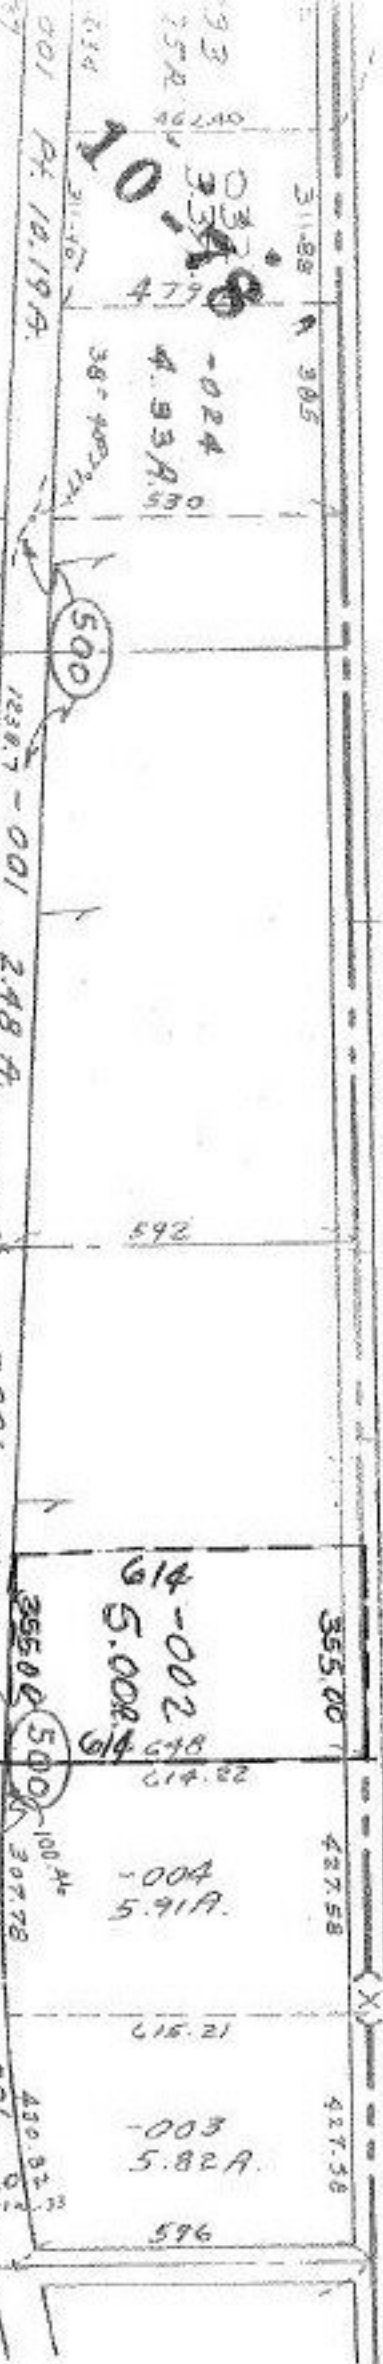

RD.