


11382

11382

#11382

APPROVED	
LORAIN CO.	
MAP DEPT.	
DATE	1-30-78
PAGE	11-00-008 B 2 R.
BY	<i>Heald</i>
VOID AFTER	

2/1/78

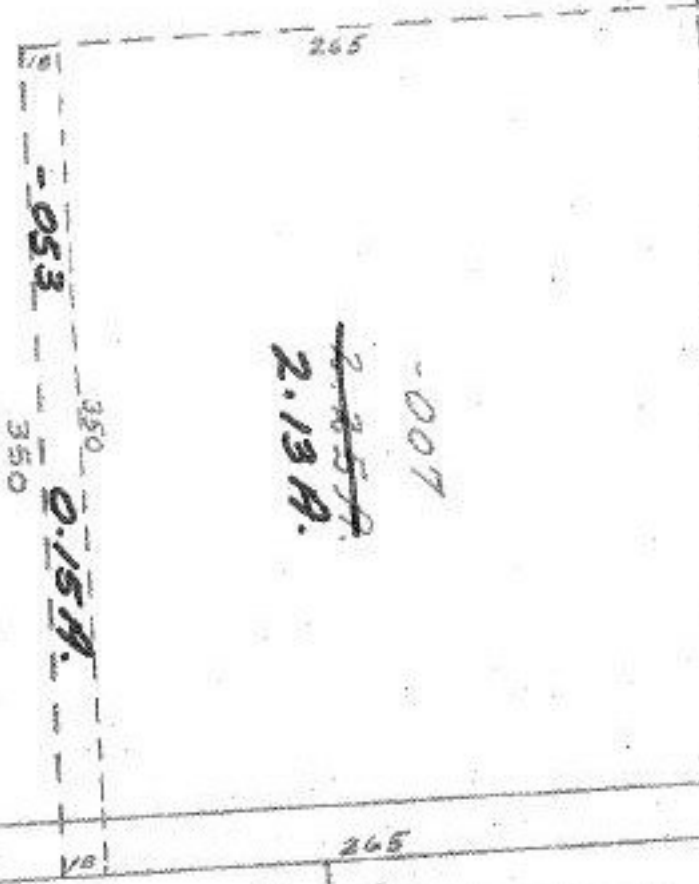

465.03

OSBORNE RD.