


11385

TERRELL'S

342.56  
124.97

#11385

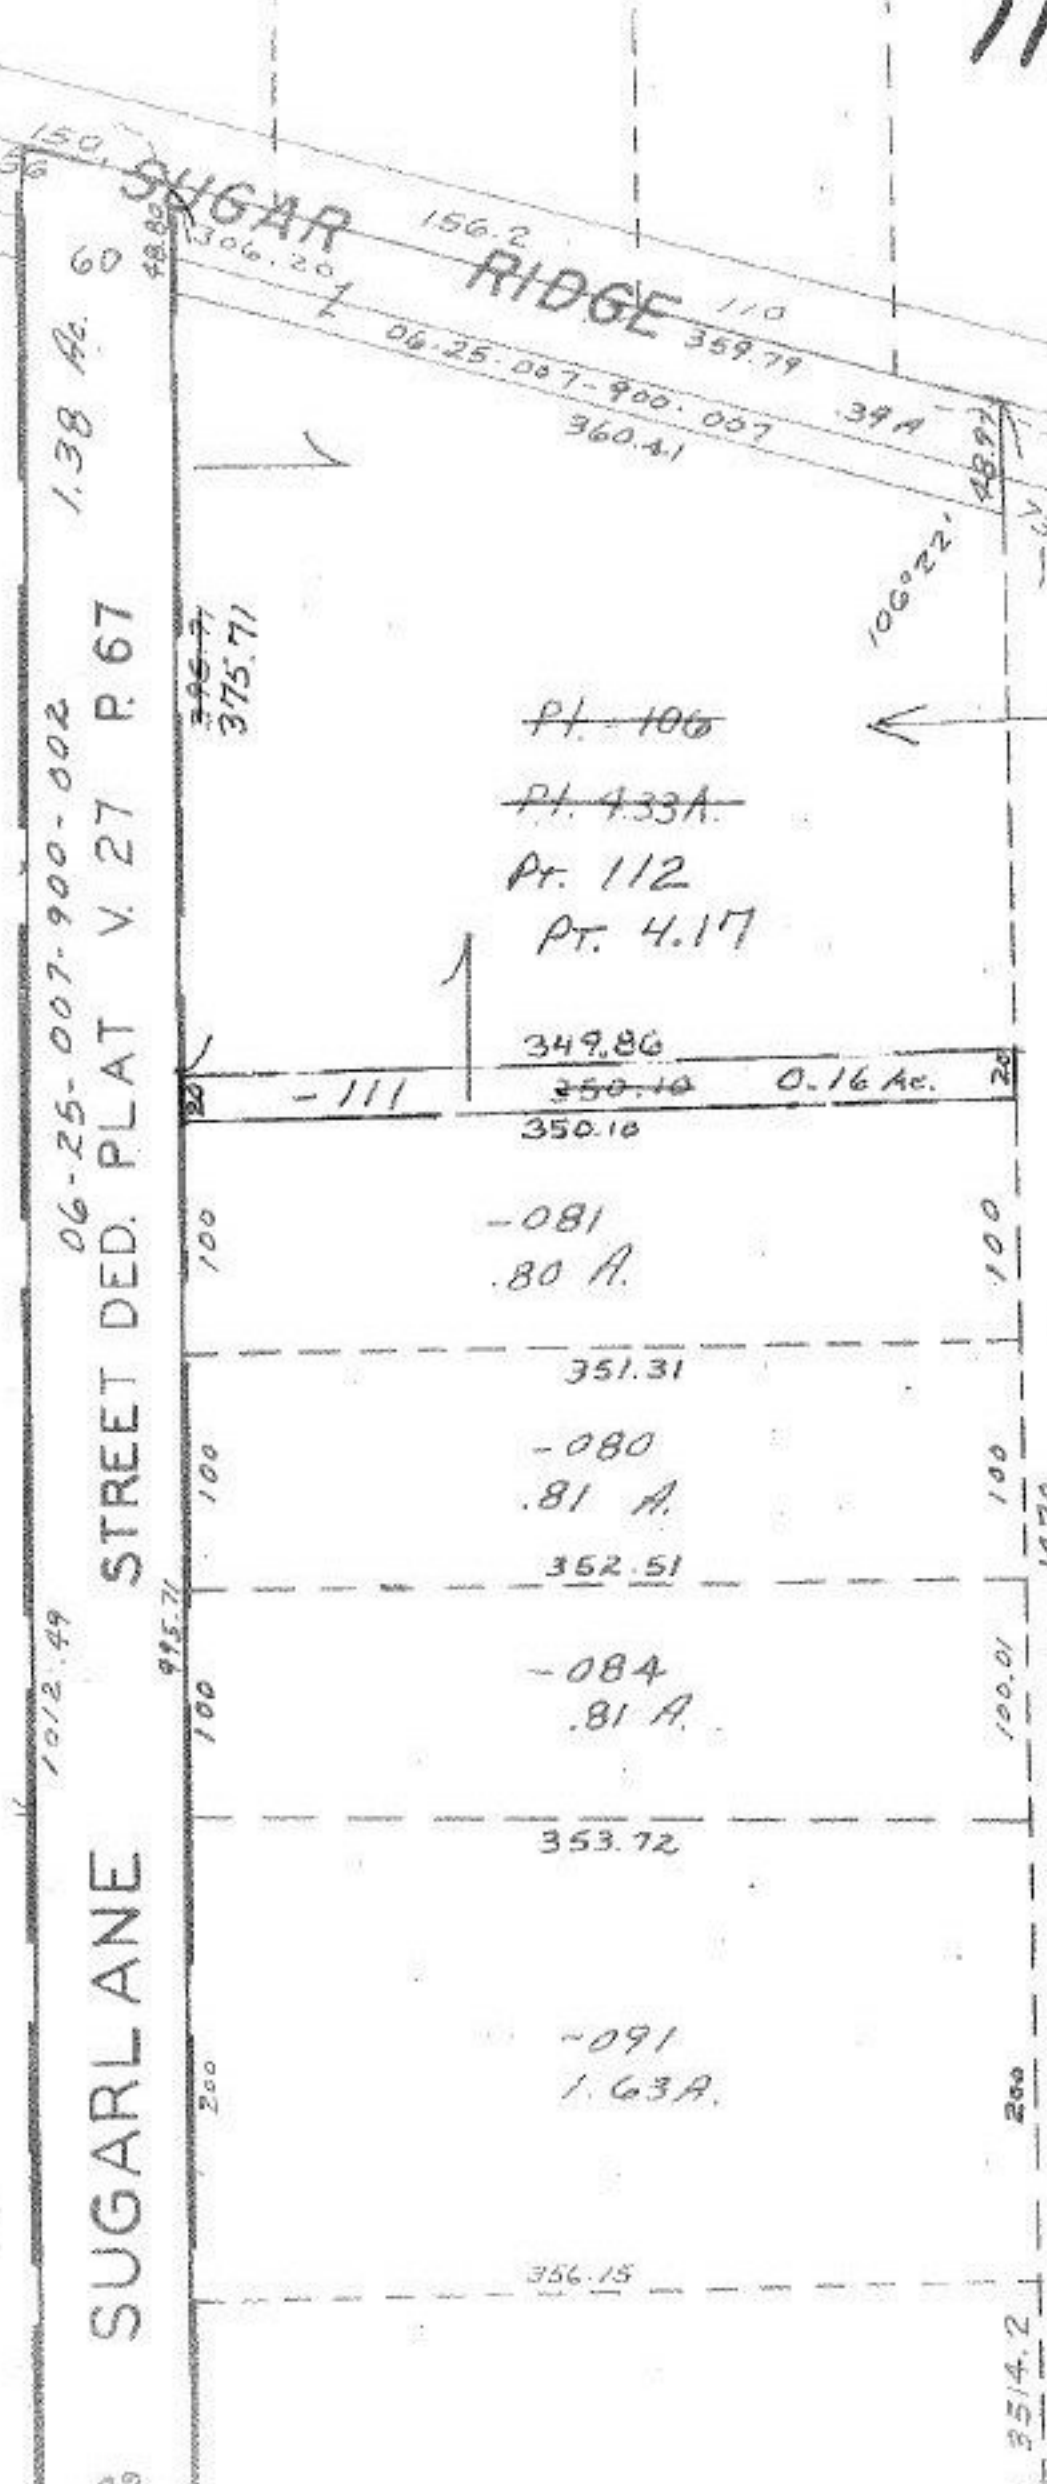

NOTE: ALL PARTS  
OF -106  
CONNECTED BY  
LAND HOOKS MUST  
BE CHANGED TO  
-112.

#11385

APPROVED LORAIN CO. MAP DEPT.	
DATE 2-1-78	
PAGE 6-126 6-125	
BY T. McMain 144	
VOID AFTER	11385

C. 7 2-9-78