


11398

#11398

10-78

APPROVED LORAIN CO. MAP DEPT.	
DATE	2-15-78
PAGE	16-00-001-C
BY J.A. & B.R.	
VOID AFTER	11398

3/21/78
J.A.

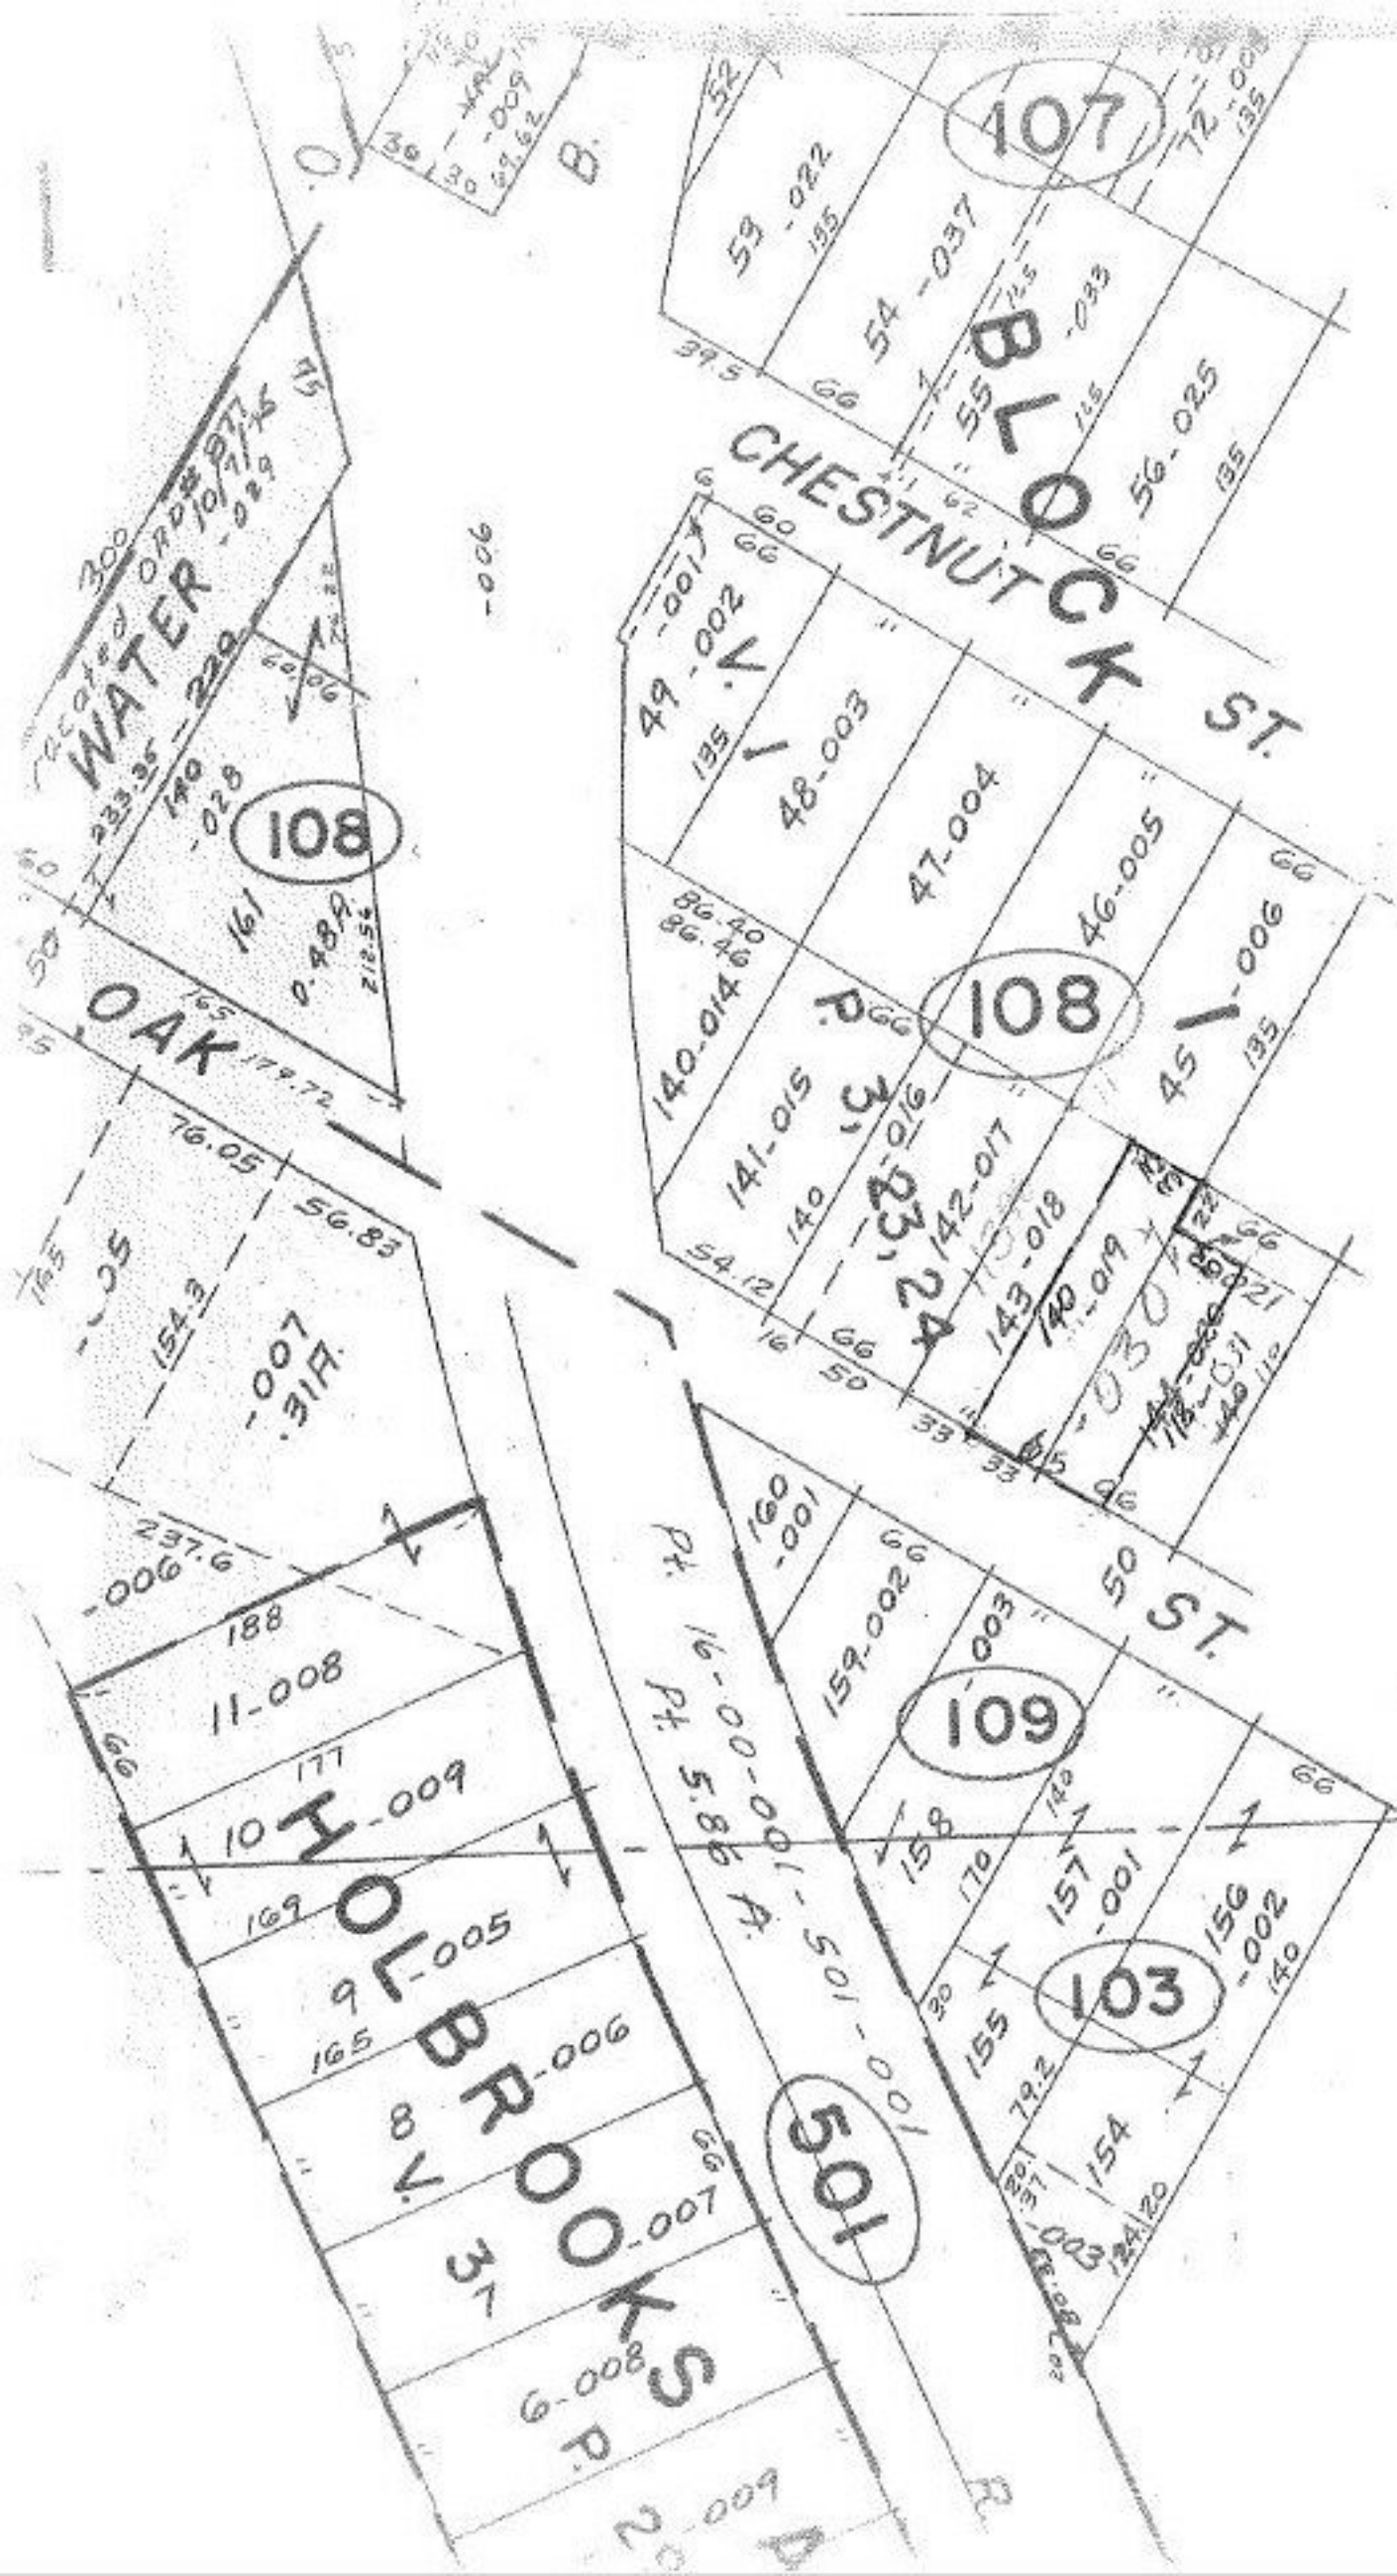

SEE 16-00-001-D