


SEE 12-

SEE 12- 11403

105-11

1423.00  
1297.0  
BOONE

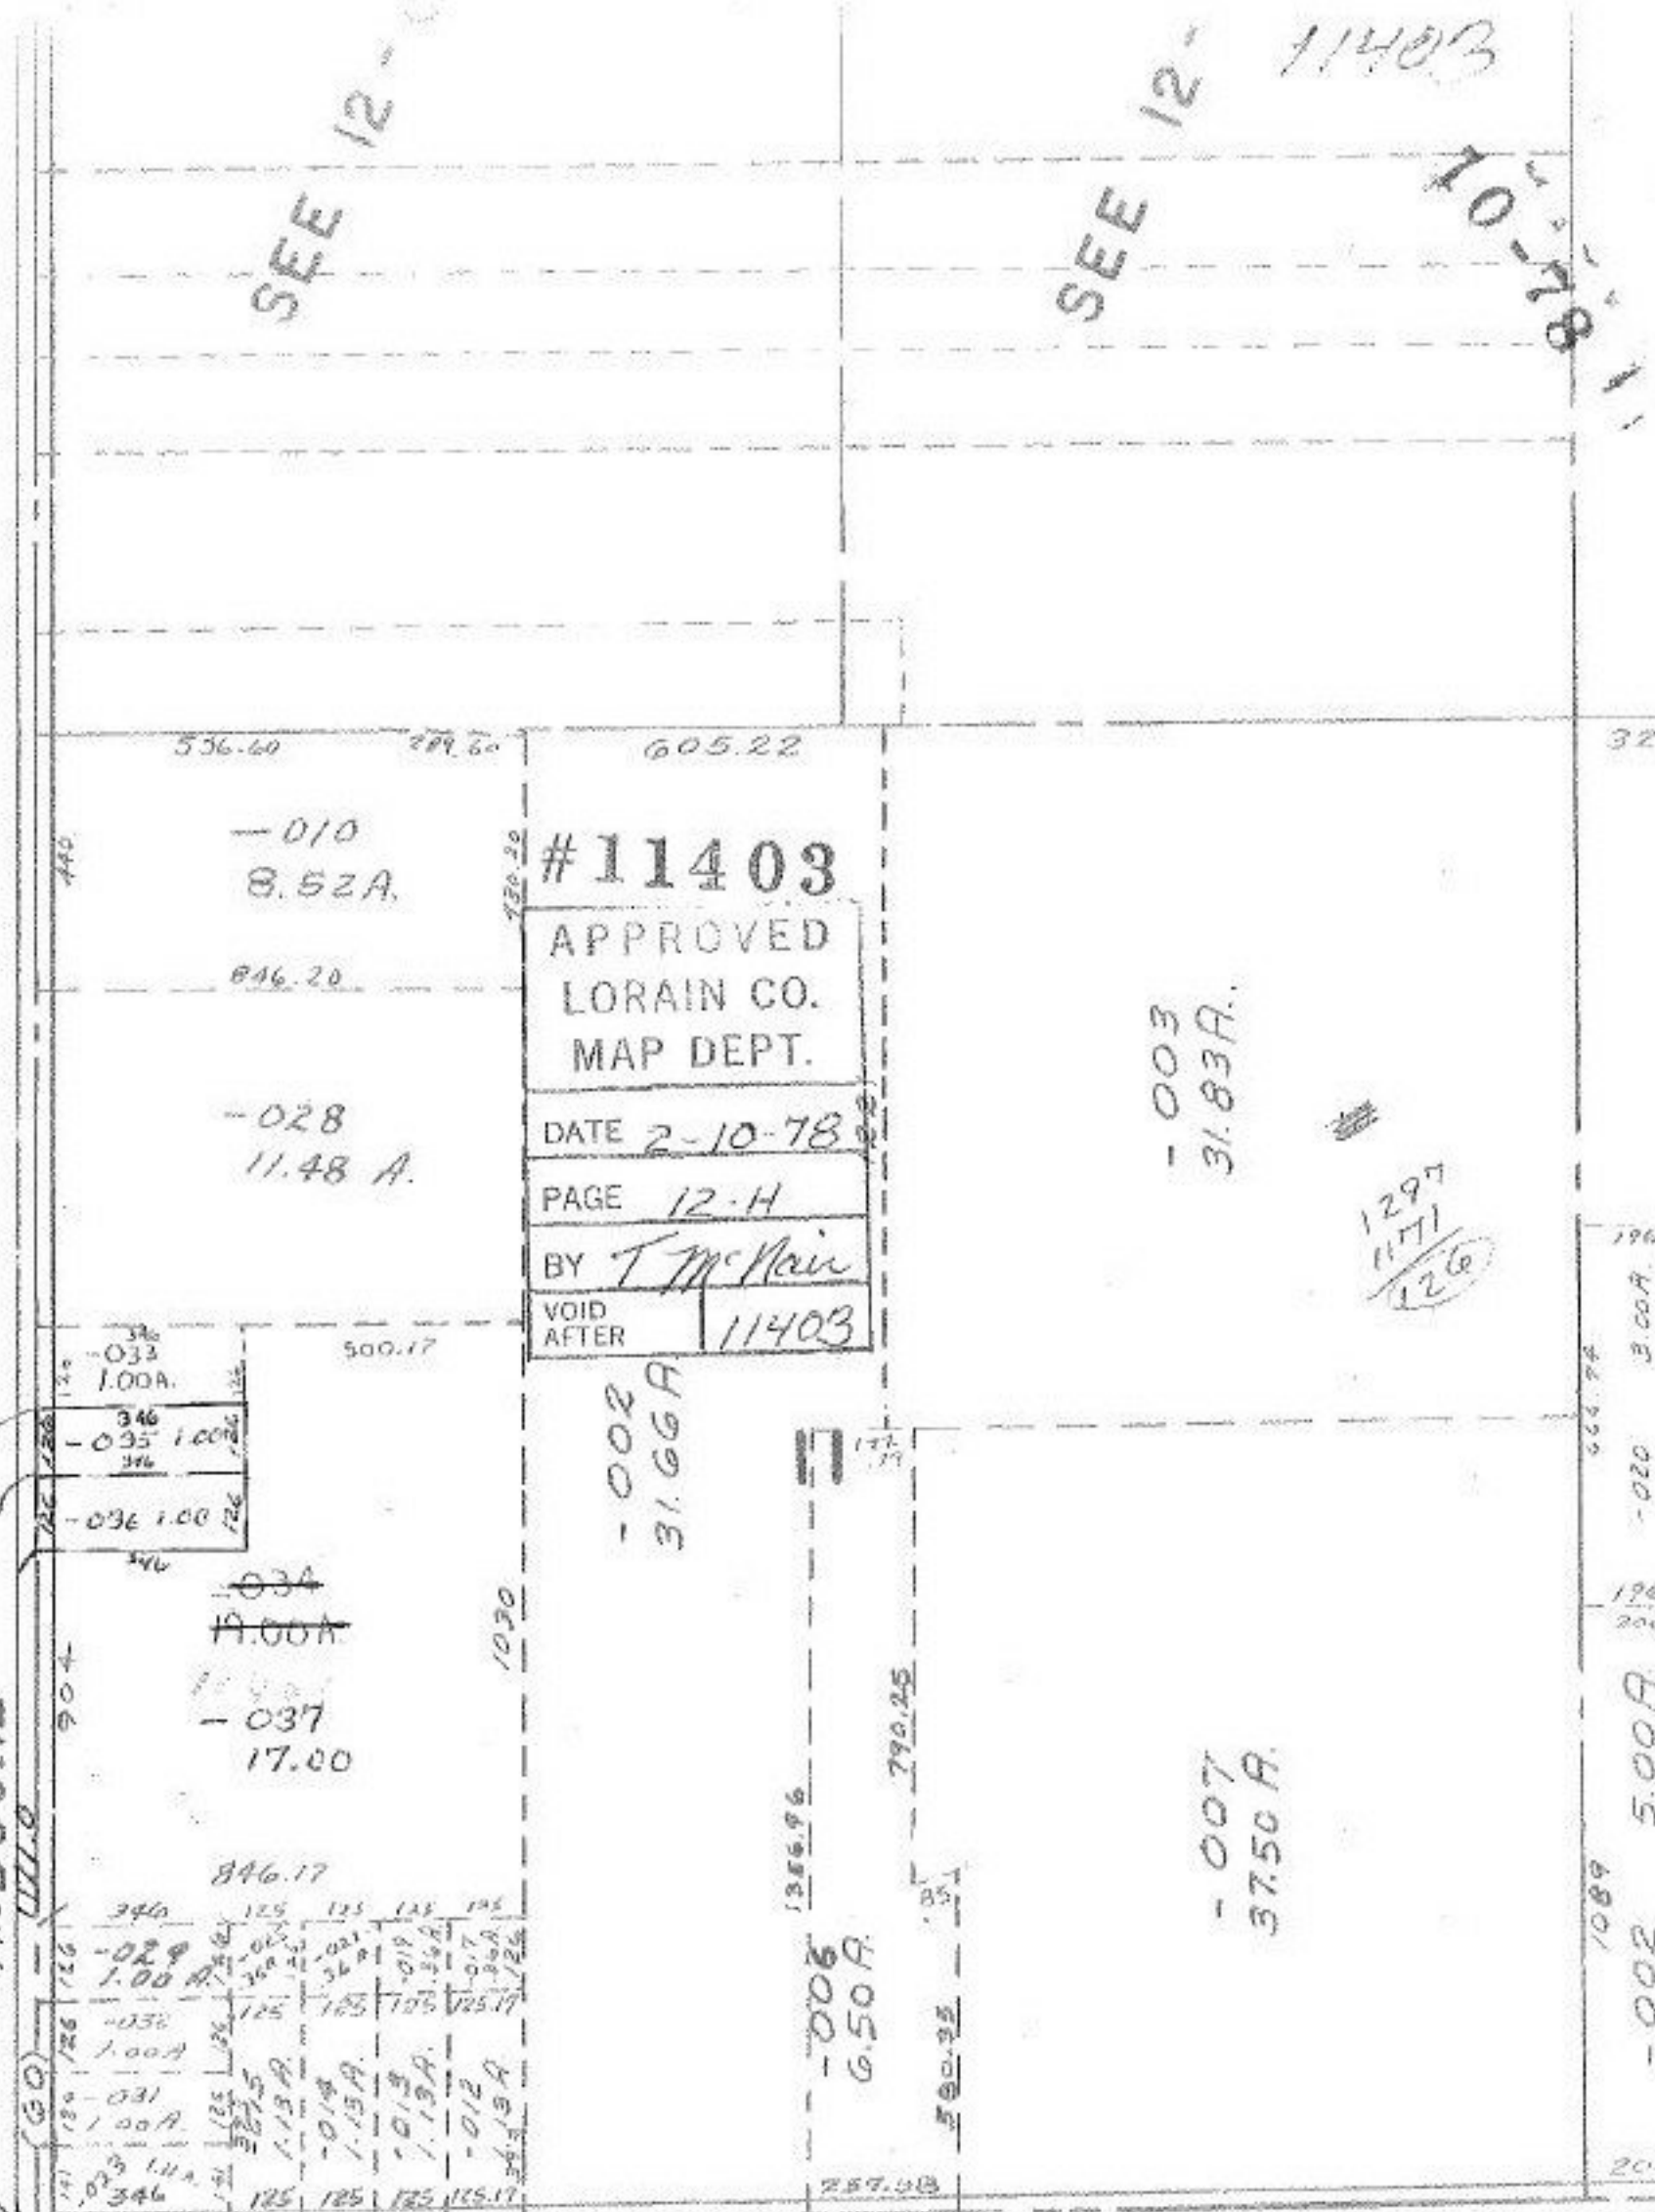

#11403  
 APPROVED  
 LORAIN CO.  
 MAP DEPT.  
 DATE 2-10-78  
 PAGE 12-H  
 BY T. McHair  
 VOID AFTER 11403

536.60 299.50 605.22 32

440

-010  
8.52A.

846.20

-028  
11.48 A.

500.17

346  
-033  
1.00A.

346  
-035  
1.00A.

346  
-036  
1.00A.

346  
-034  
1.00A.

1030

-037  
17.00

846.17

346  
-029  
1.00A.

125  
-032  
1.00A.

125  
-031  
1.00A.

125  
-019  
1.13A.

125  
-018  
1.13A.

125  
-017  
1.13A.

125  
-012  
1.13A.

125  
-011  
1.13A.

125  
-010  
1.13A.

125  
-009  
1.13A.

125  
-008  
1.13A.

125  
-007  
1.13A.

125  
-006  
1.13A.

125  
-005  
1.13A.

125  
-004  
1.13A.

125  
-003  
1.13A.

125  
-002  
1.13A.

125  
-001  
1.13A.

-002  
31.66A

-003  
31.83A.

1297  
1171  
126

-007  
37.50 A.

-006  
6.50 A.

196  
3.00A.  
-020  
196  
3.00A.  
-002  
5.00A.  
1089  
-002  
5.00A.  
200

BOSTON  
COLUMBIA TWP.

SCALE: 1" = 400'