


11406-0-7A

MAKE SURE  
NUMBER IS  
CHANGED HERE.

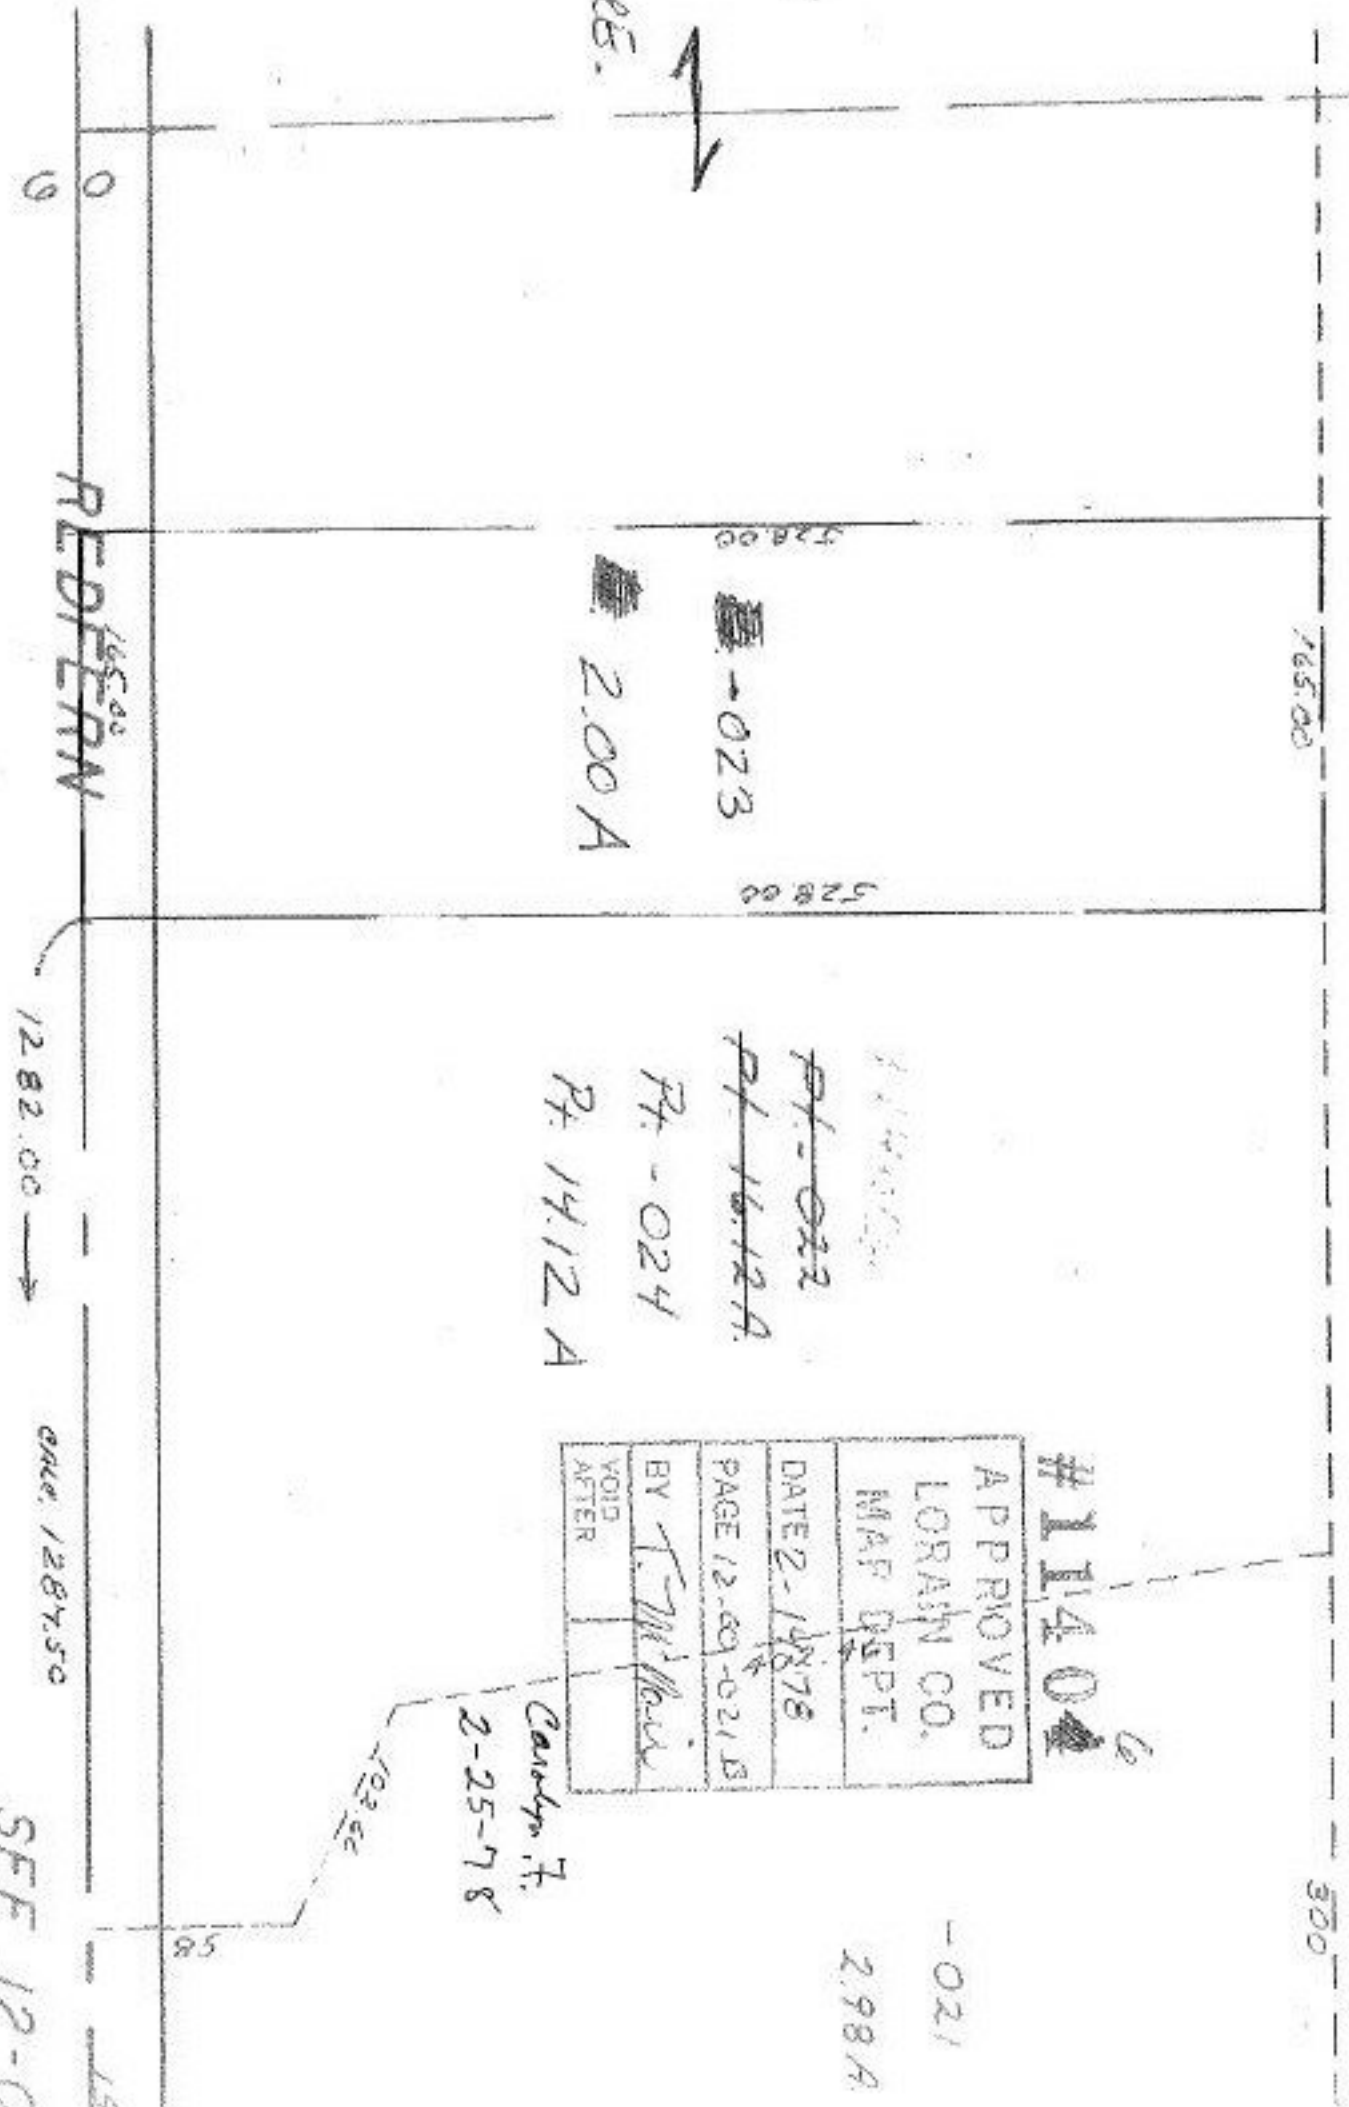

~~Pt. - 022~~  
~~Pt. - 16.12 A.~~  
Pt. - 024  
Pt. 14.12 A

#11406	
APPROVED	
LORAIN CO.	
MAP DEPT.	
DATE	2-19-78
PAGE	12-001-021 B
BY	T. M. [Signature]
VOID AFTER	

Carlynn F.  
2-25-78

-021  
2.98 A

SEE 12-01

To EAST LINE OL 21  
BY SURVEY BOOR & ASSOC. ENR & SURVEYORS

COLUMBIA TWP.  
SCALE: 1" = 100'