

#11412

MAY 7 1979


APPROVED
LORAIN CO.
MAP DEPT.

DATE 2/14/78

PAGE 6 of 9

BY T. McKain

VOID AFTER 8/14/78

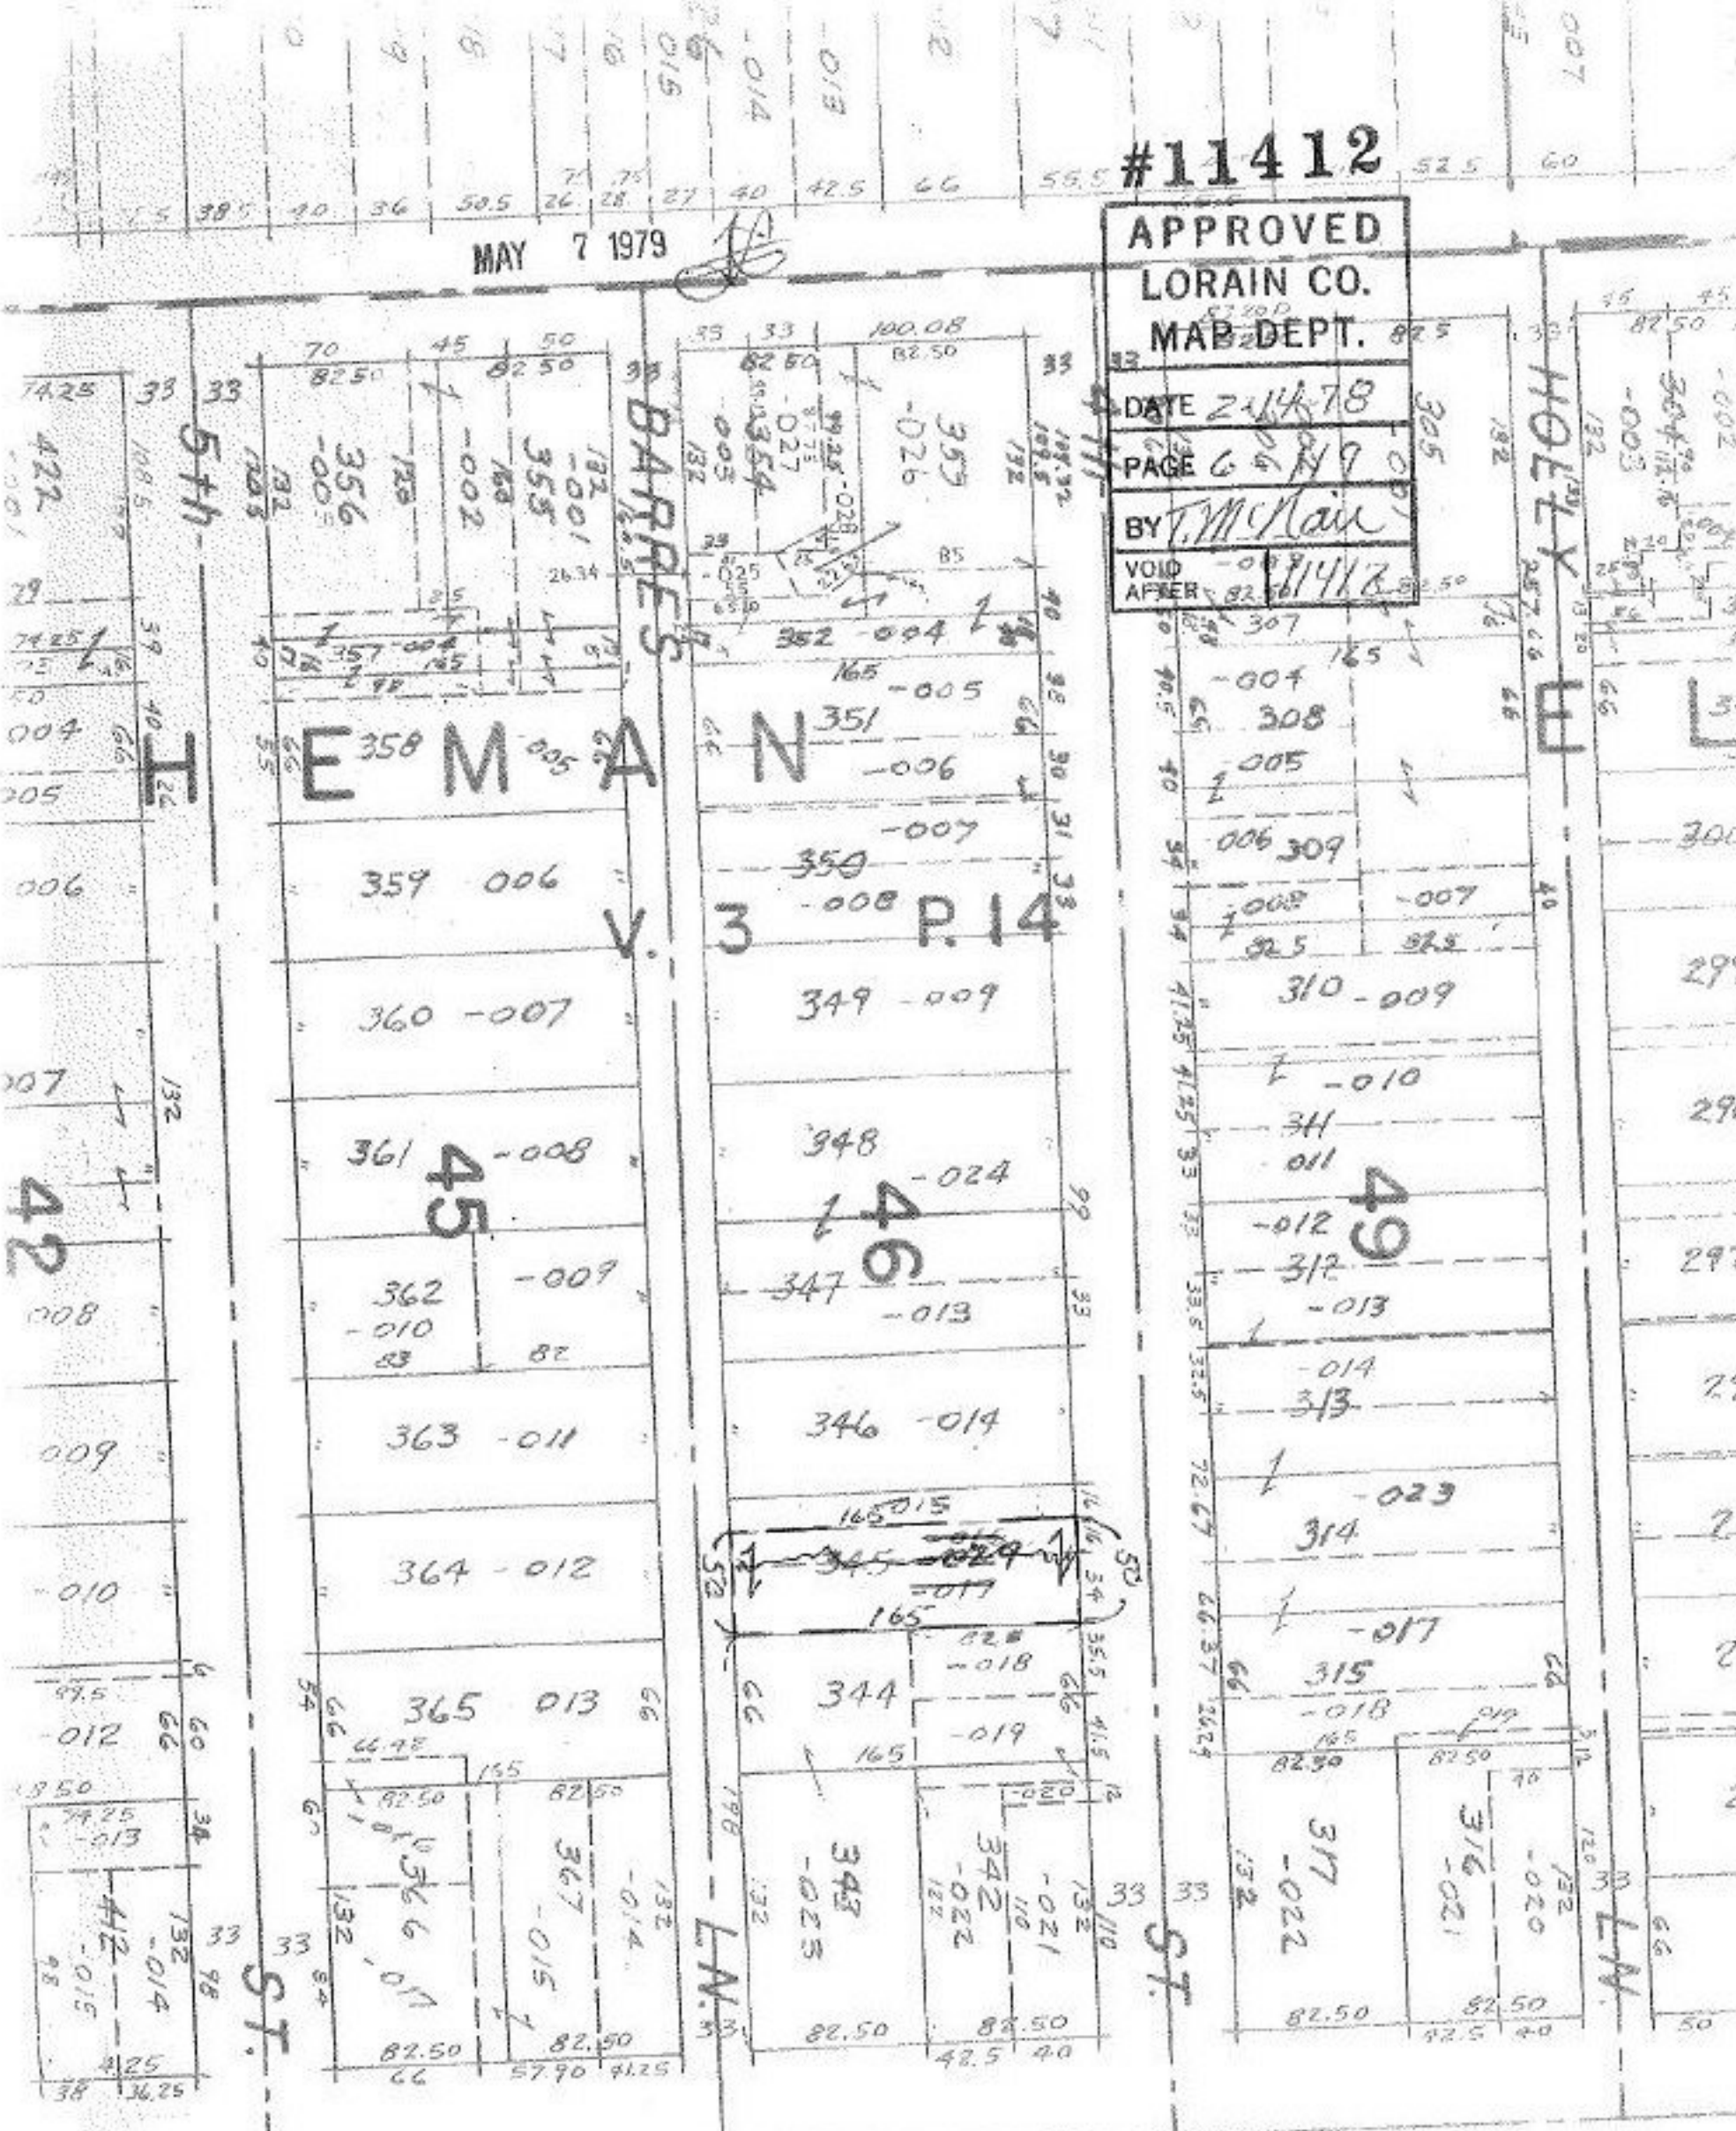

SEE 6