



11418

-031
27.33 A.

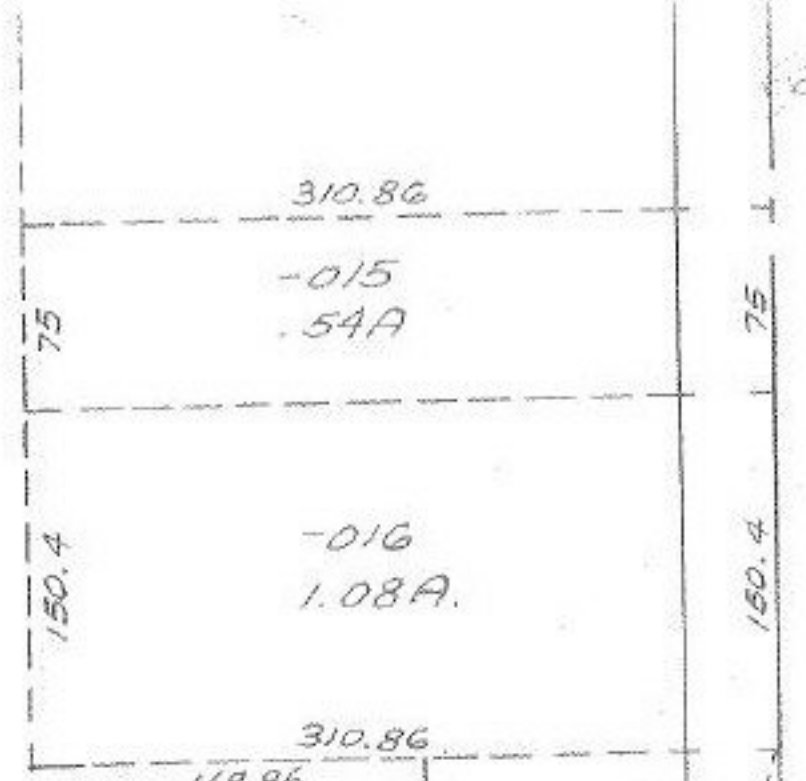

2-23-78
D. Allgood

11418	11418
5-00-033	5-00-033
9-16-78	9-16-78
DATE	DATE
NO. 5-00-033	NO. 5-00-033
BY D.M.	BY D.M.
11418	11418

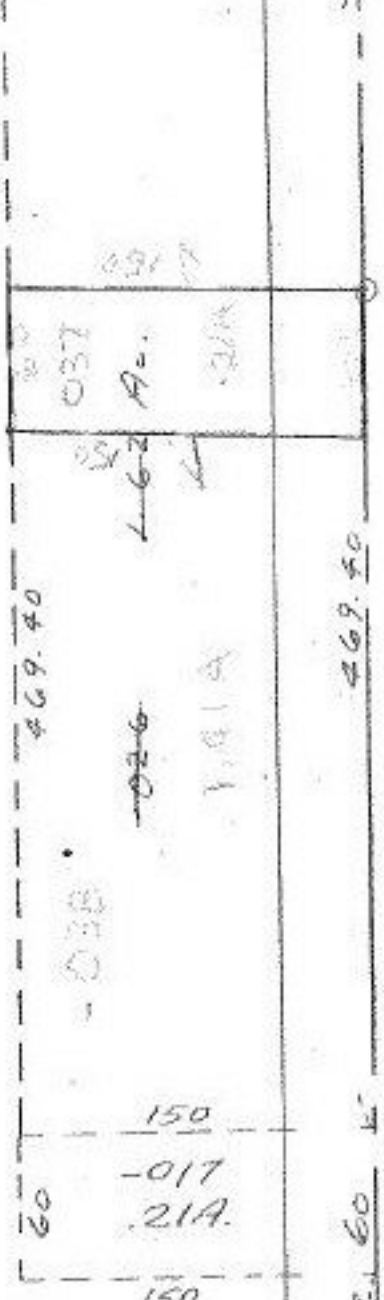

SEE 5-00-048-A

10-78

11418

RD. 230.0
211.63

