

APPROVED  
 LORAIN CO.  
 MAP DEPT.  
 DATE 2-21-78  
 CASE 5-00-094-B-C  
 BY C. Francis  
 VOID AFTER # 11428

-016

4.75 A.

585.10

220.60

11428 Check 4-7-78 Done (P. 103)

40' HORNWAX

See Vol 15 Pg 74 Plat

123

0.5

7.15

7.15






0.20

660

301.40

216.88

90'

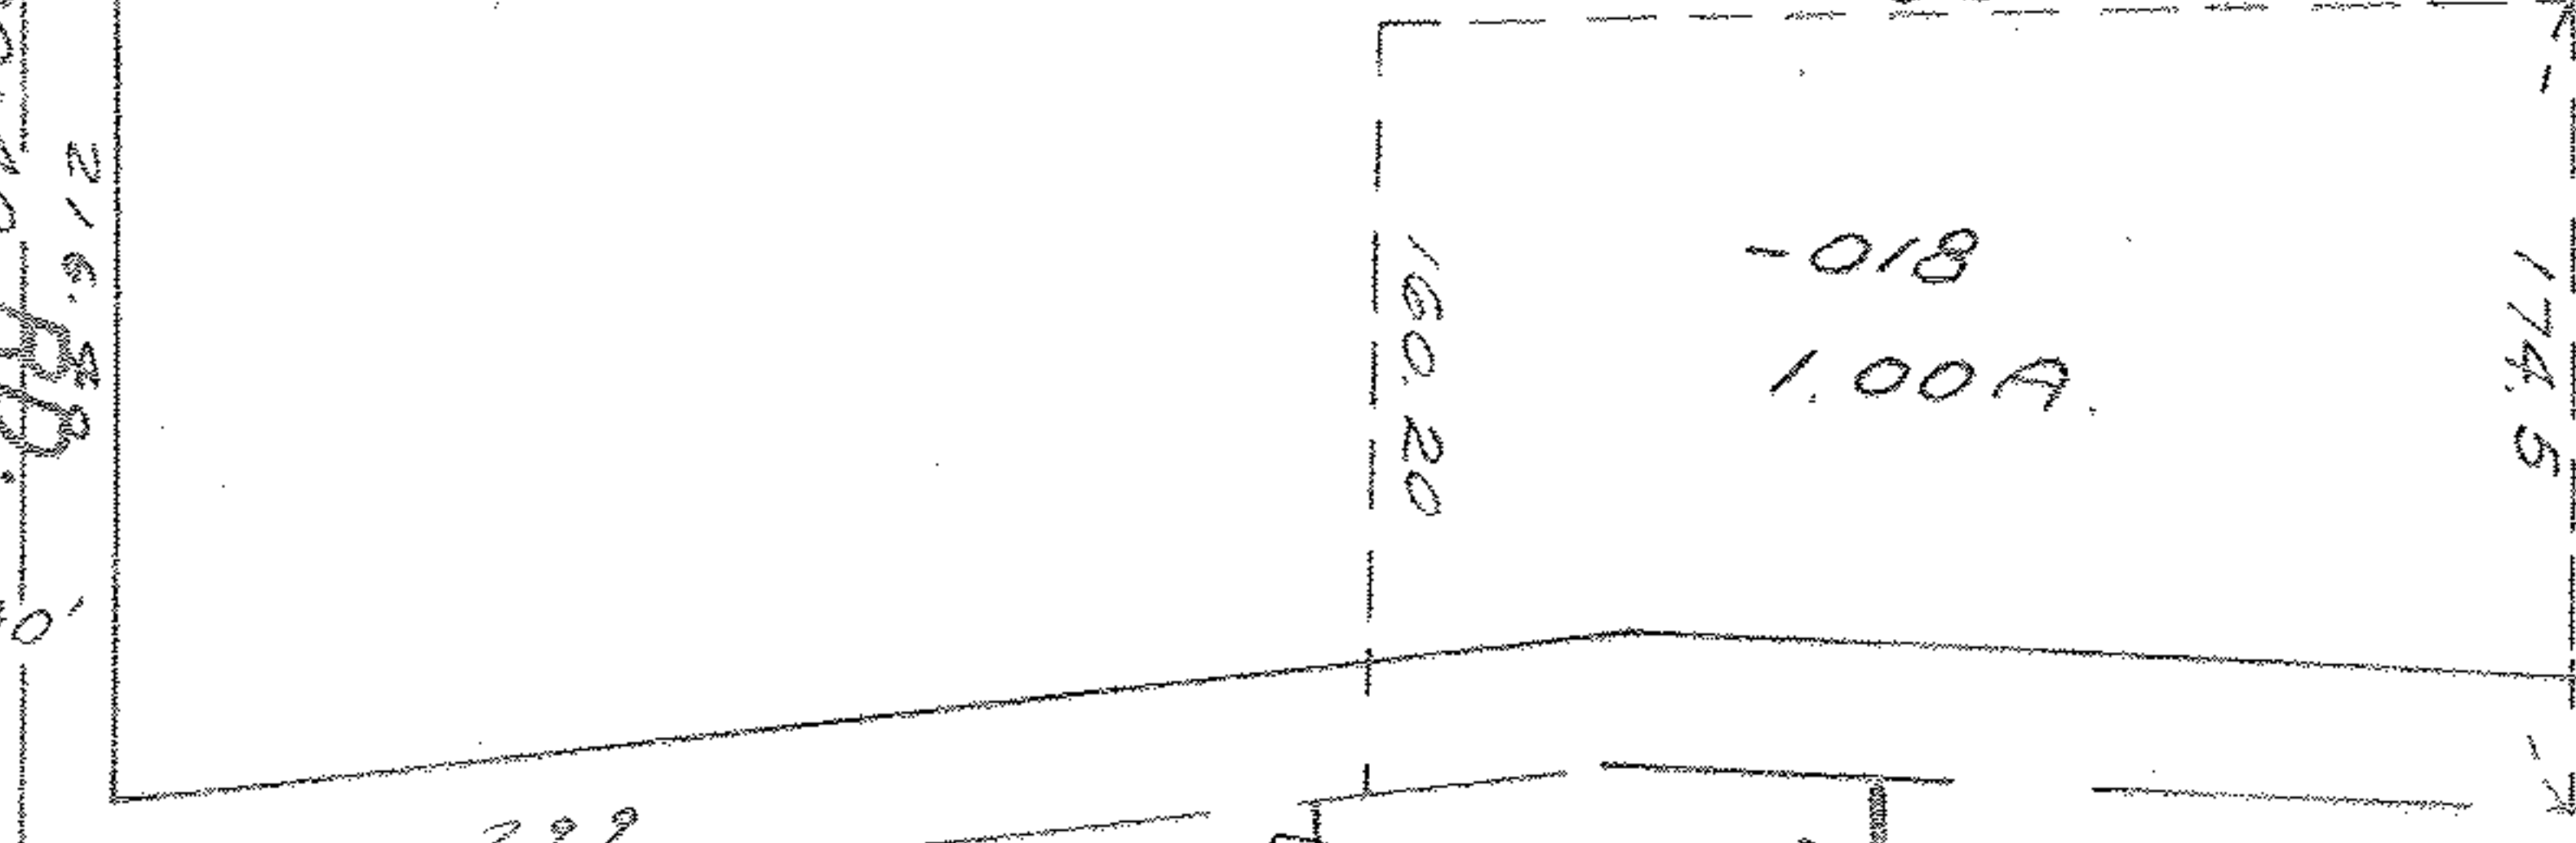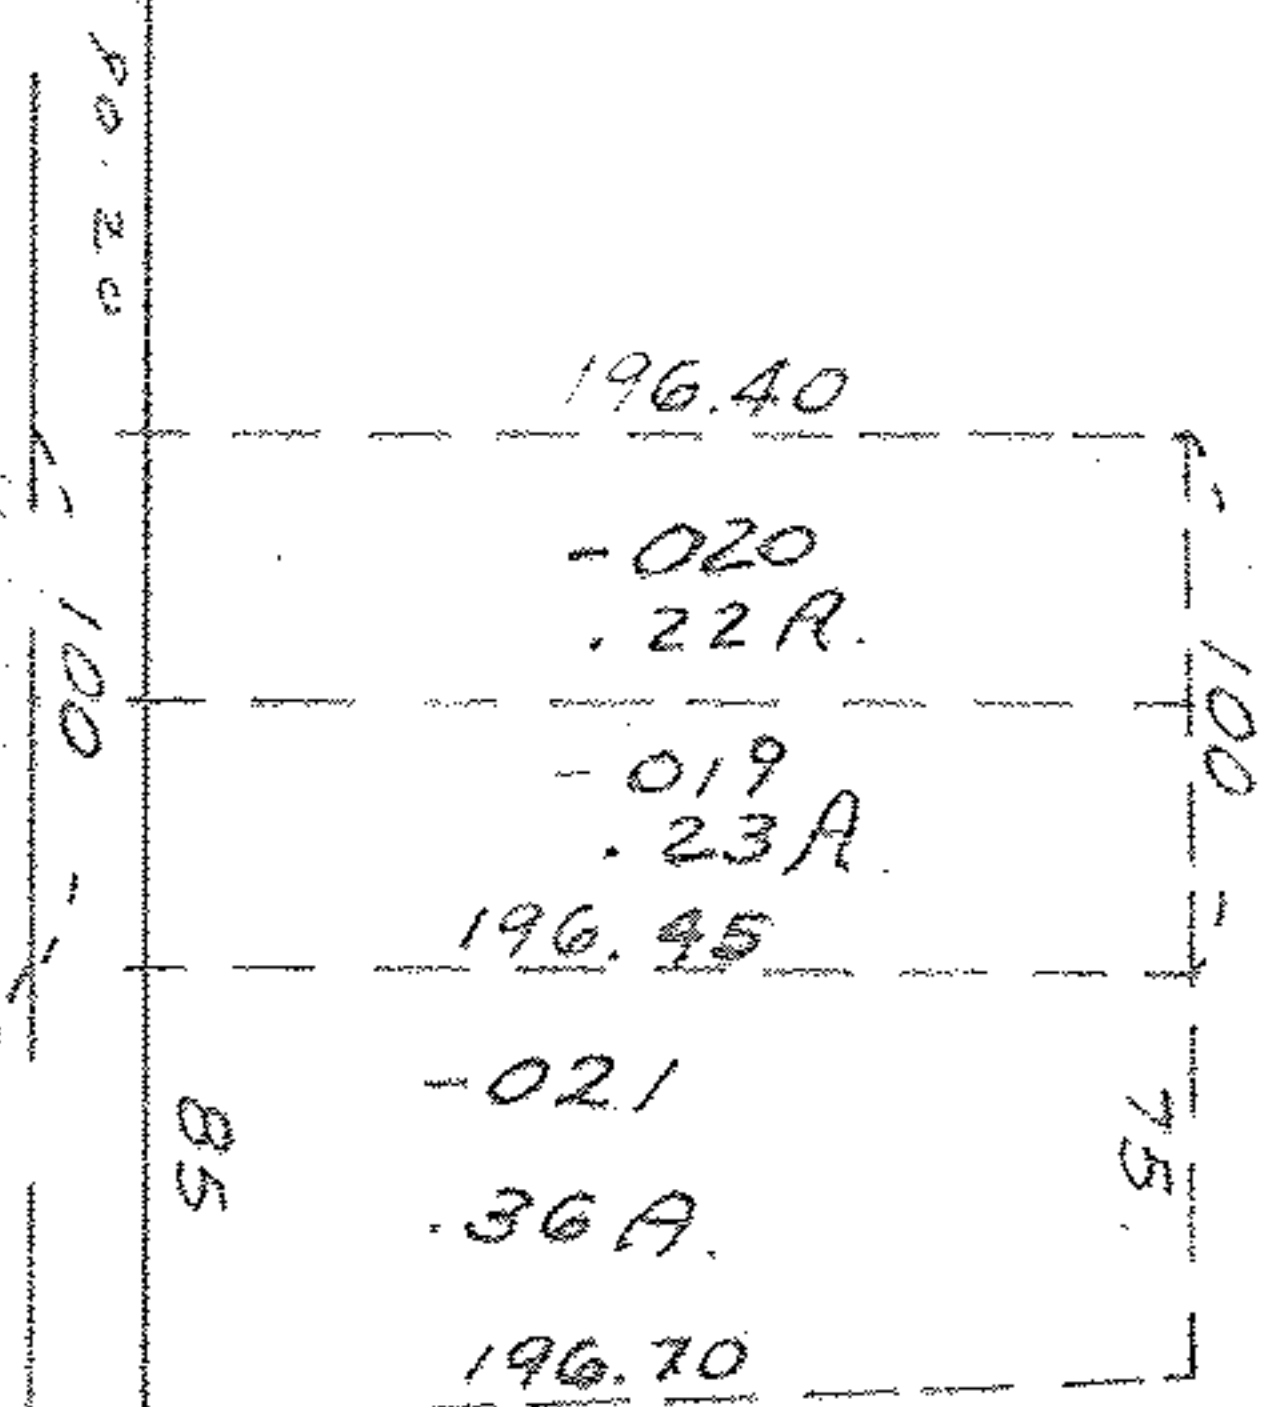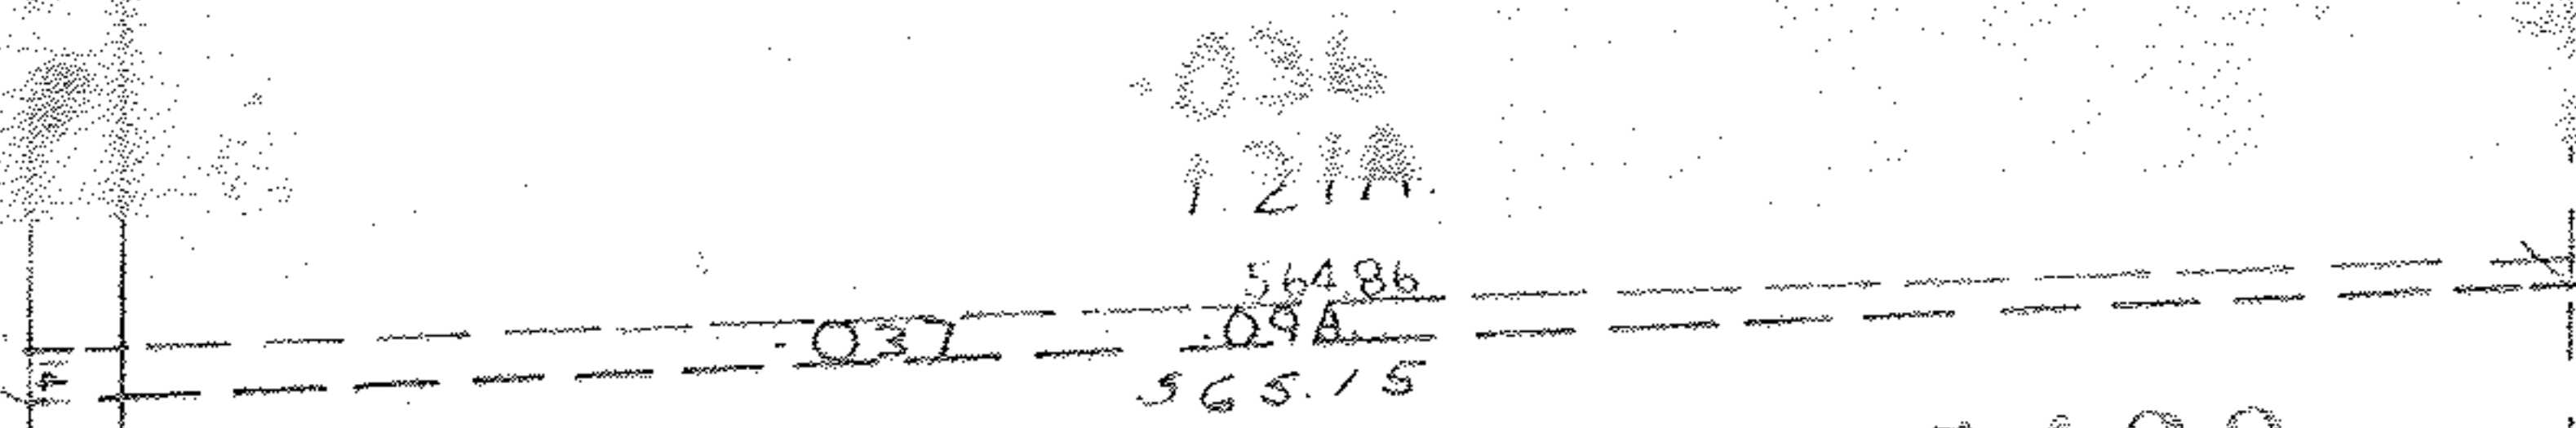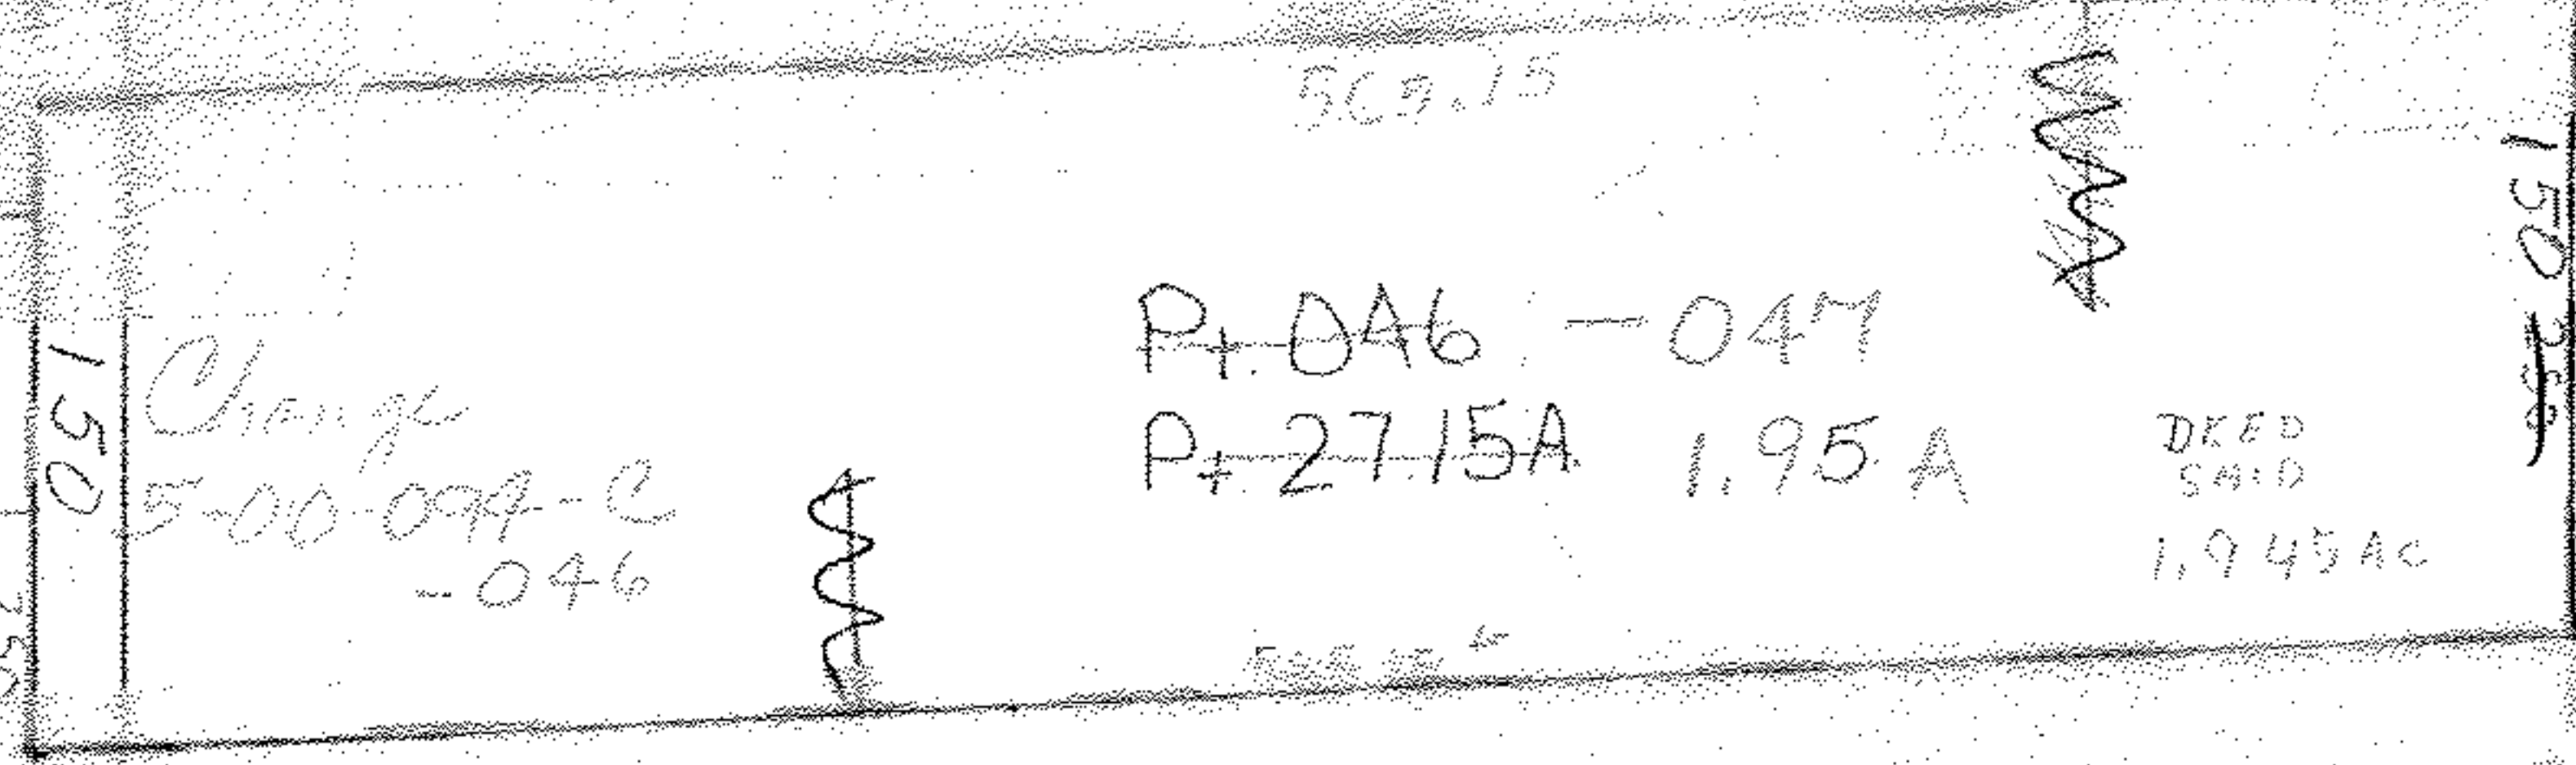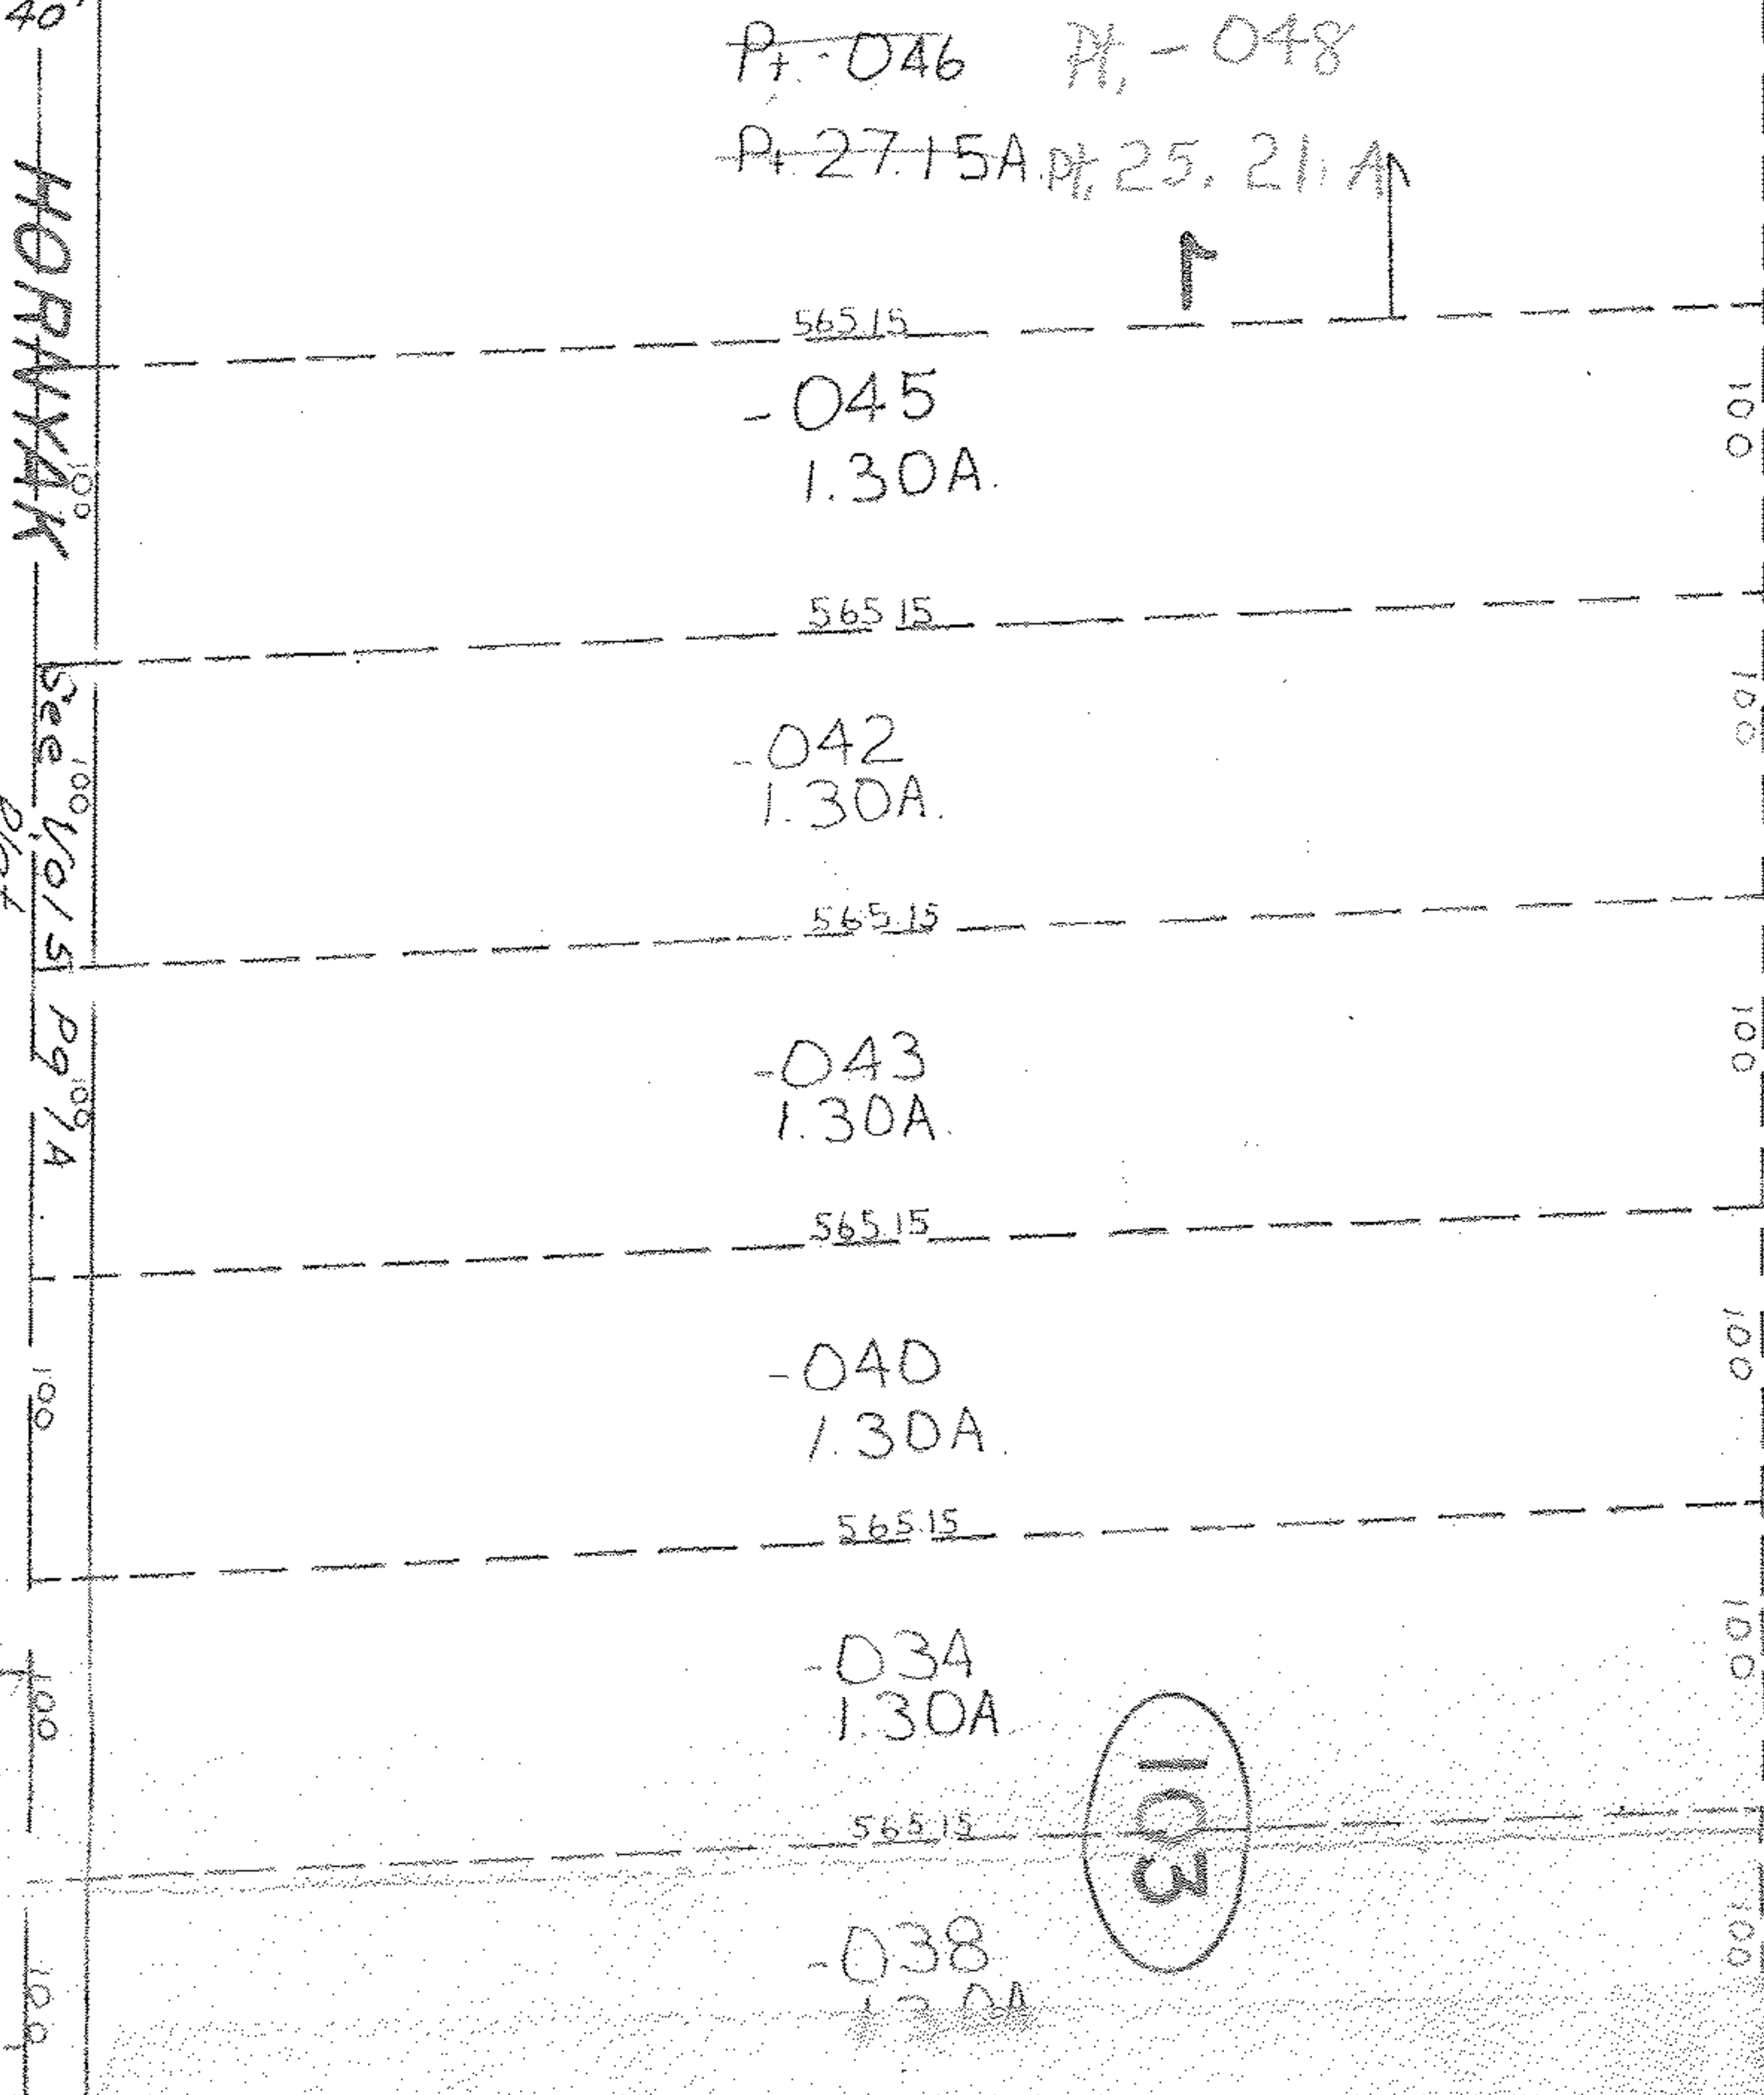

#11428

APPROVED  
 LORAIN CO.  
 MAP DEPT.  
 DATE 2-21-78  
 CASE 5-00-094-B  
 BY C. Francis  
 # 11428

SEE 5-00-094-C