

11441


11441

SE E

SE E

ACKERMAN RD.

RD.

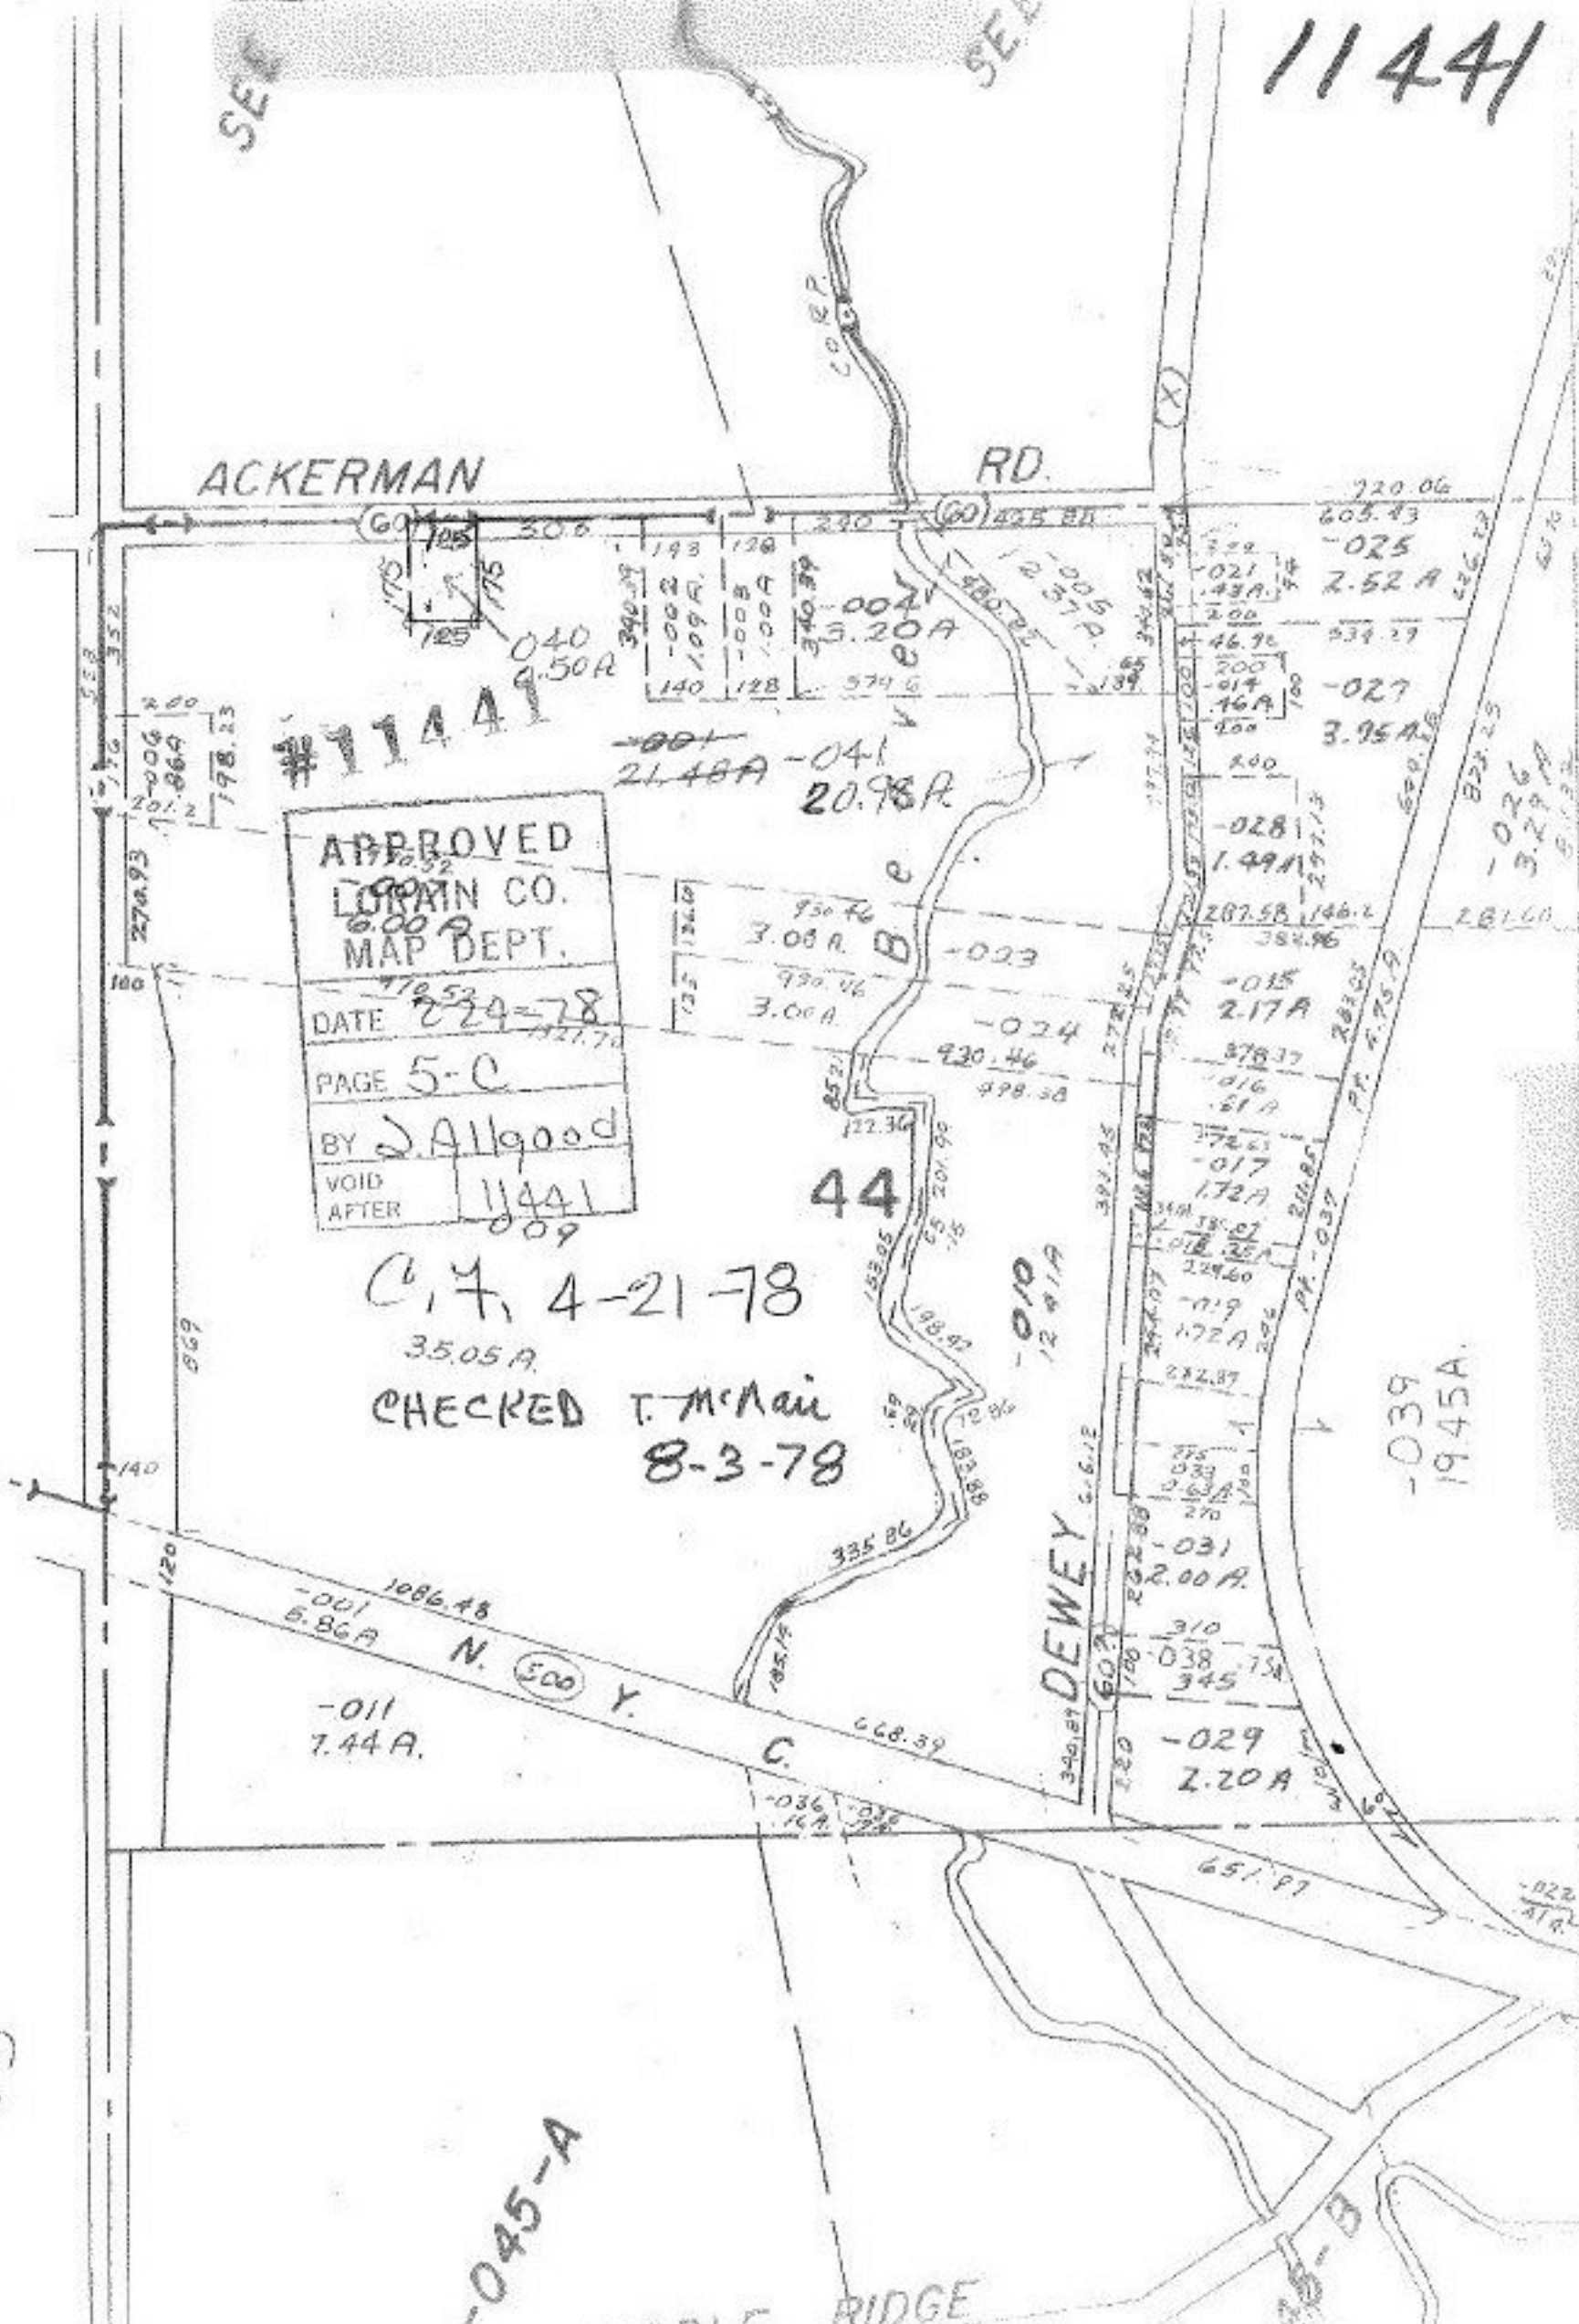

#11441

APPROVED
 LORAIN CO.
 MAP DEPT.
 DATE 2-24-78
 PAGE 5-C
 BY J. Allgood
 VOID AFTER 11441

CITY 4-21-78

CHECKED T. McMan 8-3-78

44

-045-A

MIDDLE RIDGE

-039
1945A

-022
A/R

