

-029
61.03A #11447


APPROVED
LORAIN CO.
MAP DEPT.

DATE 3-2-78

PAGE 1-K

BY T. McHale

VOID AFTER 11447

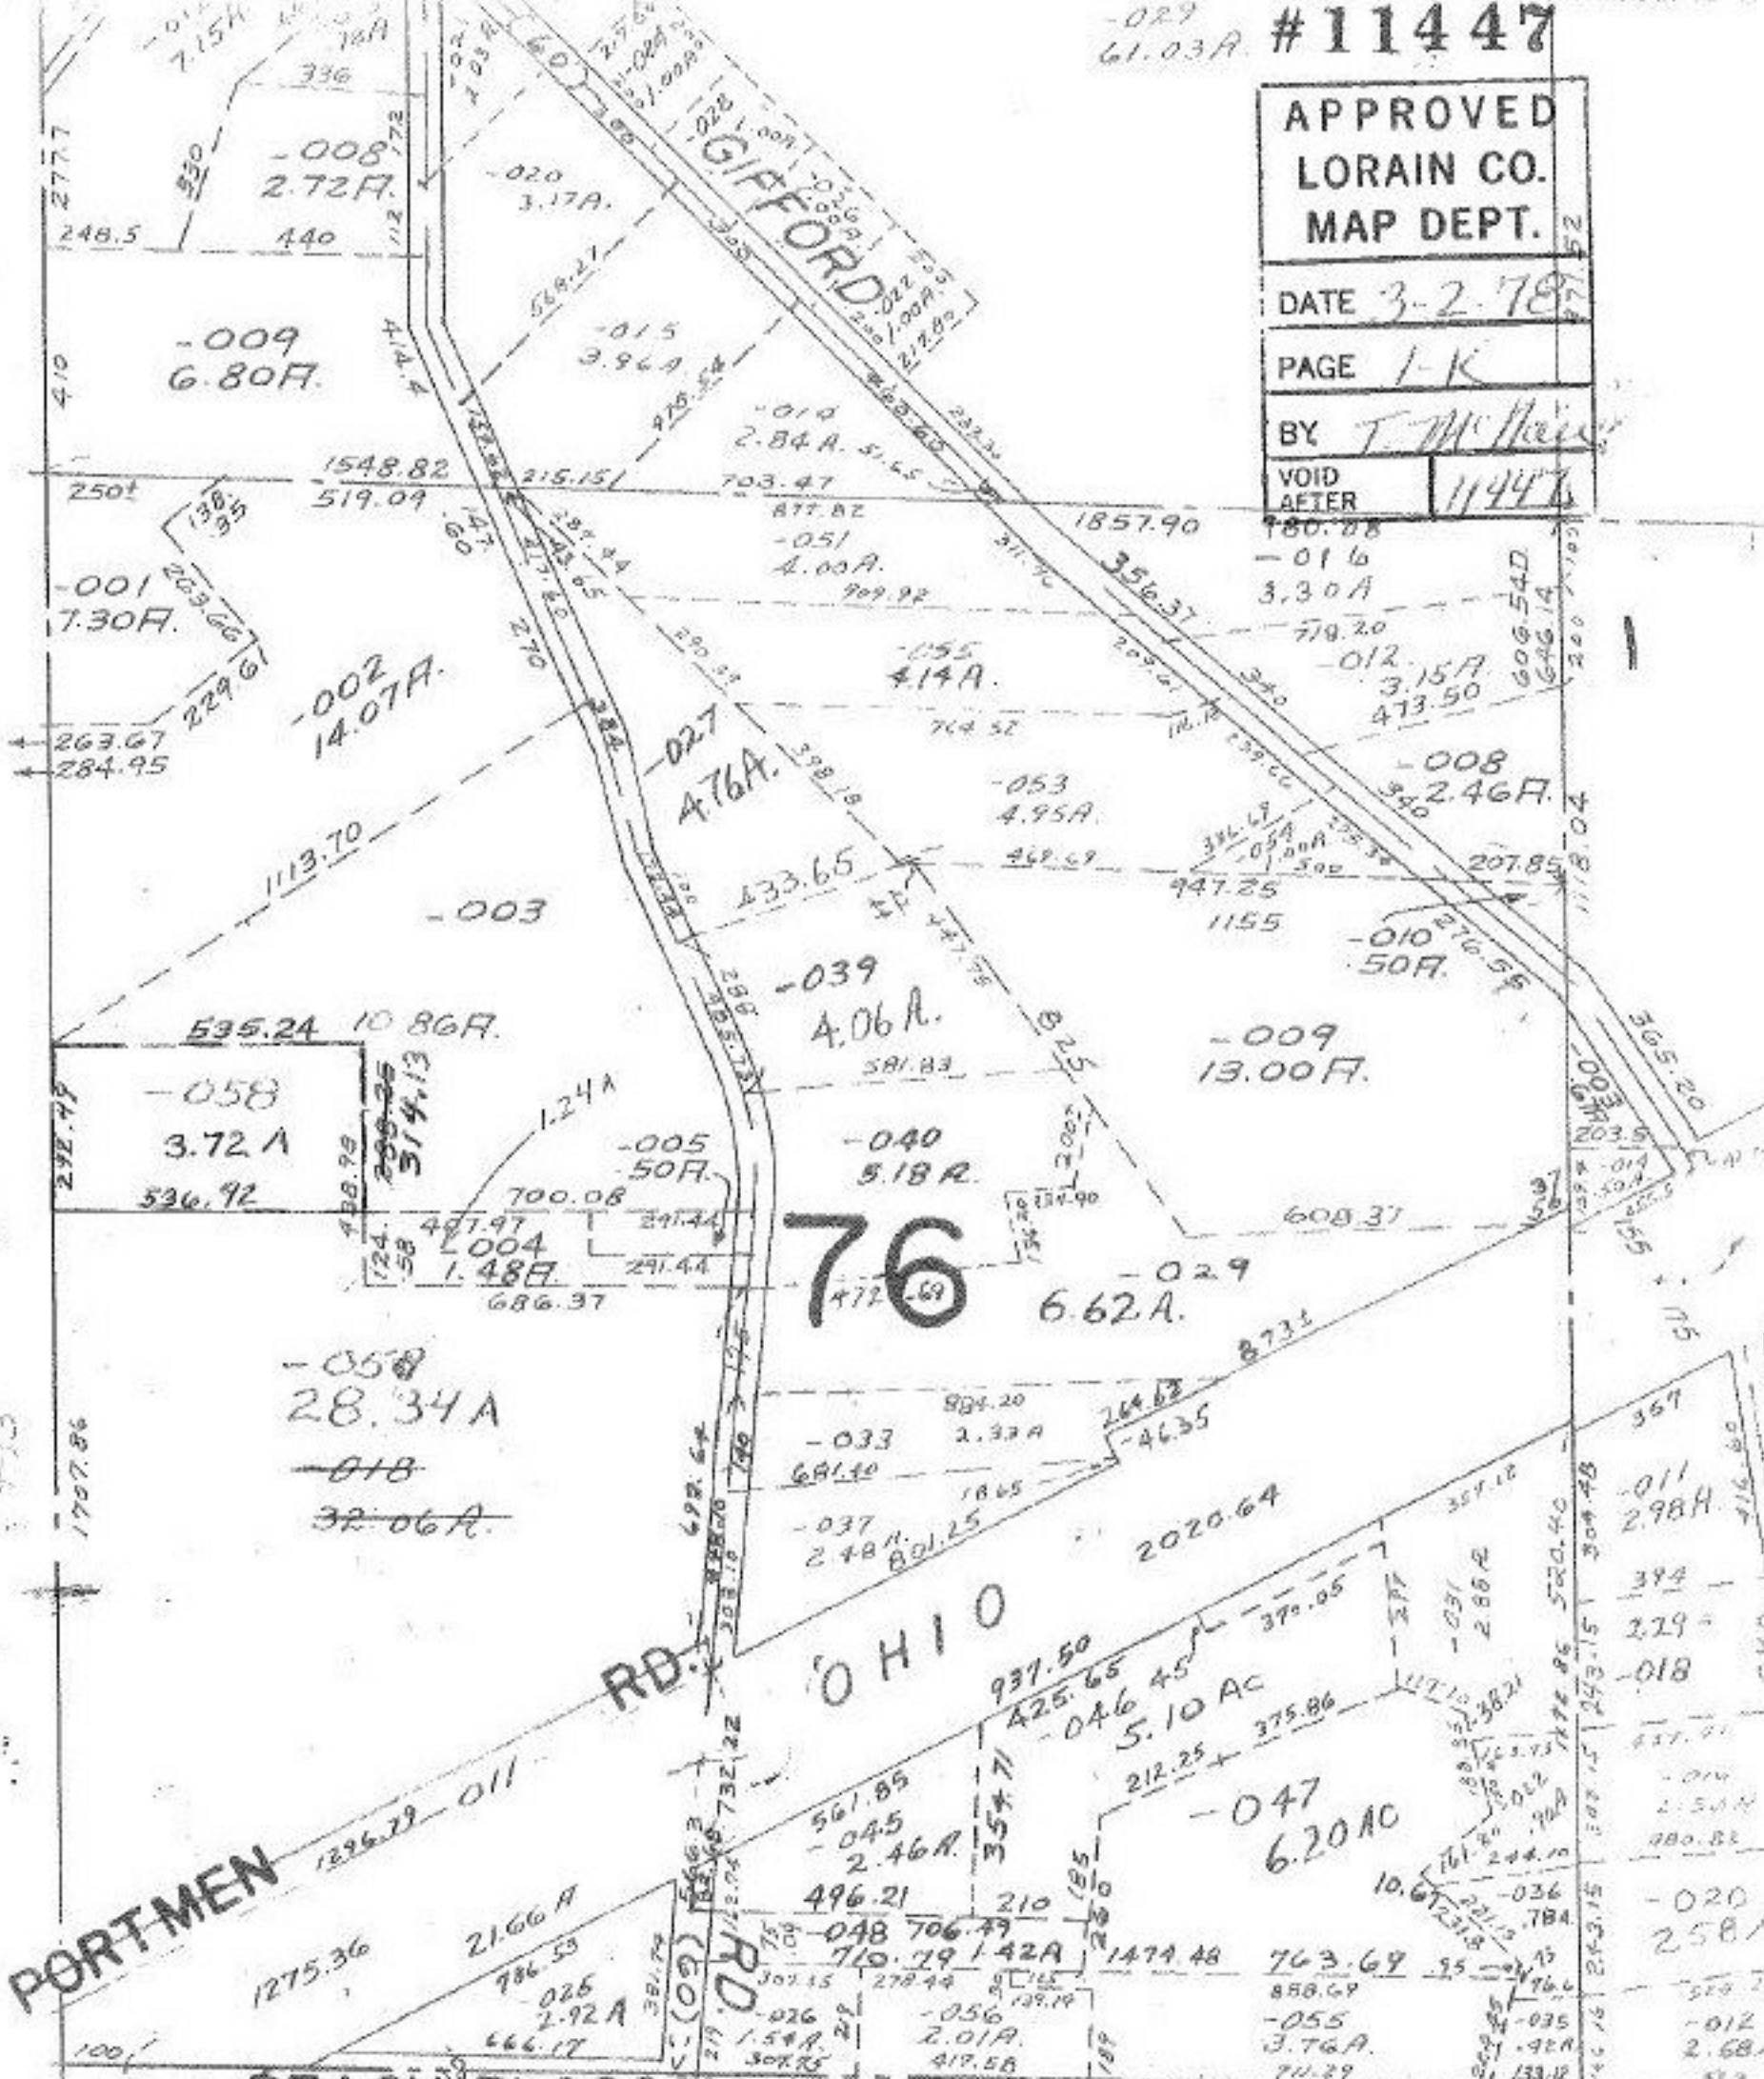

7-8
125
413

PORTMEN

PEACH BLOSSOM
LANE

Ca Comm. Rel. No 77-118
2-22-1977