


11458

11458

#11458

3-6-73
7-00-011-C
7-00-014-D
C. Francis
11458

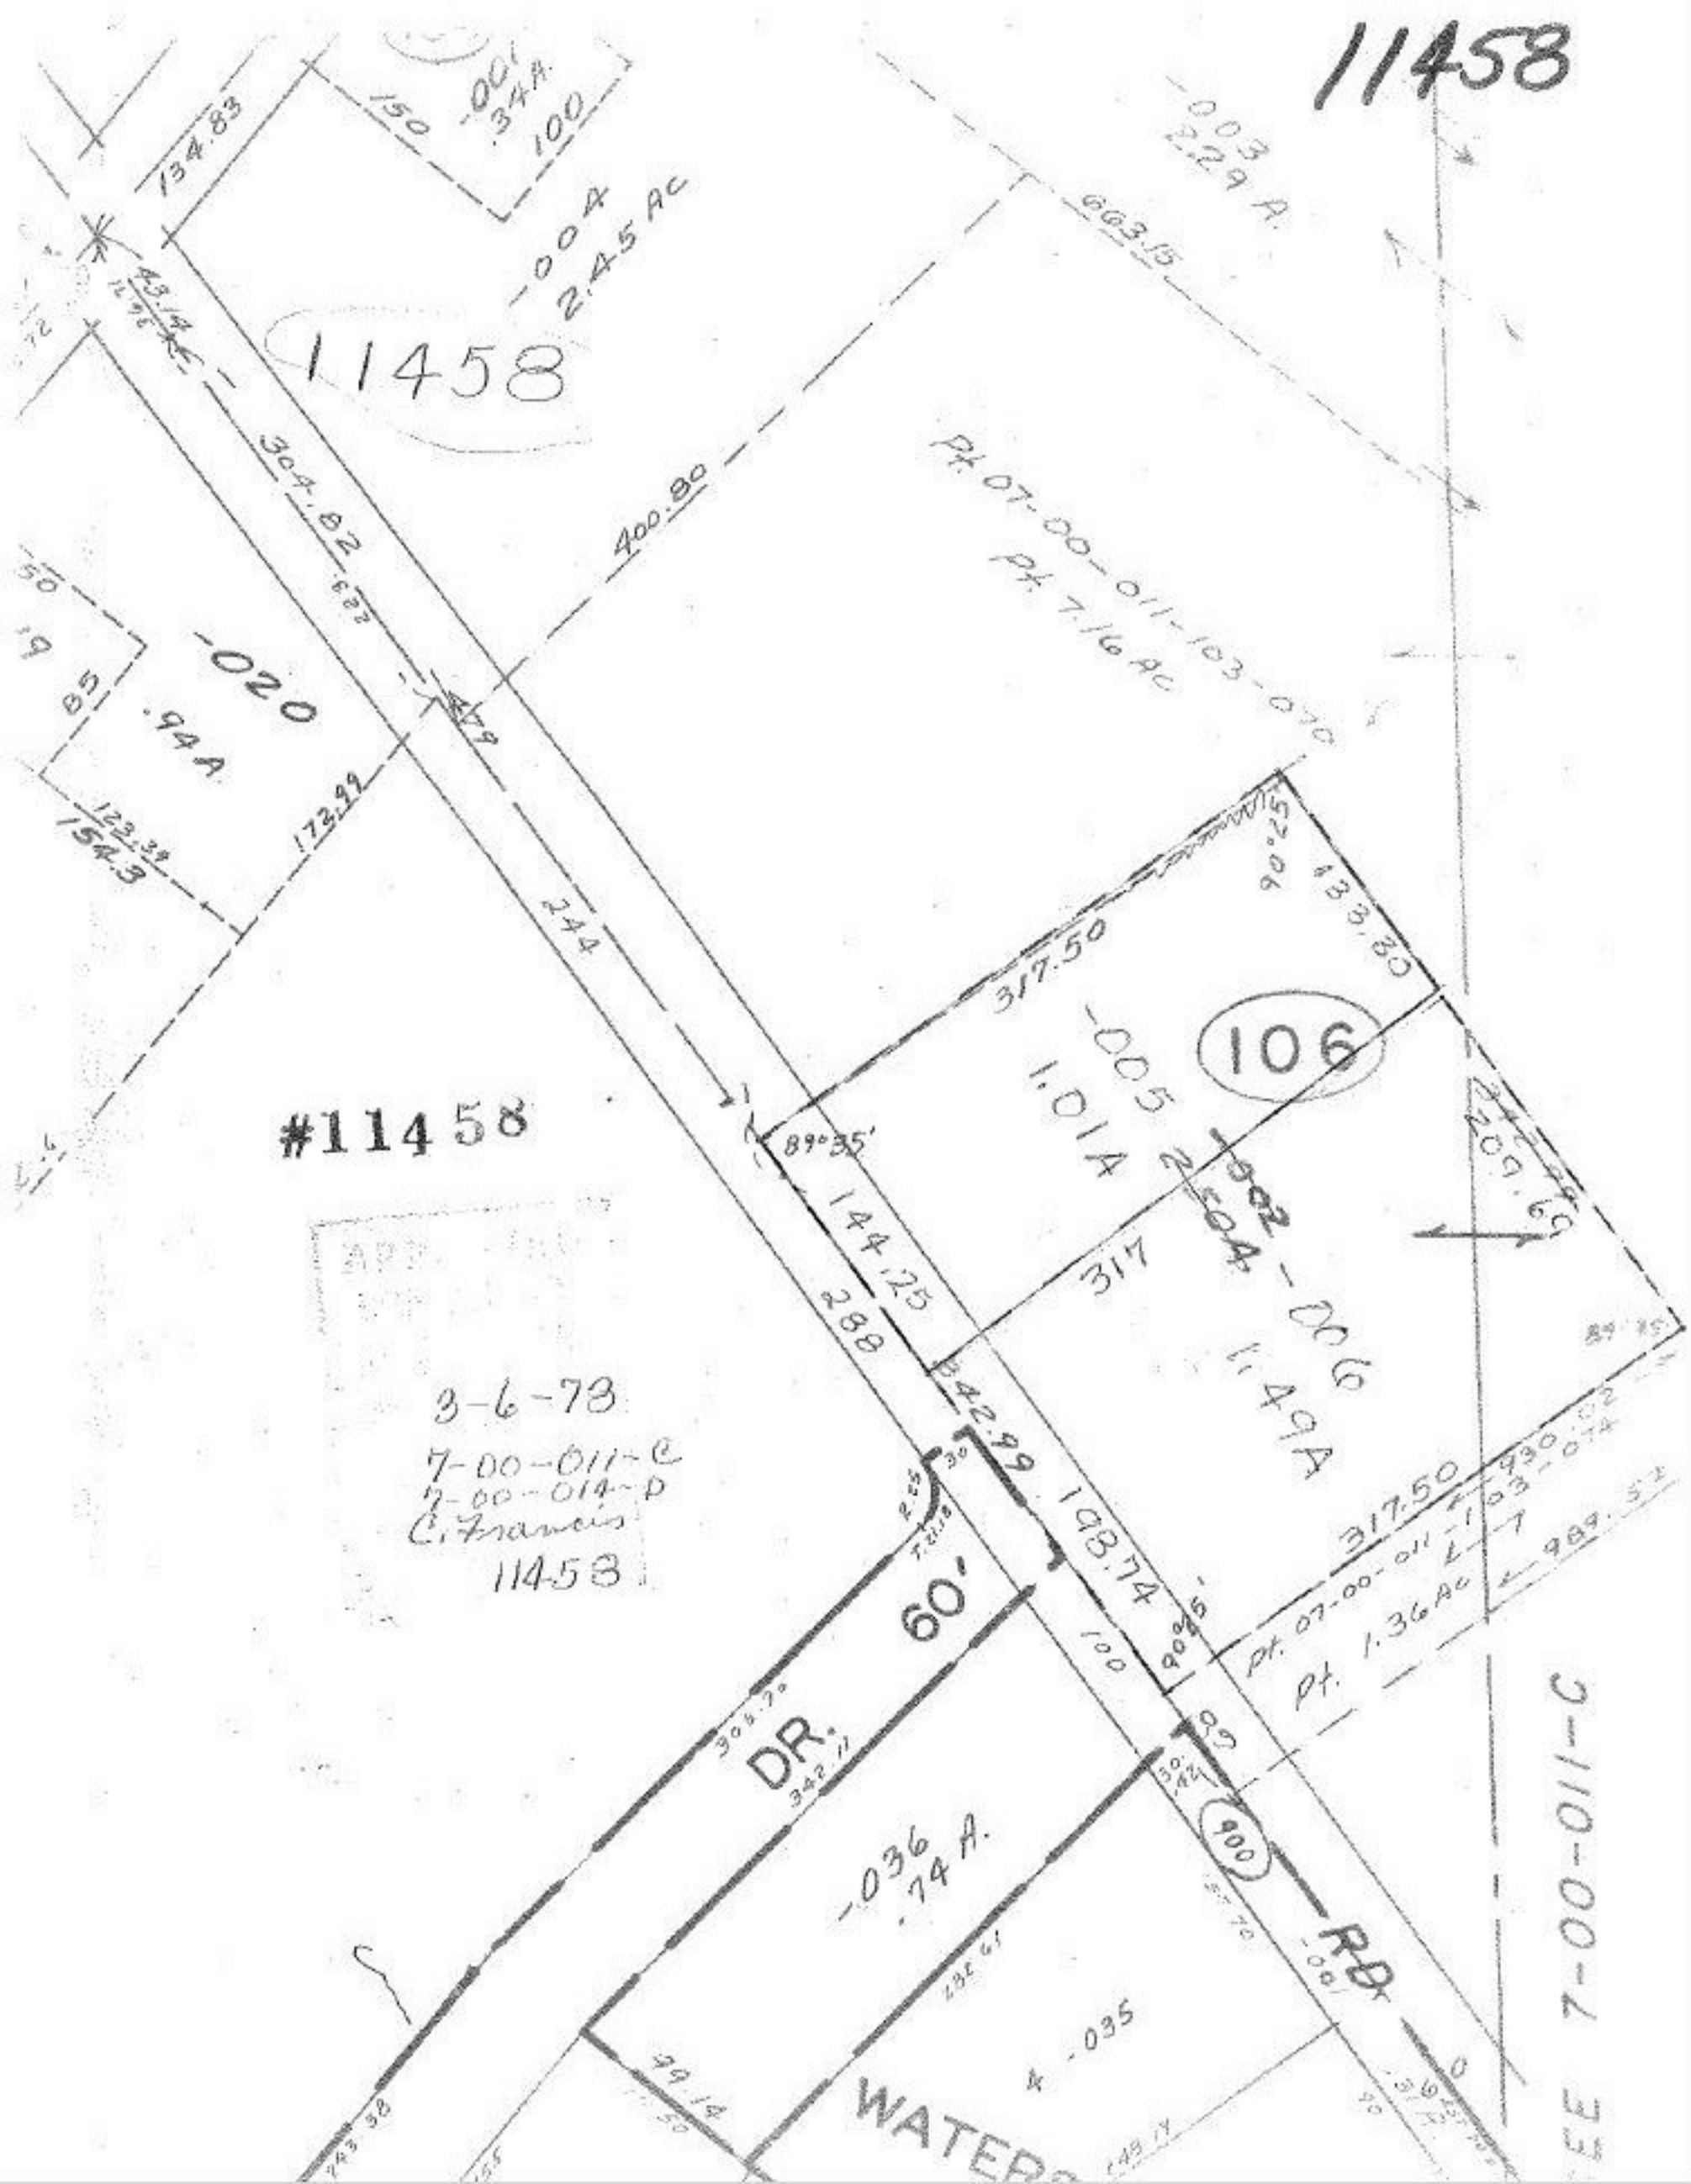

SEE 7-00-011-C