


MAKE 2 COPIES

11477

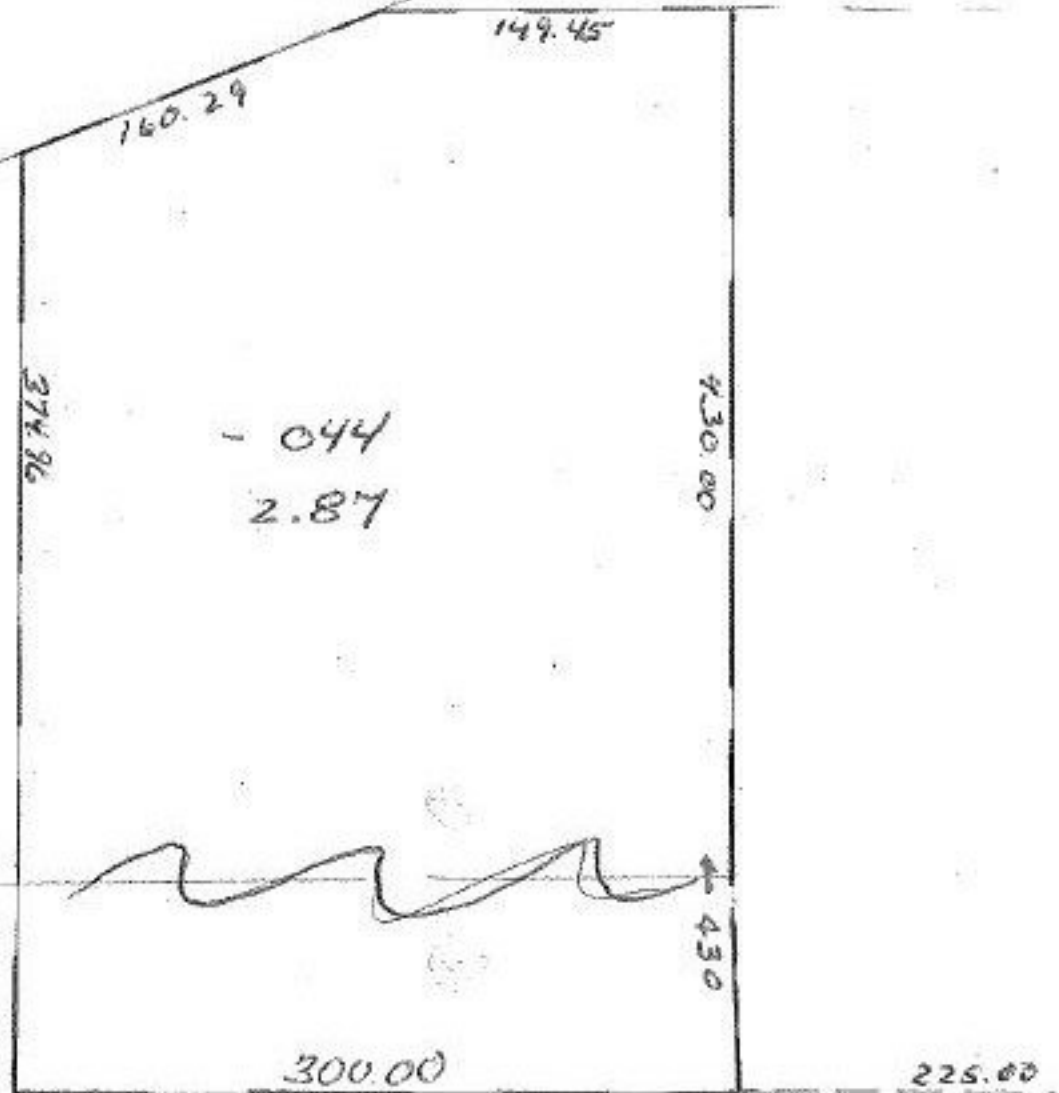

-143

1

~~Pt. -023~~
~~Pt. 17.14A~~

Pt. -045
Pt. 14.27A

APPROVED
LORAIN CO.
MAP DEPT.
DATE 3-10-78
PAGE 6-144
BY T. McNeil
VOID AFTER 11477

Check Done 4-7-78 OK.

615
775

-019
4.45 R.

250