


11478

11478

#11478

| | |
|-------------------------------------|-------|
| APPROVED LORAIN CO. MAP DEPT. | |
| DATE 3-14-78 | |
| PAGE 11-A | |
| BY T. McNamee | |
| VOID AFTER | 11478 |

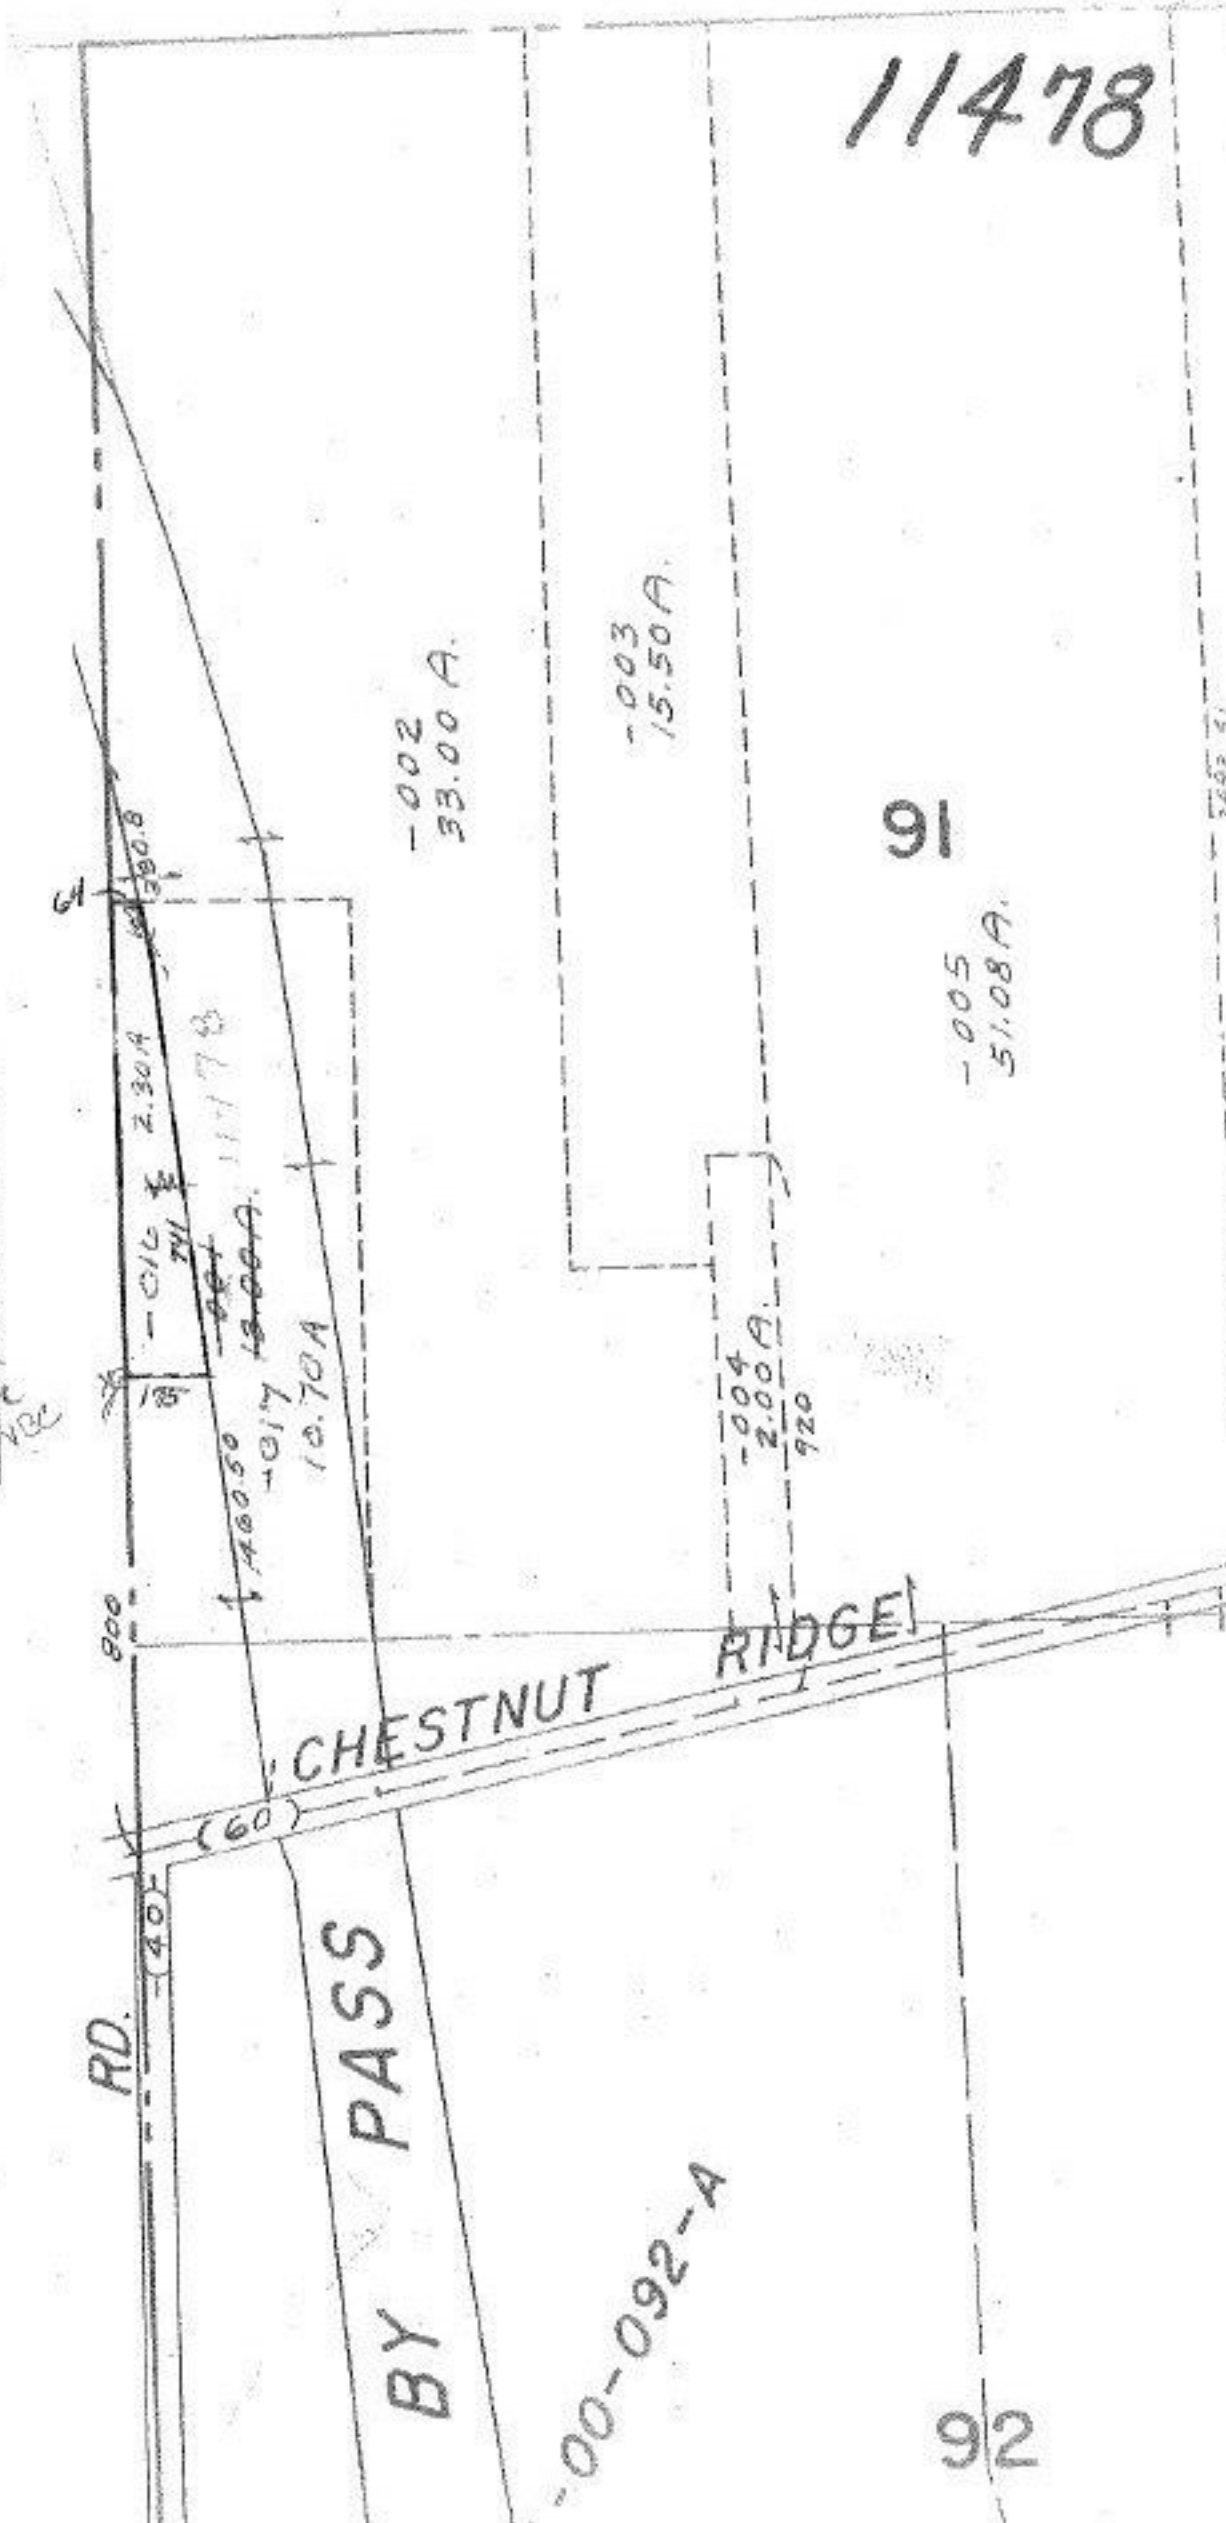

RD.

CHESTNUT RIDGE

BY PASS

-00-092-A

64

800

(40)

-016 2.30 A

-017 13.00 A

-002 33.00 A

-003 15.50 A

-004 2.00 A

-005 51.08 A

91

92

3492.51