


5-B

303

11487

ST.

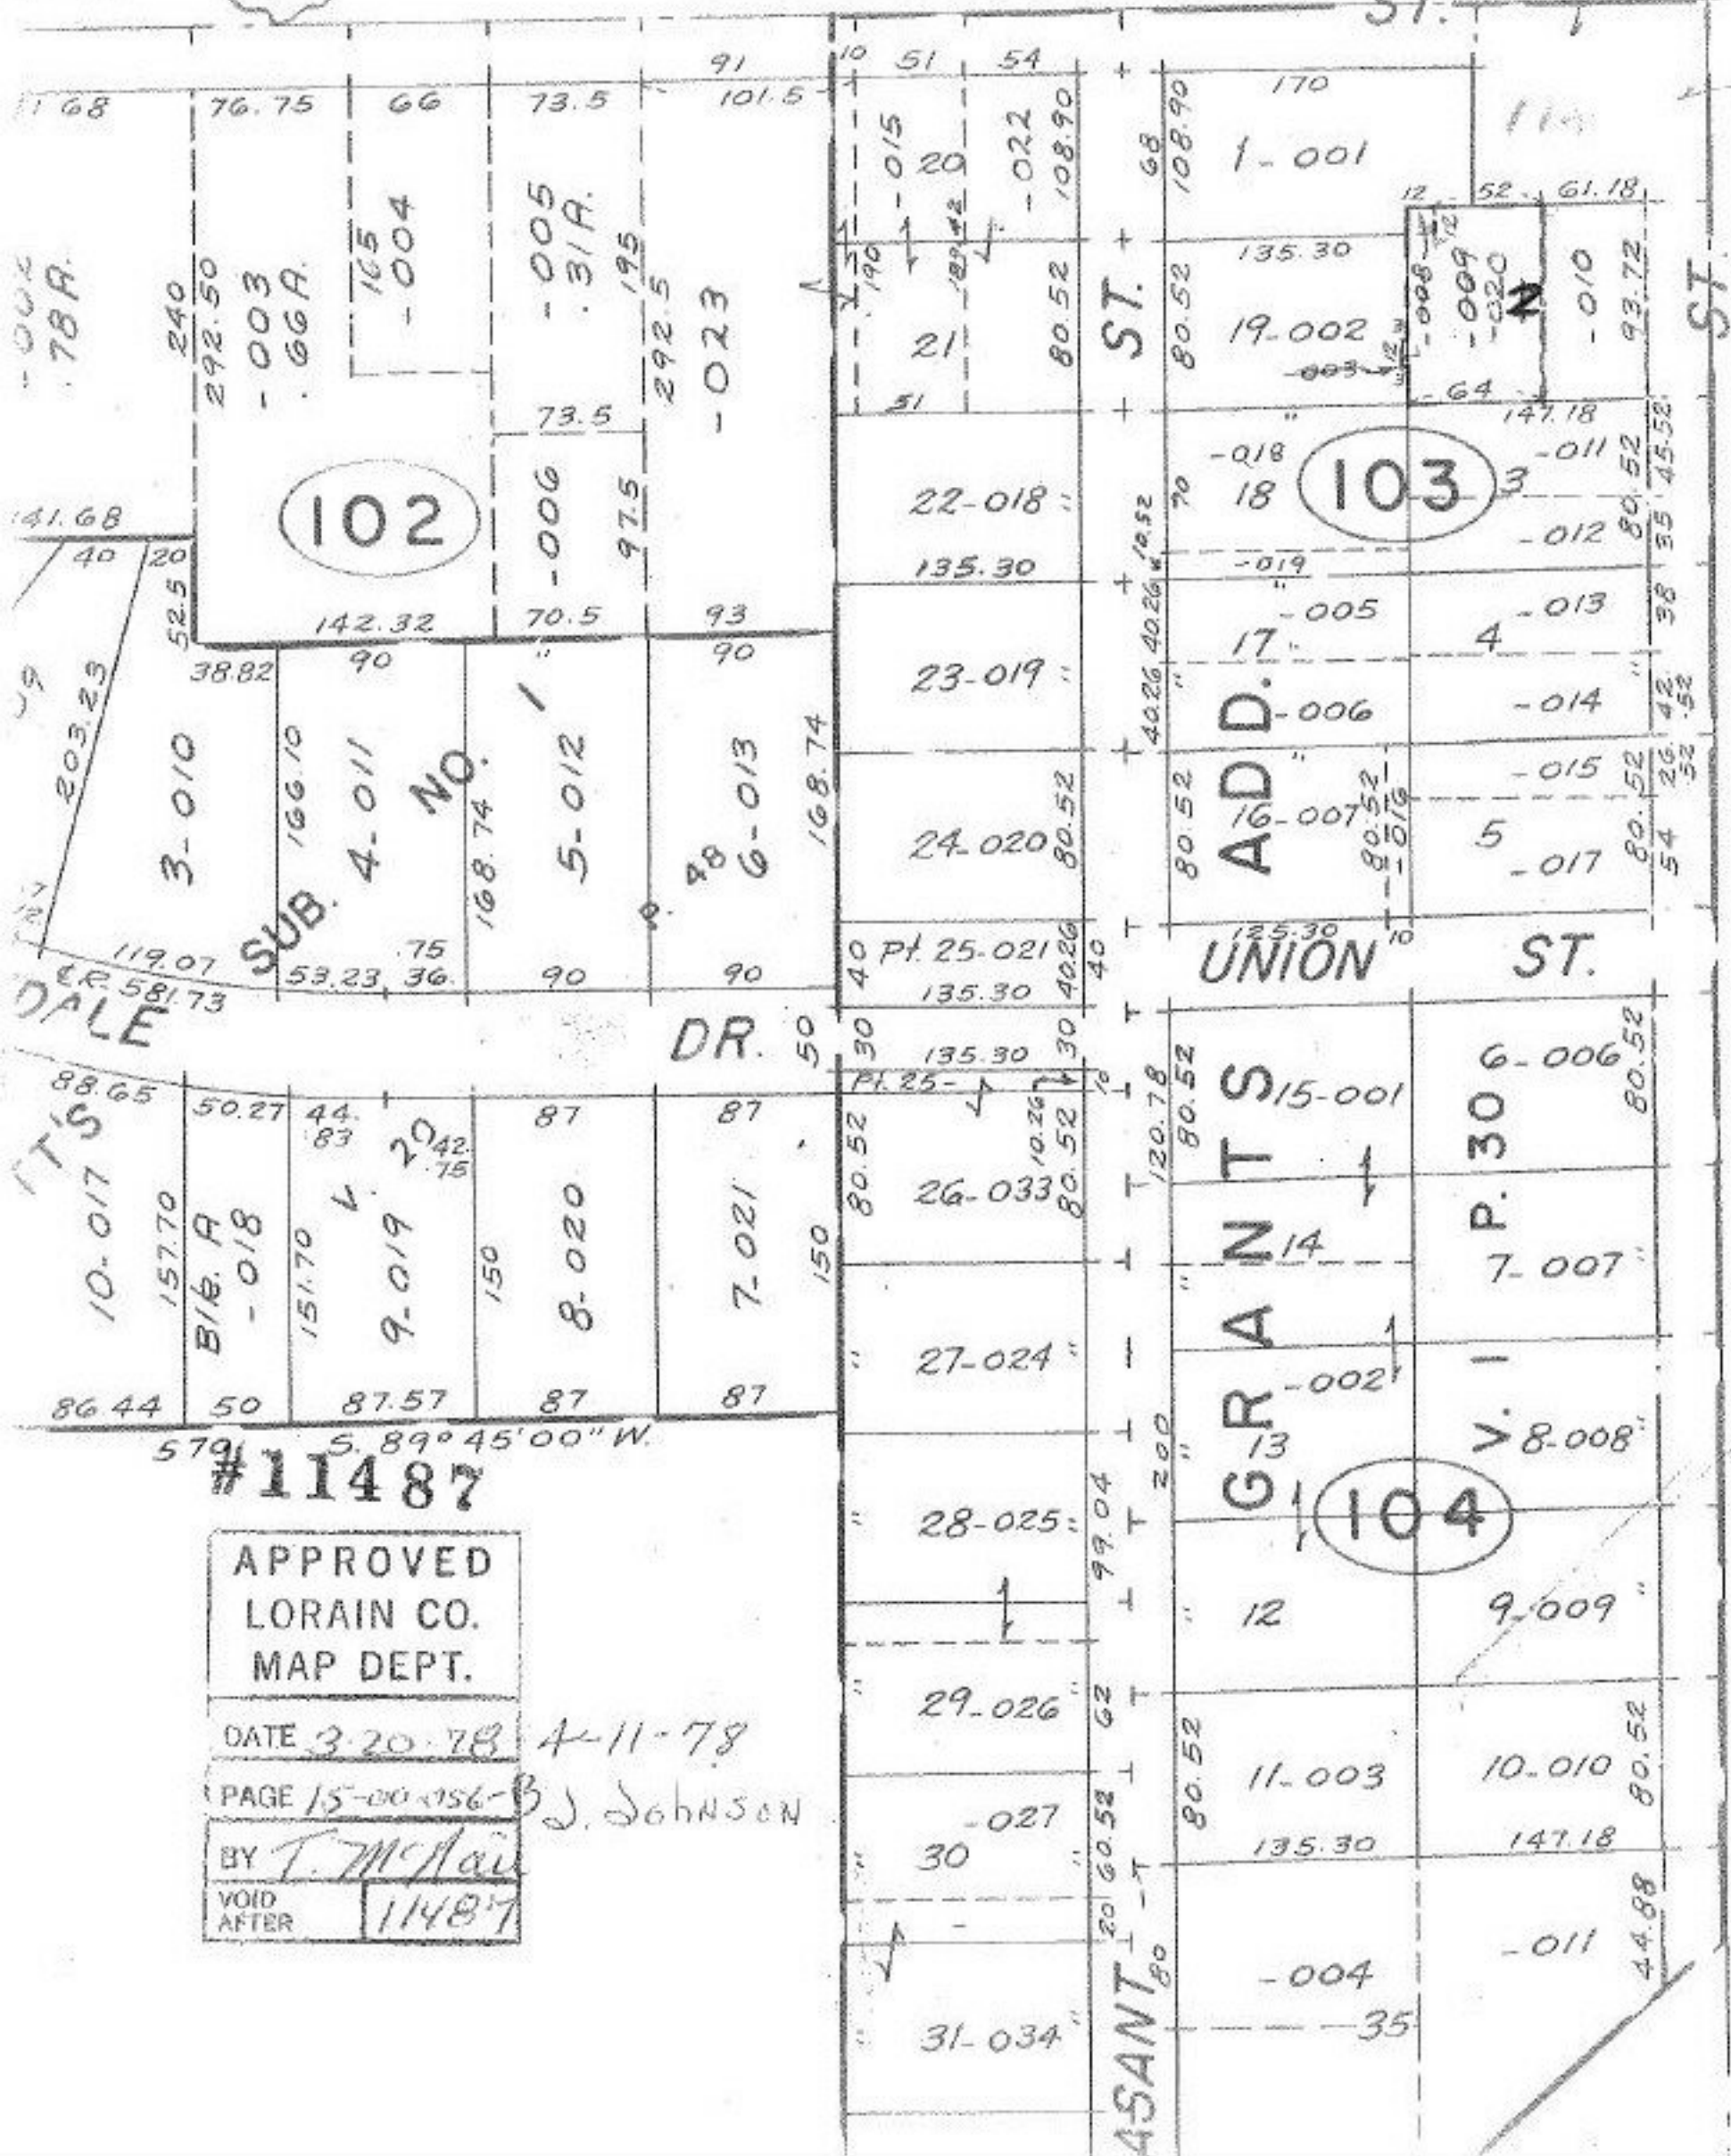

#11487

APPROVED
LORAIN CO.
MAP DEPT.

DATE 3-20-78 4-11-78

PAGE 15-00-156-B J. JOHNSON

BY T. McAvoy

VOID AFTER 11487