


11490

SEE

SEE

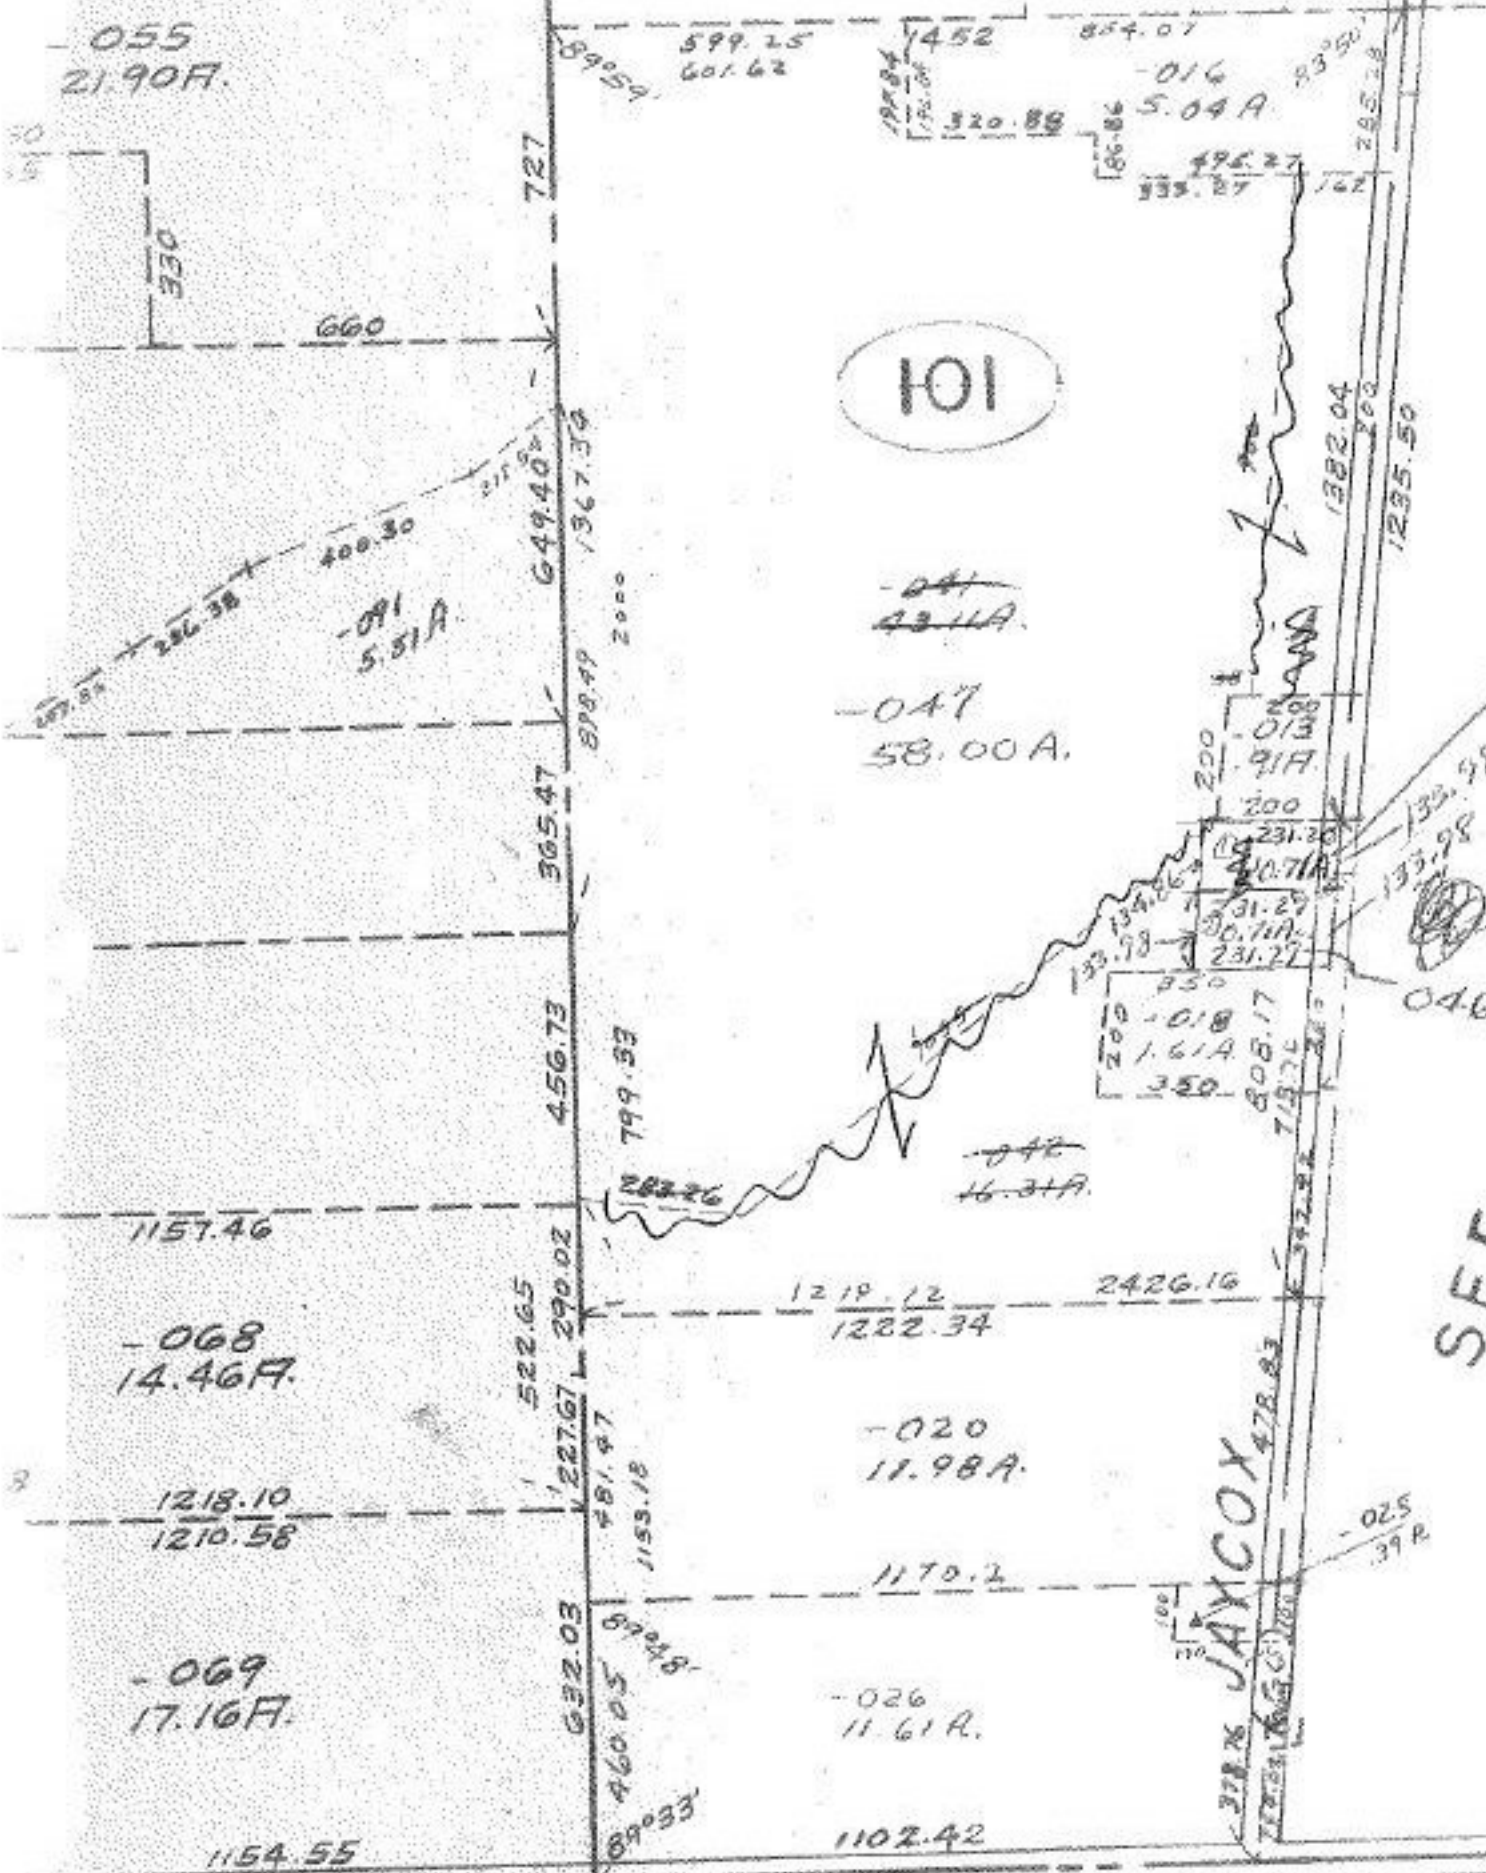

101

4-00-024 F

SEE

#11490

APPROVED LORAIN CO. MAP DEPT.	
DATE 3-23-78	4/2/78
PAGE A-K	a.a.
BY <i>[Signature]</i>	
VOID AFTER	

SEE 7-C

ITV

E