

11492

35.68  
1.08  
34.60

~~025~~ 025  
34.60 A

(101)

# 11492

~~# 11469~~

APPROVED  
LORAIN CO.  
MAP DEPT.


DATE 3-20-78

PROJECT-03-023-A

BY Q. T. McNeil

VOID AFTER 11492

C. Z. 4-7-78

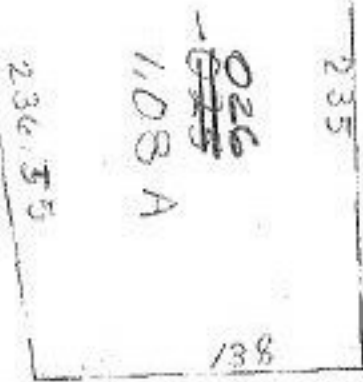

JERUS ALEM

310

349.60