

100
100

10-00-015-101-020
460.08

460

-059
1.37 A.

460
459.98

-091
0.97 A.

459.93

-094
1.06 A.

460.87

-081
0.65 A.

249.47
300

11504
Pt. 10-00-015/101-020

~~Pt. 13.66 A.~~

Pt. 12.91 A.

-113
0.75 A.

#11504

300

APPROVED
LORAIN CO. MAP DEPT

DATE 3-23-78

PAGE 10-00-015-101-019

BY M. Holland

VOID AFTER

11504

-0768-10-78
.85 A.

249.35

330
-039
.60 A.

330

~~10-00-014~~
-106
61A


125

Pt. 1.56 A.
286.68

10-00-019-000

-057
1.00 A.

78

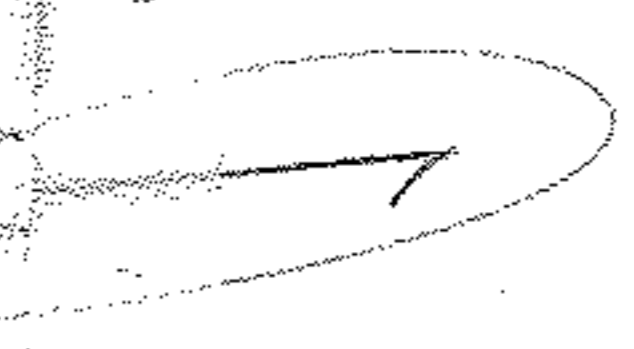

CHANGE NEXT PAGE

11504

(10/00/015/101/001)

-025
.63A.

Pt. -019 Pt.
220.38

-011
1.00 A.

220.38

INDIAN HOLLOW

117.43

80.08

154

106.42

118.05

106.42

116.06

92.96

100

130

130

107.51

141.51

200.68

125

225

156.12

197.66

78

78

200

220

156.12

197.66

78

78

136.28

136.28

220.38