

11505

SEE 4-00-002-H

164

330


420

1172.69

20434


107

SEE 4-00-011-F

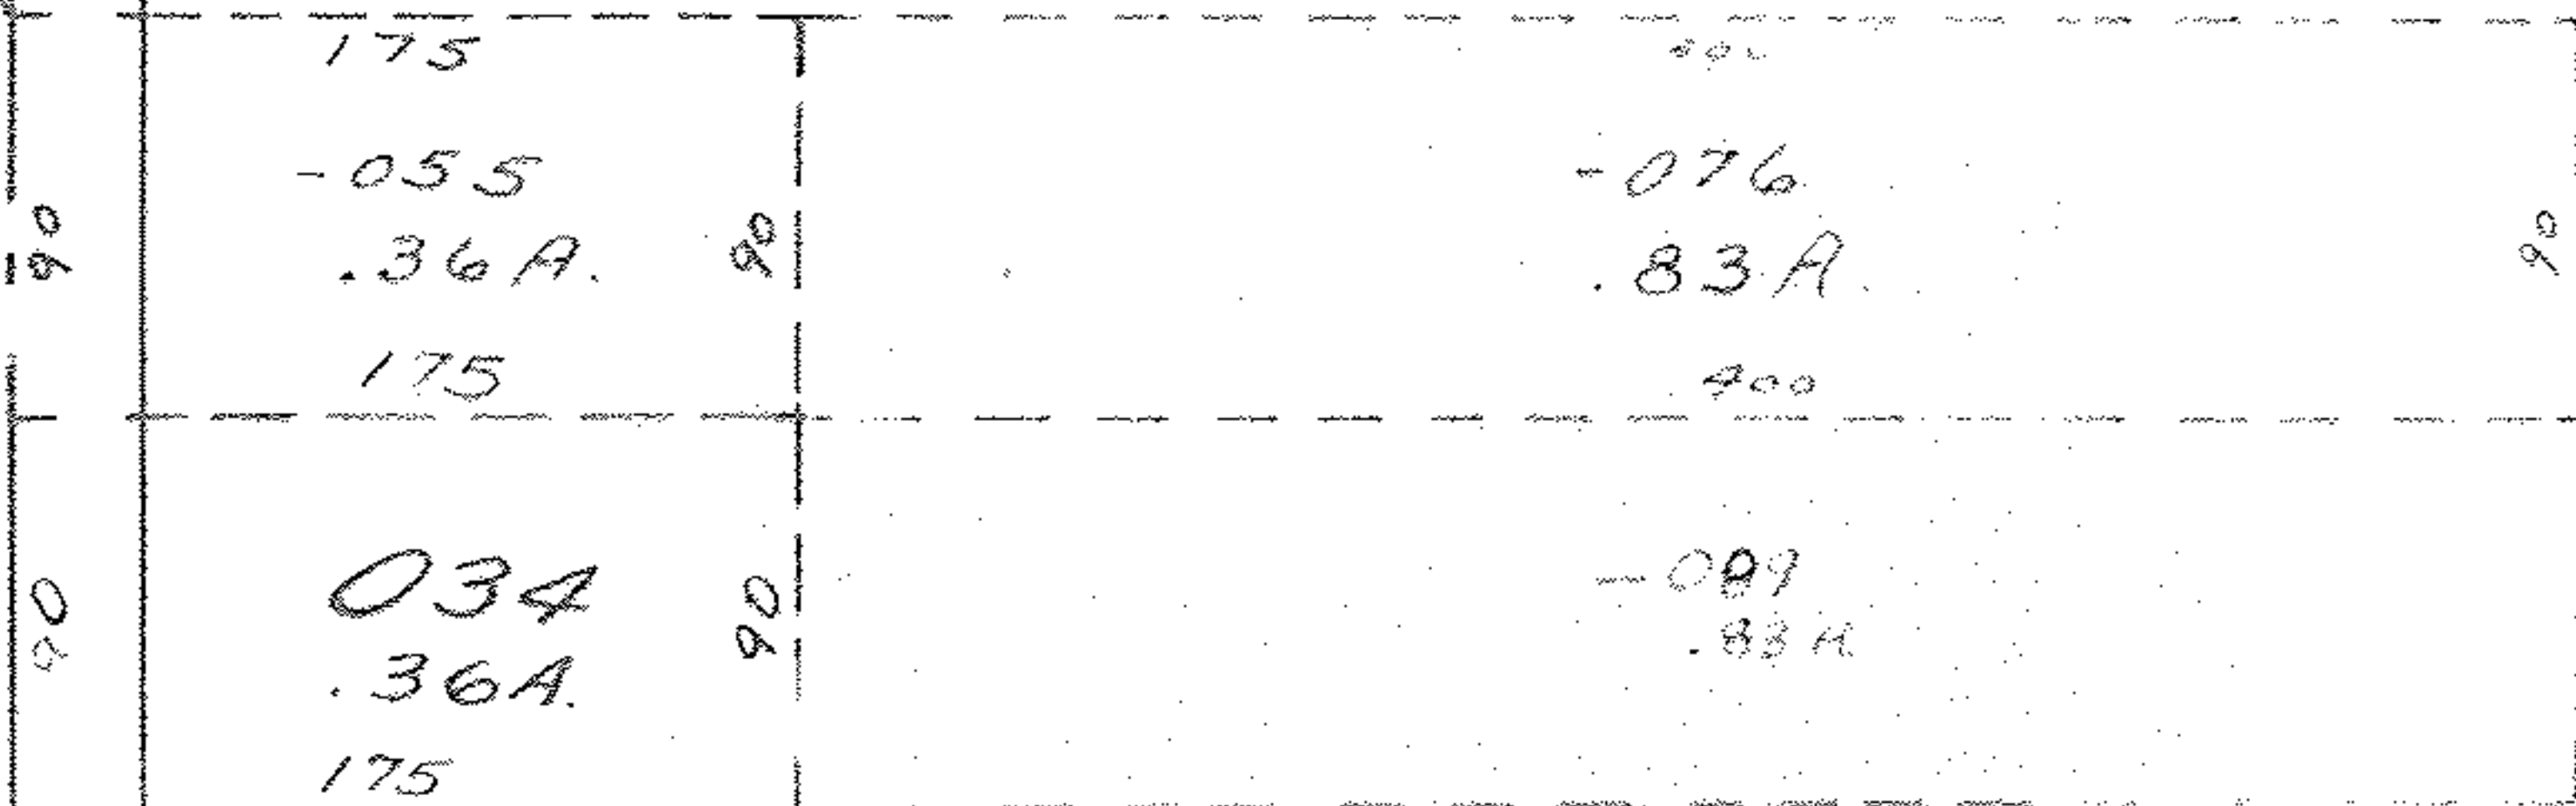

Pt. -104 -106  
Pt. 45.16A. 44.75 A.

Change Pt. number  
on Pg. 4-00-011-F

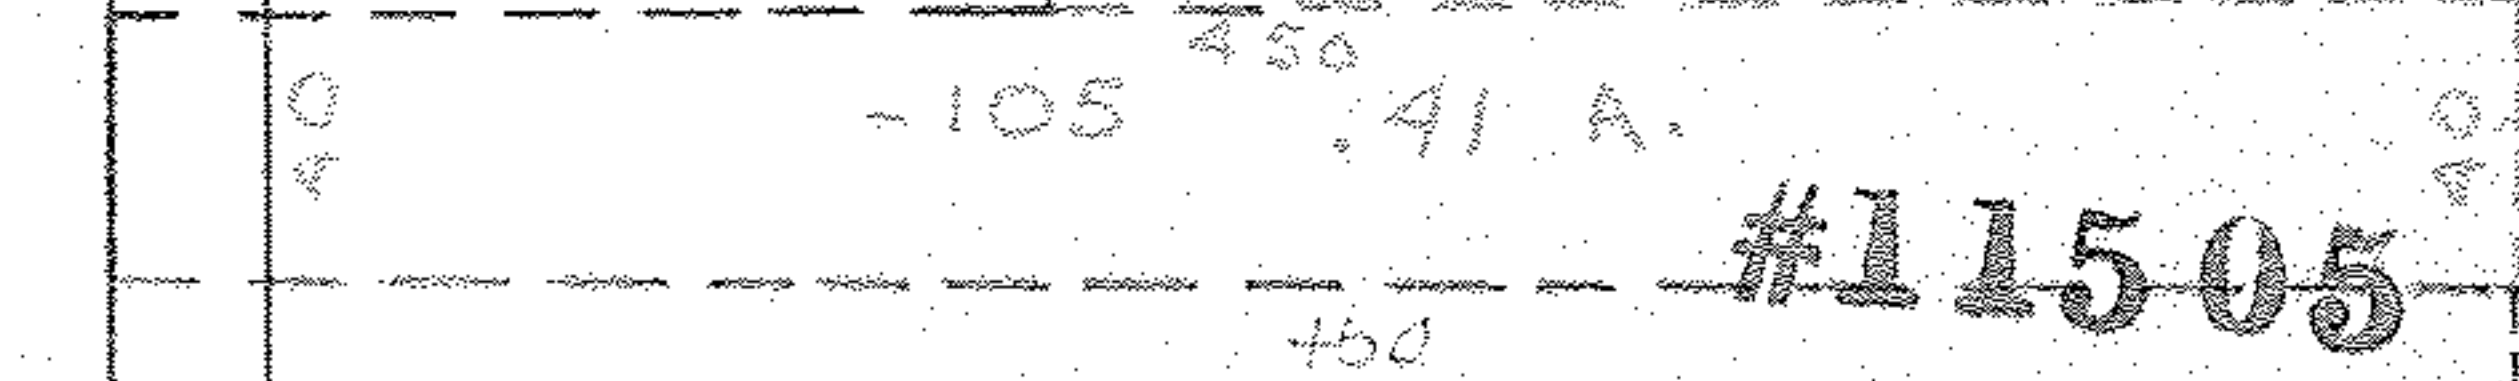

**APPROVED**  
**LORAIN CO.**  
**MAP DEPT.**  
 DATE 3/23/78  
 PAGE 4-00-011-F  
 BY m. Holland  
 VOID AFTER

LONG

26130

-103  
271A

4-7-78

6 079

200

-057  
.42A

450

123.7

264.83

2640